IREDELL COUNTY HEALTH DEPARTMENT

STATESVILLE 704-878-5305 MOORESVILLE 704-664-5281

IMPROVEMENT PERMIT / AUTHORIZATION TO CONSTRUCT / OPERATION PERMIT / EXISTING SYSTEM INSPECTION

PERMIT# 124986 PIN# ~~4639-64-0340.064~~ 4639-54-8587 DATE April 8, 05

OWNER OR CONTRACTOR Hernandez New Construction LLC / MK M Builder PHONE: Business _____ Home _____

ADDRESS 1143 D Executive Circle, Cary / N.C. / 27511

LOCATION Northwinds Subdivision Off of Rt 21 North to Left on Fern Hill Rd. to Northwinds Dr. to Left on Northwinds Dr. to Left on Waterbury Dr. on left before sitting Whispering Creek Ct.

SUBDIVISION Northwinds BLOCK / SECTION _____ LOT 64 Revised LOT AREA 2.215 ac SITE CLASS PS DESIGN FLOW 480 gpd L.T.A.R. .025

Septic Tank: 1000 Gallons; STB 55 Date 12-6-07

Pump Tank: 1000 Gallons; PT 1000 Date 12-1-07

Pump Make: Geotech Model WG222EH Serial No. _____

Nitrification Field: No Fields 1 Square Feet 640/960 Linear Feet 320

No Lines 3 @ 107' ± Trench Width 24" Min 18" Max Trench Bottom Depth 36" ~~maximum~~ Gravel Depth Not

☑ New System ☐ Repair System Type: I, II, III, (IV), V, VI

System Description: LPPFBPS

Repair System Description: LPPPBPS

Maintenance Agreement Required: ☑ Yes ☐ No

☑ House/Mod. Home No. Bedrooms 4

☐ Mobile Home No. Bathrooms ____

☐ Business No. Employees ____

☐ Other _____


☐ Slab ☐ Crawl Space ☑ Basement w/plumbing ☐ Basement wo/plumbing

Water Supply: ☑ Individual ☐ Public ☐ Community


Comments:/Conditions: ~~24~~ 36" Min 96" 30" Lowest Repair Line 1"=50' Lot 64 Revised is a combination of the original Lots 64 & 65 249.04'

Comments:/Conditions: Reviewed Building plans & site plan essentially in compliance with original permit. 157.81'

INITIAL SITE SKETCH

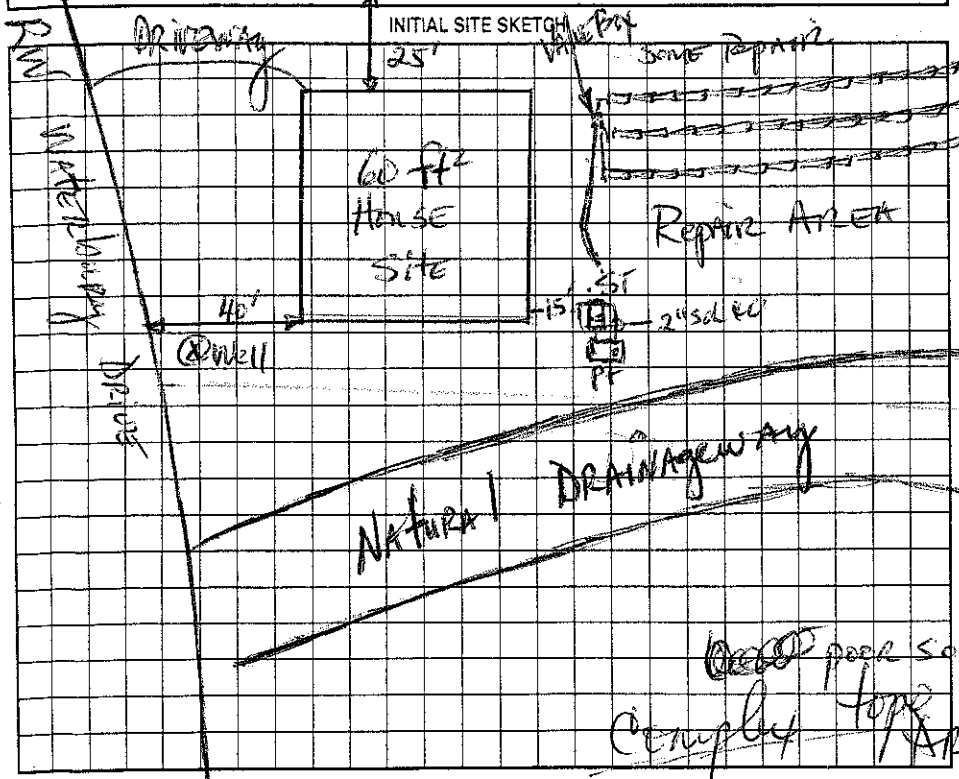

AS BUILT SKETCH

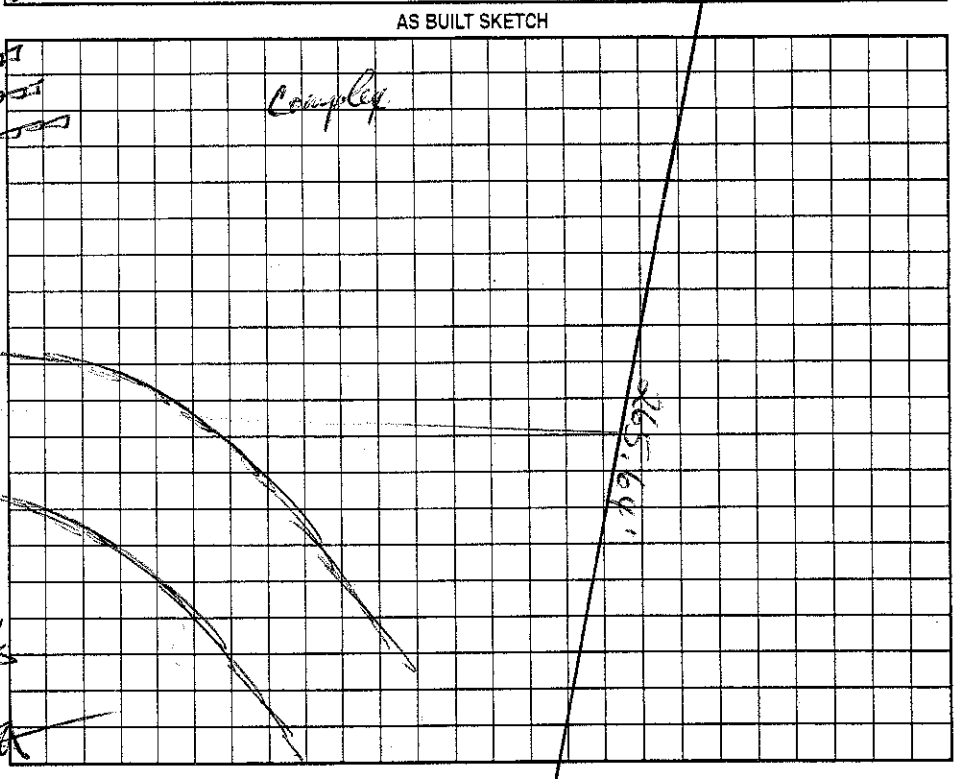

Permit can be suspended or revoked if any false information is supplied toward securing the permit/any unauthorized changes are made to the site/any unauthorized changes are made in the installation of the system. Improvement Permit with plat valid without expiration. Improvement Permit with site plan valid for sixty months. Authorization to Construct is valid for a period equal to that of Improvement Permit – not to exceed sixty months.

Signed: _____ date 5-16-05 Installed by: Paul Howard 704-746-7244

Improvement Permit by: _____ date 4-8-05 Operation Permit by: _____ date 3/16/07

Authorization to Construct by: _____ date 2/21/06 Existing System Inspection by: _____ date _____

HEALTH DEPT COPY: WHITE OWNER COPY (FINAL): YELLOW OWNER COPY (INITIAL): PINK