IREDELL COUNTY HEALTH DEPARTMENT

STATESVILLE 704-878-5305 375.00 Paid MOORESVILLE 704-664-5281

IMPROVEMENT PERMIT / AUTHORIZATION TO CONSTRUCT / OPERATION PERMIT / EXISTING SYSTEM INSPECTION

PERMIT# 112512 PIN# 4639 55 0984 DATE 7/26/03

OWNER OR CONTRACTOR ERA KNIGHT REALTY - JAMES MURRAY PHONE: Business 847-487-5509 Home

ADDRESS 3011 Racoon Cove Island Lake, IL. 60042

LOCATION Perth N TL Fern Hill TR Tennessee Circle on (L) B4 Intersection

SUBDIVISION Northwood BLOCK / SECTION LOT 31 LOT AREA 1.1 + ESMT SITE CLASS. PS DESIGN FLOW 480 L.T.A.R. .3

Septic Tank: 1000 Gallons; STB 825 Date 11/5/05
Pump Tank: 1000 Gallons; PT 302 Date 12/8/05
Pump Make: Goulds Model AE 5IM Serial No.
Nitrification Field: No Fields 1 Square Feet 534/801 Linear Feet 267
No Lines 4 @ 66' Trench Width 2' on 8' OC Max Trench Bottom Depth 3'

[X] New System [ ] Repair System Type: I, II, III, (IV) V, VI
System Description: LP - 16" PPBPS
Repair System Description: LP - 16" PPBPS (ESMT AREA)
Maintenance Agreement Required: [X] Yes [ ] No


[X] House/Mod. Home No. Bedrooms 4
[ ] Mobile Home No. Bathrooms 2.5
[ ] Business No. Employees
[ ] Other
Gravel Depth N/A [ ] Slab [ ] Crawl Space [X] Basement w/plumbing [ ] Basement wo/plumbing

Water Supply: [X] Individual [ ] Public [ ] Community


Comments/Conditions: 3' 9' OC

Comments/Conditions: Line, Tank, Pressure

INITIAL SITE SKETCH Well location on Lot 30 Checked 11/12/05 - GM

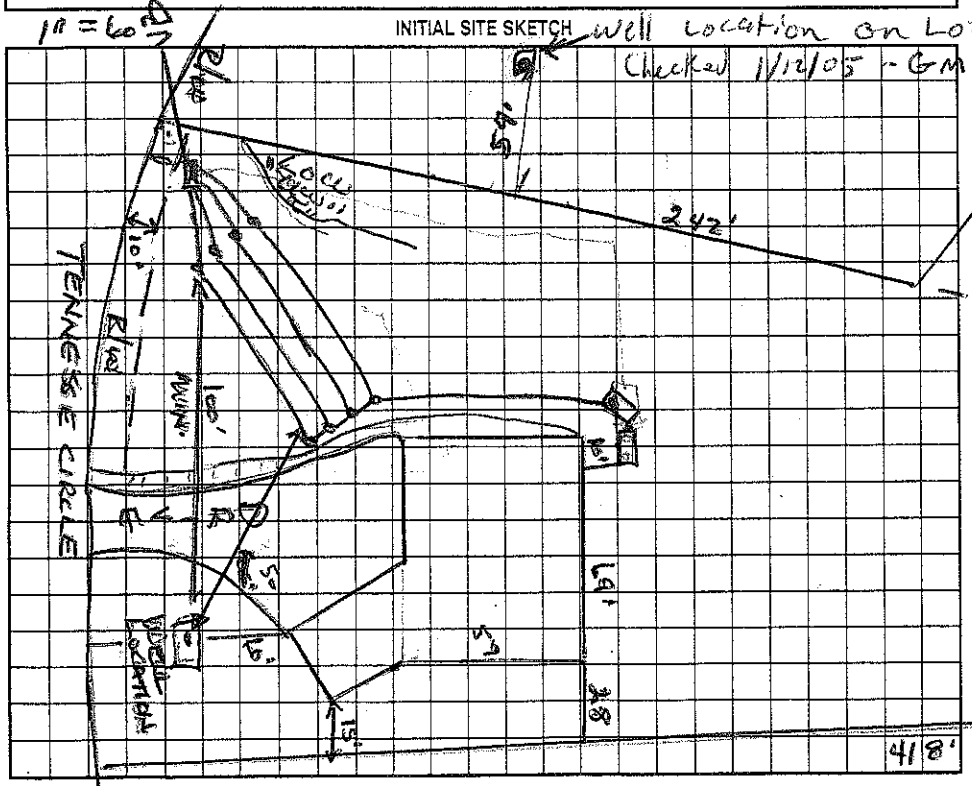

AS BUILT SKETCH

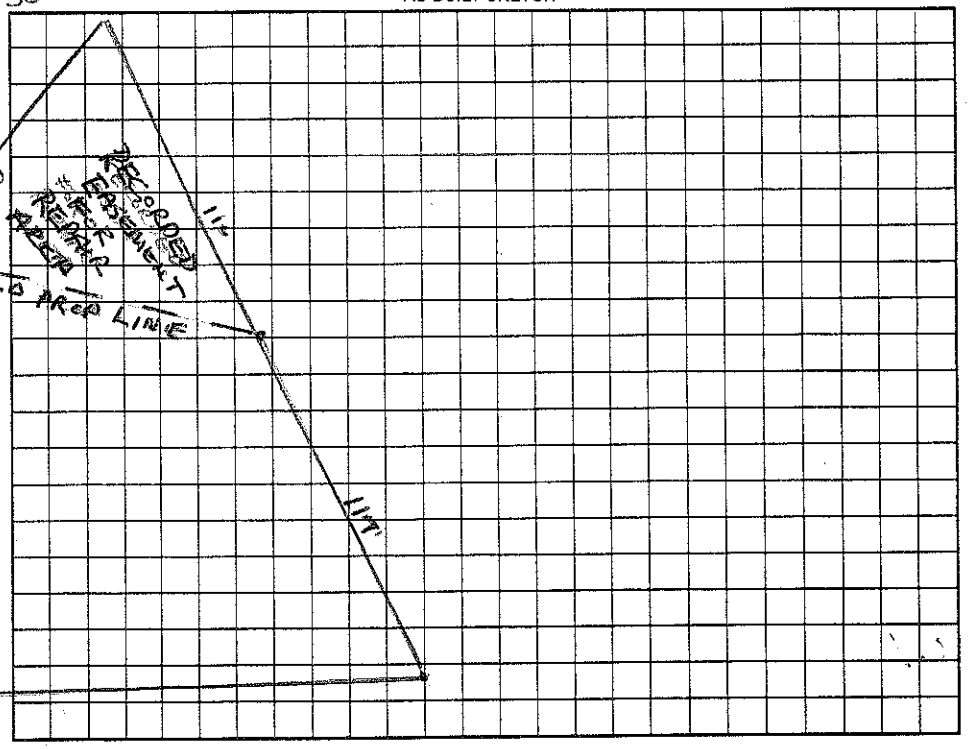

Permit can be suspended or revoked if any false information is supplied toward securing the permit/any unauthorized changes are made to the site/any unauthorized changes are made in the installation of the system. Improvement Permit with plat valid without expiration. Improvement Permit with site plan valid for sixty months. Authorization to Construct is valid for a period equal to that of Improvement Permit – not to exceed sixty months.

Signed: X Wendy Lee date 7/28/03 Installed by: Rowan Septic Tanks

Improvement Permit by: Wesley Sparks RS date 7/26/03 Operation Permit by: Wesley Sparks RS date 6/2/06

Authorization to Construct by: Wesley Sparks RS date 7/26/03 Existing System Inspection by: date

HEALTH DEPT. COPY: WHITE OWNER COPY (FINAL): YELLOW OWNER COPY (INITIAL): PINK