IREDELL COUNTY HEALTH DEPARTMENT

STATESVILLE 704-878-5305 MOORESVILLE 704-664-5231

IMPROVEMENT PERMIT / AUTHORIZATION TO CONSTRUCT / OPERATION PERMIT / EXISTING SYSTEM INSPECTION

PERMIT# 115313 PIN# 4639-55-1845 DATE 2/6/04

OWNER OR CONTRACTOR Randy Kostick PHONE: Business (980) 721-0536 Home

ADDRESS 9887 Fontana Ct Concord NC 28027

LOCATION Park TL Ferry Hill, TR Tennessee C.S. on Lt on corner

SUBDIVISION Northwood BLOCK / SECTION LOT 30 LOT AREA 1.14Ac SITE CLASS. PS DESIGN FLOW 480 L.T.A.R. 0.3

Septic Tank: 1000 Gallons; STB 825 Date 6/15/04
Pump Tank: 1000 Gallons; PT 302 Date 11/20/04
Pump Make: Zoeller Model N140 Serial No.
Nitrification Field: No Fields 1 Square Feet 1200 Linear Feet 400
No Lines 5@80' Trench Width 36" Max Trench Bottom Depth 36" Gravel Depth —

☒ New System ☐ Repair System Type: I, II, III, IV, V, VI
System Description: PM 25% Reduction
Repair System Description: LP Panel Block
Maintenance Agreement Required: ☐ Yes ☐ No

☑ House/Mod. Home No. Bedrooms 4
☐ Mobile Home No. Bathrooms 3½
☐ Business No. Employees
☐ Other


☐ Slab ☒ Crawl Space ☐ Basement w/plumbing ☐ Basement wo/plumbing

Water Supply: ☒ Individual ☐ Public ☐ Community

Comments:/Conditions:

Comments:/Conditions: House May Have Basement W/plumbing - System should not be Affected

INITIAL SITE SKETCH

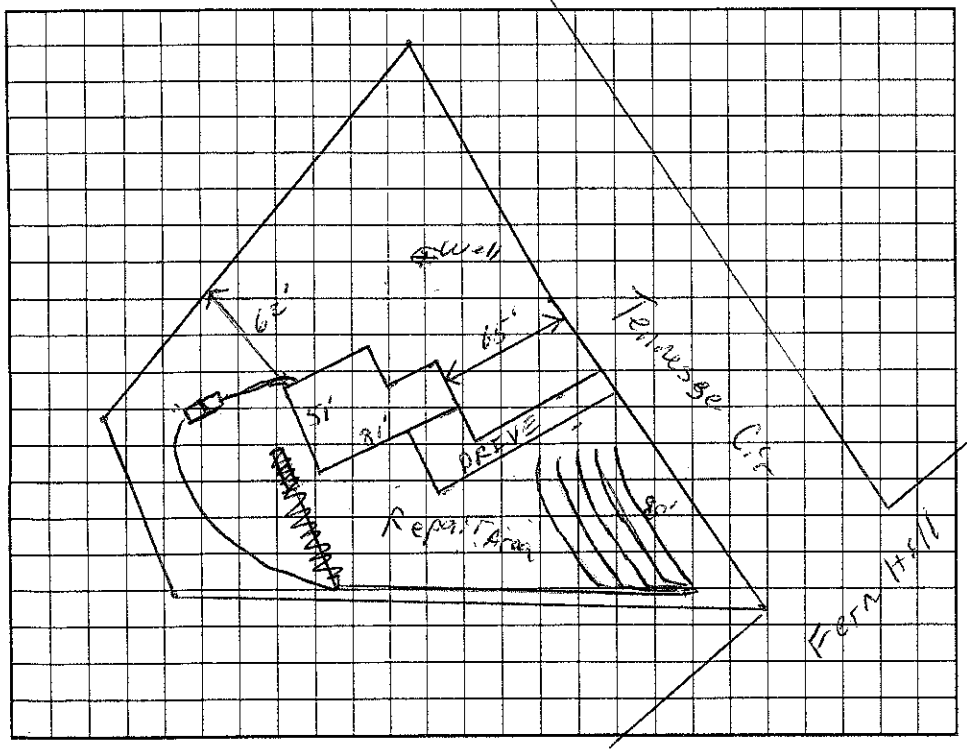

AS BUILT SKETCH

Quick 4's Installed As Drawn

Permit can be suspended or revoked if any false information is supplied toward securing the permit/any unauthorized changes are made to the site/any unauthorized changes are made in the installation of the system. Improvement Permit with plat valid without expiration. Improvement Permit with site plan valid for sixty months. Authorization to Construct is valid for a period equal to that of Improvement Permit -- not to exceed sixty months.

Signed: Chris Kostick date 2-6-04 Installed by: Rowan Septic

Improvement Permit by: RS date 2/6/04 Operation Permit by: Wesley Sanders date 11/12/04

Authorization to Construct by: RS date 2/6/04 Existing System Inspection by: date

HEALTH DEPT. COPY: WHITE OWNER COPY (FINAL): YELLOW OWNER COPY (INITIAL): PINK