IREDELL COUNTY HEALTH DEPARTMENT

STATESVILLE 704-878-5305 MOORESVILLE 704-664-5281

IMPROVEMENT PERMIT / AUTHORIZATION TO CONSTRUCT / OPERATION PERMIT / EXISTING SYSTEM INSPECTION

PERMIT# 073552 PIN# 4439 59 3451

OWNER OR CONTRACTOR Clyde / Susan Booth DATE 5/3/00

ADDRESS 1004 Winterfield Dr. Mooresville, NC. 28115 PHONE: Business _____ Home 664-9693

LOCATION Perth Rd. N TL on Neill Farm Rd. been (L) on Winding Shore Dr.

SUBDIVISION Northwood BLOCK / SECTION 11 LOT 14 LOT AREA ~ 1.60 Ac. SITE CLASS. PS DESIGN FLOW 360 L.T.A.R. .3

Septic Tank: 1000 Gallons; STB 794 Date 2-27-00

Pump Tank: _____ Gallons; PT _____ Date _____

Pump Make: _____ Model _____ Serial No. _____

Nitrification Field: No Fields 1 Square Feet 1200 Linear Feet 400

No Lines 4 Trench Width 36" Max Trench Bottom Depth 36" Gravel Depth 12"

[X] New System [ ] Repair System Type: I II III IV V VI

System Description: Gravity - Conventional

Repair System Description: Same E-Z Lay

Maintenance Agreement Required: [ ] Yes [X] No

[X] House/Mod. Home No. Bedrooms 3

[ ] Mobile Home No. Bathrooms 3

[ ] Business No. Employees ____

[ ] Other _____


[ ] Slab [X] Crawl Space [ ] Basement w/plumbing [ ] Basement wo/plumbing

Water Supply: [X] Individual [ ] Public [ ] Community


Comments:/Conditions:

Comments:/Conditions: Installed E-Z Lay 3 lines at 100' Stepdown 65' down first line

INITIAL SITE SKETCH (1"=60')

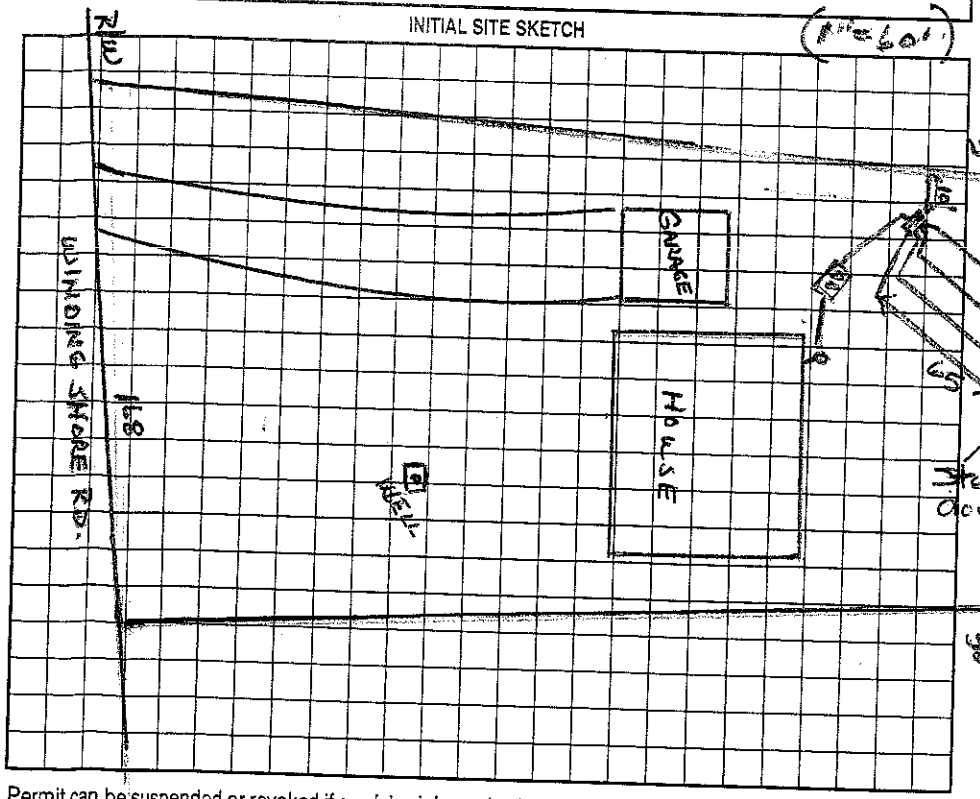

AS BUILT SKETCH

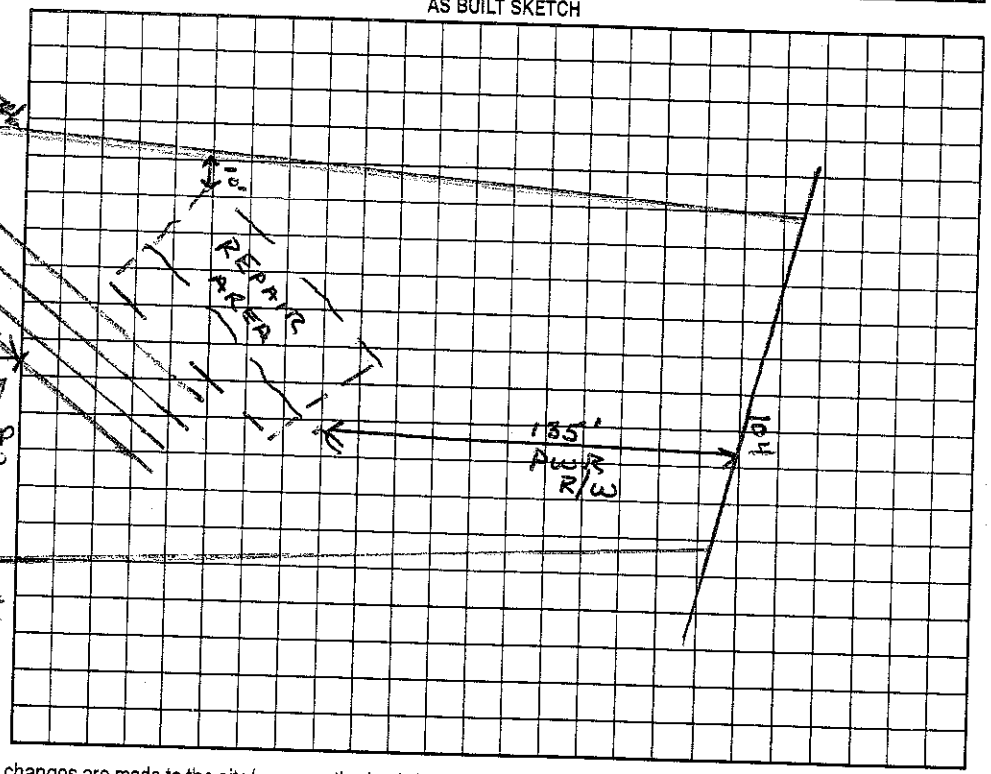

Permit can be suspended or revoked if any false information is supplied toward securing the permit/any unauthorized changes are made to the site/any unauthorized changes are made in the installation of the system. Improvement Permit with plat valid without expiration. Improvement Permit with site plan valid for sixty months. Authorization to Construct is valid for a period equal to that of Improvement Permit – not to exceed sixty months.

Signed: * Rodney A Ellis date _____

Improvement Permit by: Wesley Sparks RS. date 5/3/00

Authorization to Construct by: Wesley Sparks RS. date 5/3/00

Installed by: Lake Norman Grading Backhoe

Operation Permit by: Marvin H Watson R.S. date 5/17/2000

Existing System Inspection by: _____ date _____

* Pd $50.00 Redraw FEE 5/17/2000

HEALTH DEPT. COPY: WHITE OWNER COPY (FINAL): YELLOW OWNER COPY (INITIAL): PINK