200-230

IREDELL COUNTY HEALTH DEPARTMENT

STATESVILLE 704-878-5305 MOORESVILLE 704-664-5281

IMPROVEMENT PERMIT / AUTHORIZATION TO CONSTRUCT / OPERATION PERMIT / EXISTING SYSTEM INSPECTION

PERMIT# 73550 PIN# 4639597303 DATE 8/20/99

OWNER OR CONTRACTOR NORTHWOOD GROUP PHONE: Business Home

ADDRESS 19701-A HWY 73 · CORNELIUS NC 28031

LOCATION NEEL FARM FROM PERTH · ON LT PAST POWERLINE RW

SUBDIVISION NORTHWOOD BLOCK / SECTION 2 LOT 12 LOT AREA 2AC SITE CLASS. PS DESIGN FLOW 360 L.T.A.R. .3

Septic Tank: 1000 Gallons; STB 1007 Date 11/8/99
Pump Tank: Gallons; PT 274 Date
Pump Make: L9945070 Model 1/2 HP Serial No.
Nitrification Field: No Fields 1 Square Feet 900 Linear Feet 300
No Lines 4 @ 75' Trench Width 36" Max Trench Bottom Depth 36" Gravel Depth N/A

☑ New System ☐ Repair System Type: I, II, (III), IV, V, VI
System Description: PUMP 25% REDUCTION
Repair System Description: SAME
Maintenance Agreement Required: ☐ Yes ☐ No


☑ House/Mod. Home No. Bedrooms 3
☐ Mobile Home No. Bathrooms 2
☐ Business No. Employees
☐ Other
☐ Slab ☐ Crawl Space ☐ Basement w/plumbing ☐ Basement wo/plumbing

Water Supply: ☐ Individual ☐ Public ☐ Community

Comments:/Conditions:


1"=60'

INITIAL SITE SKETCH

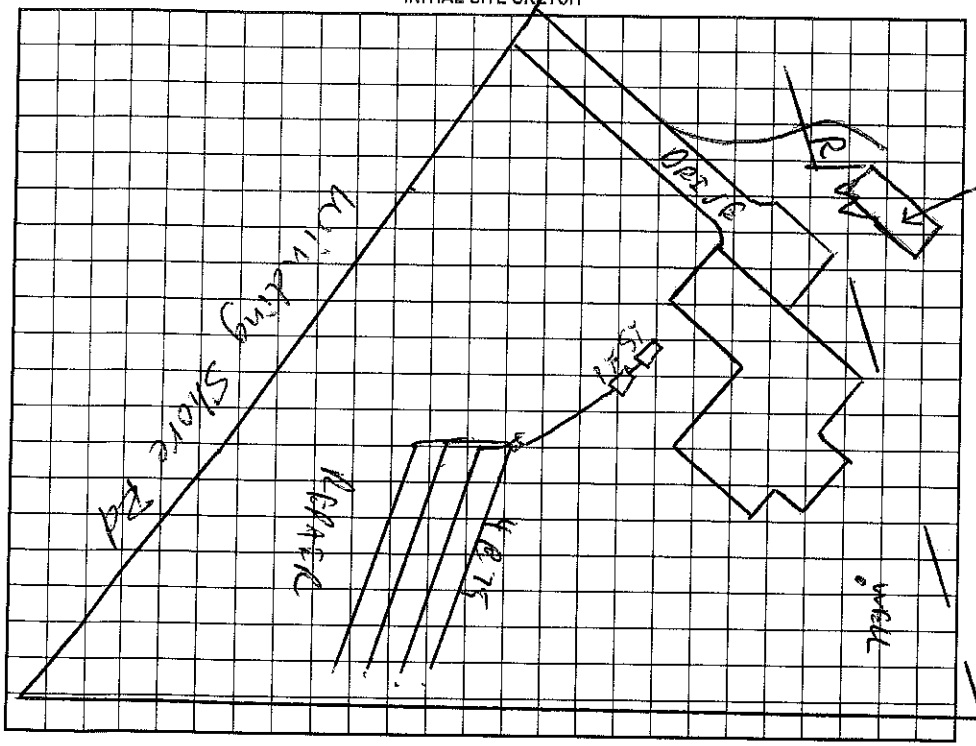

Comments:/Conditions:

AS BUILT SKETCH

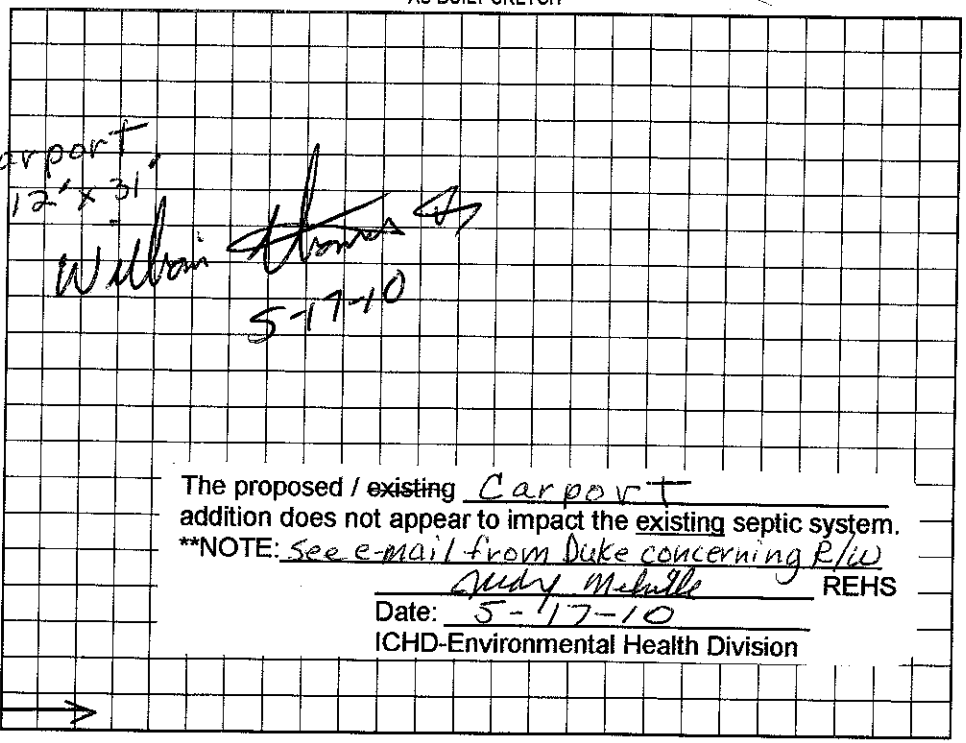

The proposed / ~~existing~~ Carport addition does not appear to impact the existing septic system.
**NOTE: See e-mail from Duke concerning R/W
Judy Melville REHS
Date: 5-17-10
ICHD-Environmental Health Division

Permit can be suspended or revoked if any false information is supplied toward securing the permit/any unauthorized changes are made to the site/any unauthorized changes are made in the installation of the system. Improvement Permit with plat valid without expiration. Improvement Permit with site plan valid for sixty months. Authorization to Construct is valid for a period equal to that of Improvement Permit – not to exceed sixty months.

Signed: [signature] date 8-20-99 Installed by: DONALD LACKEY

Improvement Permit by: C. [signature] RS date 8/20/99 Operation Permit by: C. [signature] RS date 3/14/00

Authorization to Construct by: C. [signature] RS date 8/20/99 Existing System Inspection by: date

HEALTH DEPT. COPY: WHITE OWNER COPY (FINAL): YELLOW OWNER COPY (INITIAL): PINK