570.00 Paid

IREDELL COUNTY HEALTH DEPARTMENT

STATESVILLE 704-878-5305 MOORESVILLE 704-664-5281

IMPROVEMENT PERMIT / AUTHORIZATION TO CONSTRUCT / OPERATION PERMIT / EXISTING SYSTEM INSPECTION

PERMIT# 121477 PIN# 4639-61-5556.018 4639-60-0989 DATE 11/8/05

OWNER OR APPLICANT J.P. North Const. PHONE: Business _____ Home _____

ADDRESS PO Box 480931 Charlotte NC 28269

LOCATION Peith TL Liva, TR Bay Crossing, TL Sleepy Cove on Rt

SUBDIVISION Baycrossing BLOCK / SECTION _____ LOT 78 LOT AREA 0.74c SITE CLASS. PS DESIGN FLOW 450 L.T.A.R. 0.3

Septic Tank: 1500 Gallons; STB 353 Date 9/5/05
Pump Tank: 100 Gallons; PT 27 Date 9/27/05
Pump Make: Gould Model WE0312M Serial No. _____
Nitrification Field: No Fields 1 Square Feet 540 Linear Feet 220
No Lines 6@45' Trench Width 24" Max Trench Bottom Depth 36

☒ New System ☐ Repair ☐ Expansion System Type: I II III ⓘ V VI
System Description: Ep Panel Block
Repair System Description: Same
Maintenance Agreement Required: ☒ Yes ☐ No

☒ House/Mod. Home No. Bedrooms 4
☐ Mobile Home No. Persons ____
☐ Business No. Employees ____
☐ Other _____


Water Supply: ☒ Individual ☐ Public ☐ Community

Gravel Depth — ☐ Gravity ☒ Pressure ☐ Slab ☐ Crawl Space ☐ Basement w/plumbing ☐ Basement wo/plumbing


Comments:/Conditions:

Comments:/Conditions:

INITIAL SITE SKETCH

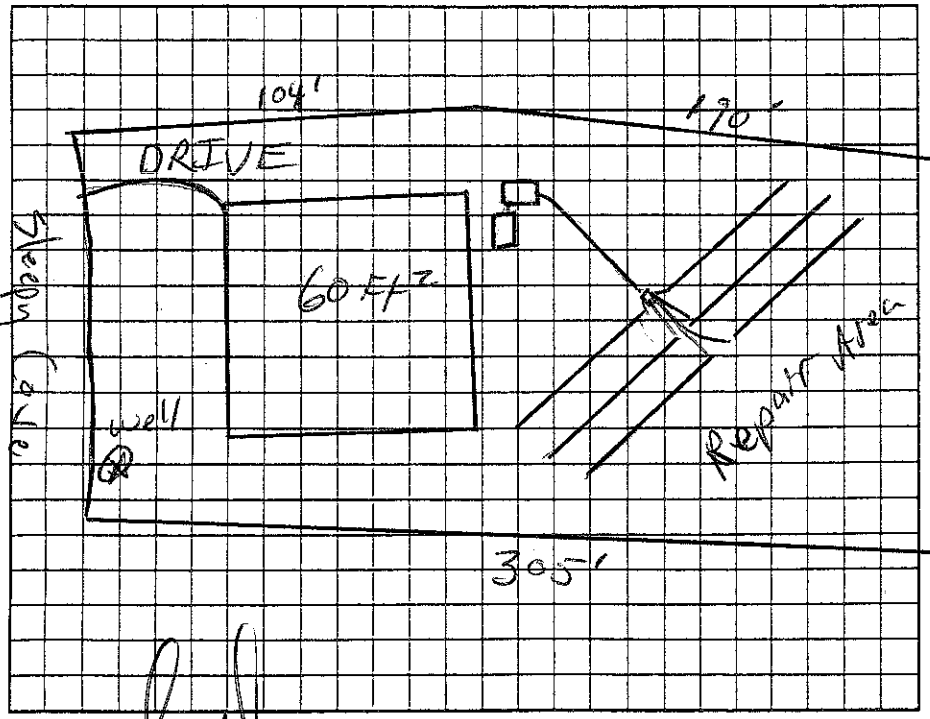

AS BUILT SKETCH

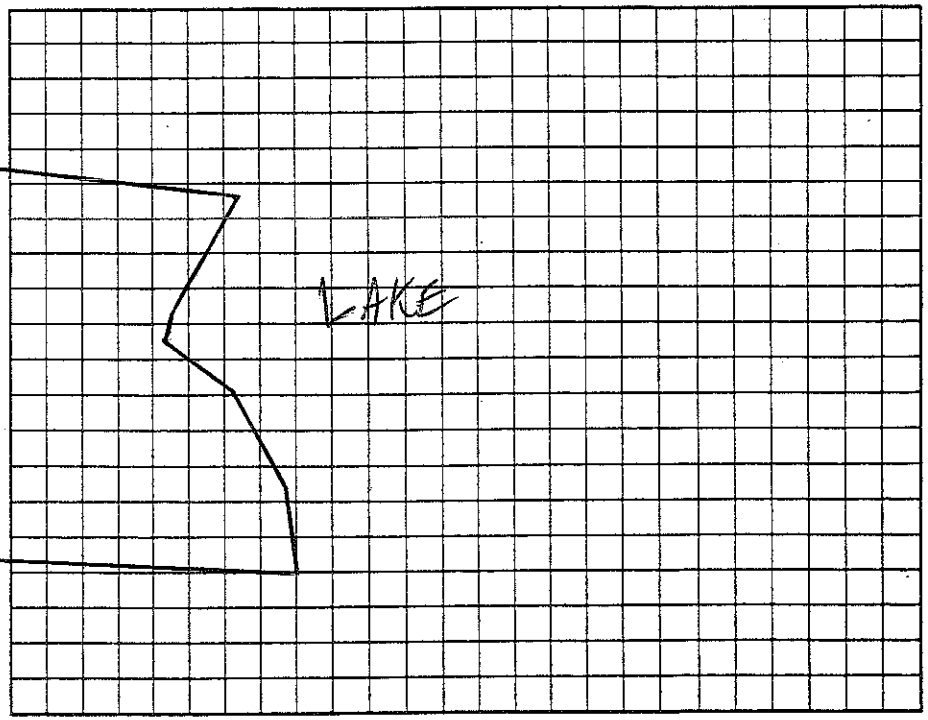

Permit can be suspended or revoked if any false information is supplied toward securing the permit/any unauthorized changes are made to the site/any unauthorized changes are made in the installation of the system. Improvement Permit with plat valid without expiration ☐ Improvement Permit with site plan valid for sixty months ☒ Authorization to Construct is valid for a period equal to that of Improvement Permit – not to exceed sixty months.

Signed: _____ date 12/6/05 Installed by: Jackson Excavating

Improvement Permit by: _____ RS date 11/8/05 Operation Permit by: _____ RS date 12/29/05

Authorization to Construct by: _____ RS date 11/8/05 Existing System Inspection by: _____ date _____

HEALTH DEPT. COPY: WHITE OWNER COPY (FINAL): YELLOW OWNER COPY (INITIAL): PINK