IREDELL COUNTY HEALTH DEPARTMENT

STATESVILLE 704-878-5305 MOORESVILLE 704-664-5281

IMPROVEMENT PERMIT / AUTHORIZATION TO CONSTRUCT / OPERATION PERMIT / EXISTING SYSTEM INSPECTION

PERMIT# 12179 PIN# 4639-61-5556.019 4639-60-2900 DATE 7/8/05

OWNER OR CONTRACTOR Bruce Ingwall PHONE: Business 980 722-9186 Home 704 997-9738

ADDRESS 110 Whimbrel Ln Mooresville NC

LOCATION Perth(M) TL Livia Ln, TR Bay Crossing, TL Sleepy Cove on Rt

SUBDIVISION Bay Crossing BLOCK / SECTION ____ LOT 19 LOT AREA 0.79ac SITE CLASS. PS DESIGN FLOW 480 L.T.A.R. 0.3

Septic Tank: 1500 Gallons; STB 444 Date 1/7/05

Pump Tank: 1000 Gallons; PT 243 Date 10/21/05

Pump Make: Gould Model WE 512 Serial No. ____

Nitrification Field: No Fields 1 Square Feet 810 sq Linear Feet 270

No Lines 5 Trench Width 24" Max Trench Bottom Depth 36" Gravel Depth —

☒ New System ☐ Repair System Type: I, II, III, (IV), V, VI

System Description: LP Panel Block

Repair System Description: Same

Maintenance Agreement Required: ☒ Yes ☐ No

☒ House/Mod. Home No. Bedrooms 4

☐ Mobile Home No. Bathrooms ____

☐ Business No. Employees ____

☐ Other ____

☐ Slab ☒ Crawl Space ☐ Basement w/plumbing ☒ Basement wo/plumbing


Water Supply: ☒ Individual ☐ Public ☐ Community

Comments:/Conditions:


1"=50'

Comments:/Conditions: Tankey, Lines, Pressure, Partial Dosing,

INITIAL SITE SKETCH

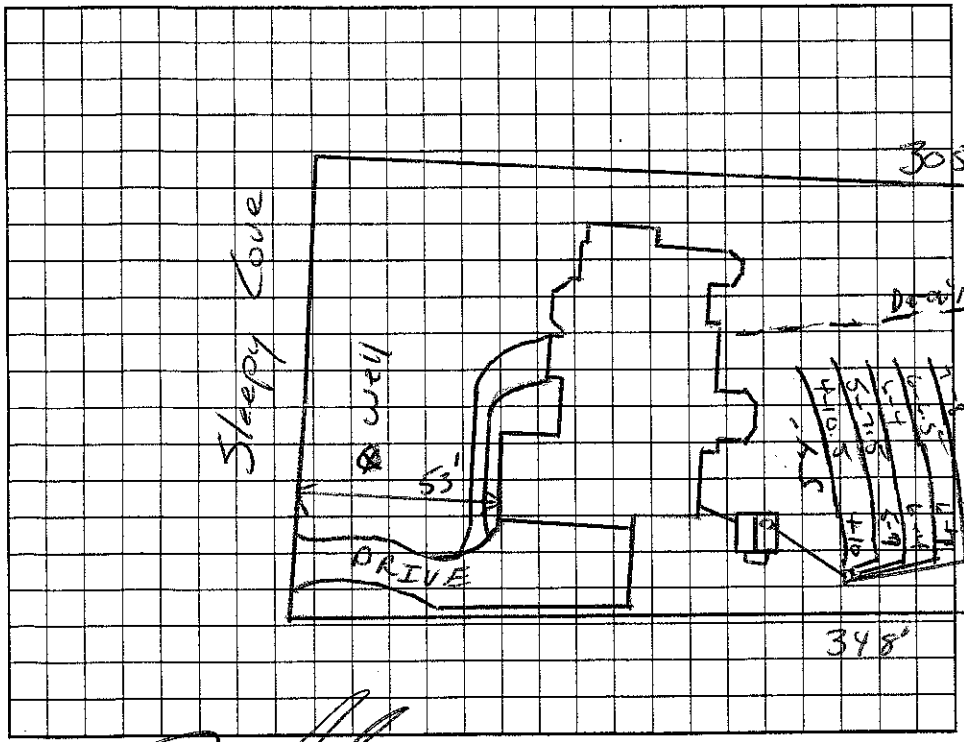

AS BUILT SKETCH

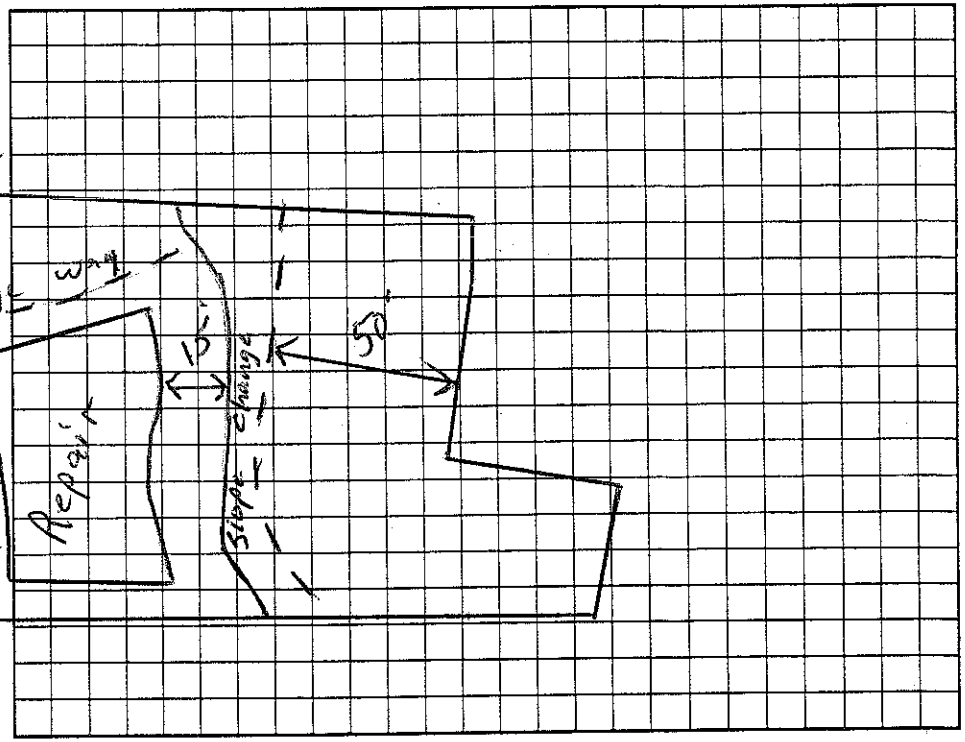

Permit can be suspended or revoked if any false information is supplied toward securing the permit/any unauthorized changes are made to the site/any unauthorized changes are made in the installation of the system. Improvement Permit with plat valid without expiration. Improvement Permit with site plan valid for sixty months. Authorization to Construct is valid for a period equal to that of Improvement Permit – not to exceed sixty months.

Signed: _____ date 7-11-05 Installed by: _____

Improvement Permit by: RS date 7/8/05 Operation Permit by: RS date 6/29/06

Authorization to Construct by: RS date 7/8/05 Existing System Inspection by: _____ date _____

HEALTH DEPT. COPY: WHITE OWNER COPY (FINAL): YELLOW OWNER COPY (INITIAL): PINK