IREDELL COUNTY HEALTH DEPARTMENT

STATESVILLE 704-878-5305 MOORESVILLE 704-664-5281

IMPROVEMENT PERMIT / AUTHORIZATION TO CONSTRUCT / OPERATION PERMIT / EXISTING SYSTEM INSPECTION

PERMIT# 121483 PIN# 4639615556.21 4639-60-4758 DATE 11/5/04

OWNER OR CONTRACTOR Hecht Properties/Marquee Homes PHONE: Business 704 483-3651 Home

ADDRESS 885 North Highway 16 Denver NC 28037

LOCATION Perth Rd South TR Wing Ln - TL Bay Crossing - TL Sleepy Cove - Lot on RT - Septic Across From Lot 108

SUBDIVISION Bay Crossing BLOCK / SECTION 1 LOT 21 LOT AREA .95 AC SITE CLASS PS DESIGN FLOW 480gpd L.T.A.R. .25 10/FP

Septic Tank: 1000 Gallons; STB 1012 Date 5/28/05

Pump Tank: 1000 Gallons; PT 17 Date 5/27/05

Pump Make: Goulds Model WS0.712HT Serial No. F056397G

Nitrification Field: No Fields 1 Square Feet 640 Linear Feet 320

No Lines 4@80' Trench Width 24" Max Trench Bottom Depth 36" Gravel Depth N/A

[X] New System [ ] Repair System Type: I, II, III, (IV), V, VI

System Description: LPP PANEL OFFSITE

Repair System Description: SAME OFFSITE

Maintenance Agreement Required: [X] Yes [ ] No

[X] House/Mod. Home [ ] Mobile Home [ ] Business [ ] Other

No. Bedrooms 4 No. Bathrooms 4 No. Employees


[ ] Slab [X] Crawl Space [ ] Basement w/plumbing [ ] Basement wo/plumbing

Water Supply: [X] Individual [ ] Public [ ] Community


Comments:/Conditions: Tanks & lines checked by GM 7/27/05 Pressure, elect. & alarm checked by GM 8/8/05

Comments:/Conditions: 72 Panels 3/16" holes Maint. agreement attached 8/18/05

INITIAL SITE SKETCH 1"=60'

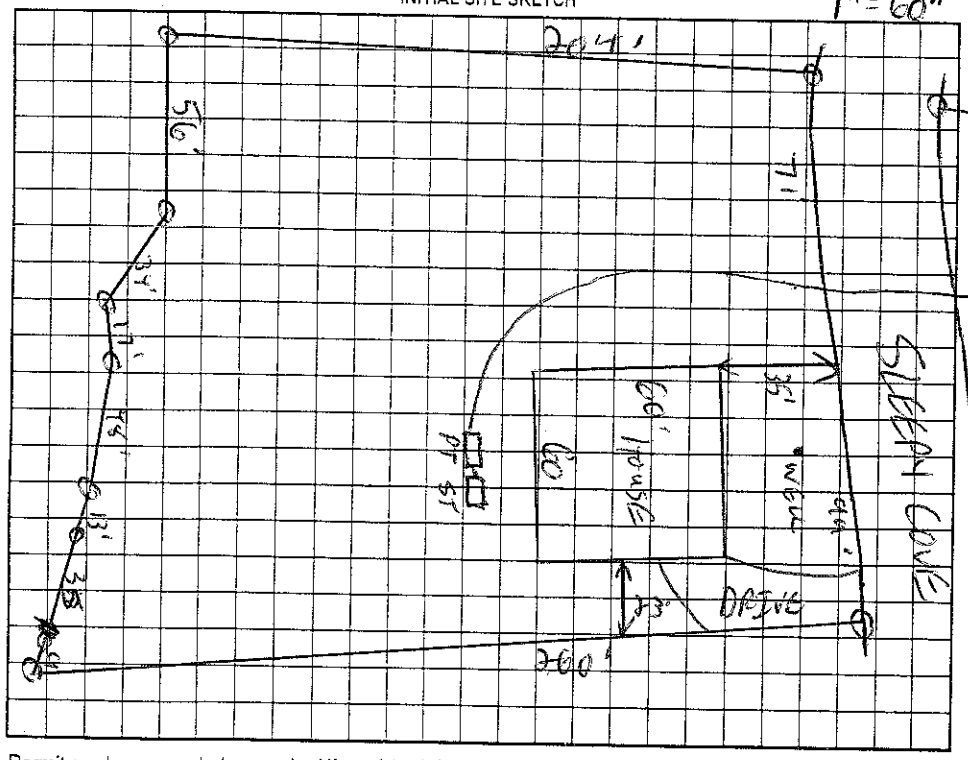

AS BUILT SKETCH

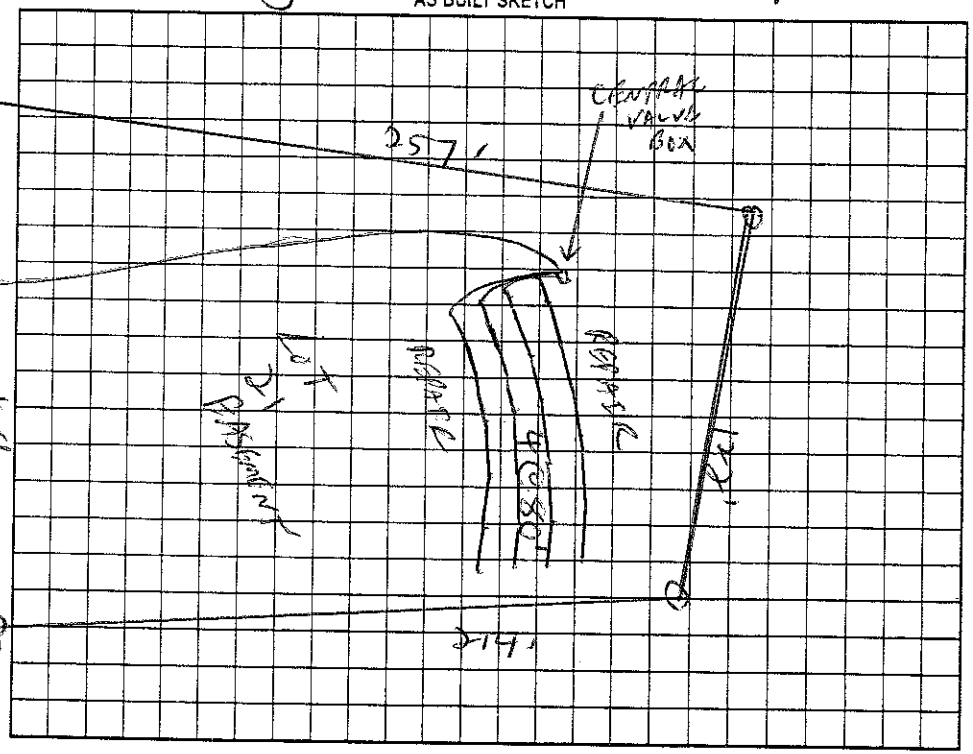

Permit can be suspended or revoked if any false information is supplied toward securing the permit/any unauthorized changes are made to the site/any unauthorized changes are made in the installation of the system. Improvement Permit with plat valid without expiration. Improvement Permit with site plan valid for sixty months. Authorization to Construct is valid for a period equal to that of Improvement Permit – not to exceed sixty months.

Signed: [signature] date 11-22-04

Improvement Permit by: [signature] RS date 11/5/04

Authorization to Construct by: [signature] RS date 1/21/05

Installed by: Piedmont Backhoe

Operation Permit by: [signature] RS date 8/8/05

Existing System Inspection by: date

HEALTH DEPT. COPY: WHITE OWNER COPY (FINAL): YELLOW OWNER COPY (INITIAL): PINK