IREDELL COUNTY HEALTH DEPARTMENT

STATESVILLE 704-878-5305 MOORESVILLE 704-664-5281

IMPROVEMENT PERMIT / AUTHORIZATION TO CONSTRUCT / OPERATION PERMIT / EXISTING SYSTEM INSPECTION

PERMIT# 121476 PIN# 4639 61 5556.77 0120

OWNER OR CONTRACTOR Hecht Properties/Mac Builders PHONE: Business (704) 483-3651 Home

ADDRESS 385 North Highway 16 Denver NC 28037 DATE 11/4/04

LOCATION Perth Rd South TR Live Ln TR 84 CROSSING-71 SUBDIV COVE CT RT

SUBDIVISION Bay Crossing BLOCK / SECTION 1 LOT 17 LOT AREA 1.25AC SITE CLASS PS DESIGN FLOW 480gpd L.T.A.R. 1,360 FT²

Septic Tank 1500 1000 Gallons: STB 444 Date 5-7-07

Pump Tank: 1000 Gallons: PT 283 Date 4-13-07

Pump Make: Gould Model WE0512HH4 Serial No.

Nitrification Field: No Fields 1 Square Feet 1200 Linear Feet 400

No Lines 5@50' Trench Width 36" Max Trench Bottom Depth 36" Gravel Depth N/A

☒ New System ☐ Repair System Type: I, II, III, IV, V, VI

System Description: Pump 2500 GPD RECIRCULATION

Repair System Description: SAME

Maintenance Agreement Required: ☐ Yes ☒ No

☐ Slab ☒ Crawl Space ☒ Basement w/plumbing ☐ Basement wo/plumbing

☒ House/Mod. Home ☐ Mobile Home ☐ Business ☐ Other


No. Bedrooms 4 No. Bathrooms 4 No. Employees

Water Supply: ☒ Individual ☐ Public ☐ Community


Comments:/Conditions: Note: Must stay at least 25ft from basement wall with Drainfield House foot print slightly larger than original, shoulders okay

Comments:/Conditions: 8/25/06 Reviewed plans, essentially in compliance with LP 8/20/07 Checked tanks & lines & pressured 2ft. Installed Quick 4 essentially as Drawn. 10/10/07 Electrical checked A.C.

INITIAL SITE SKETCH

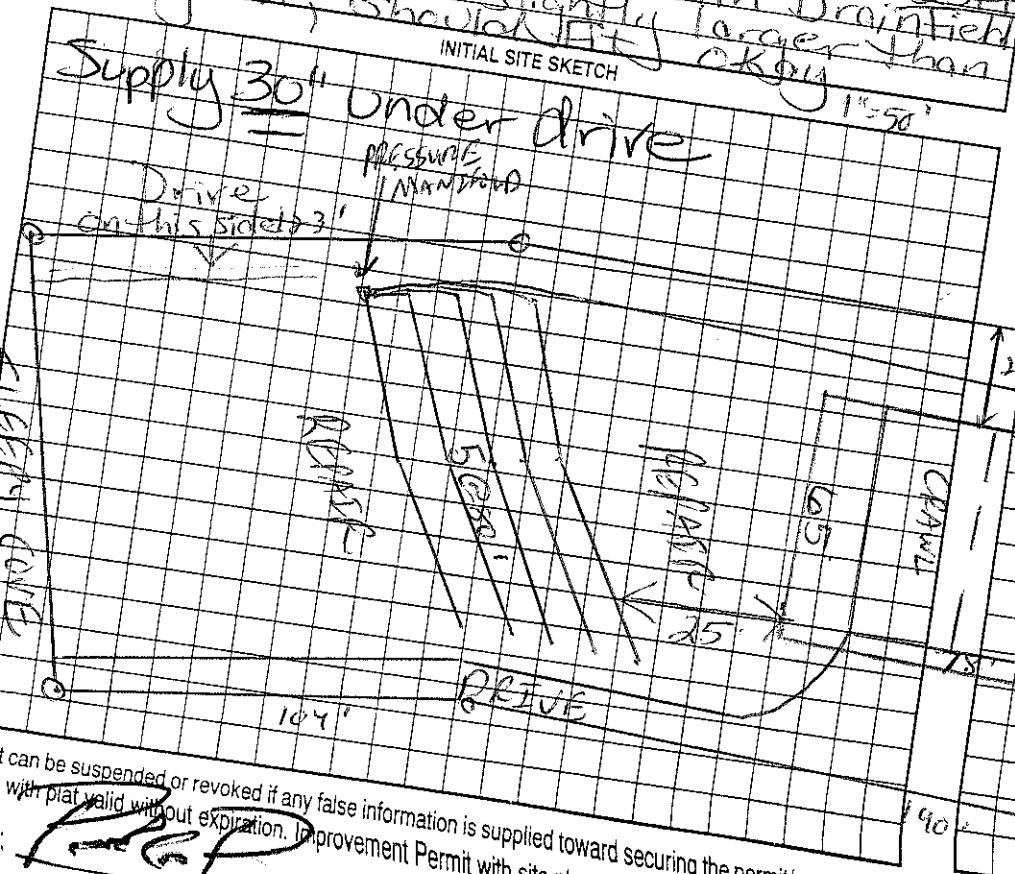

AS BUILT SKETCH

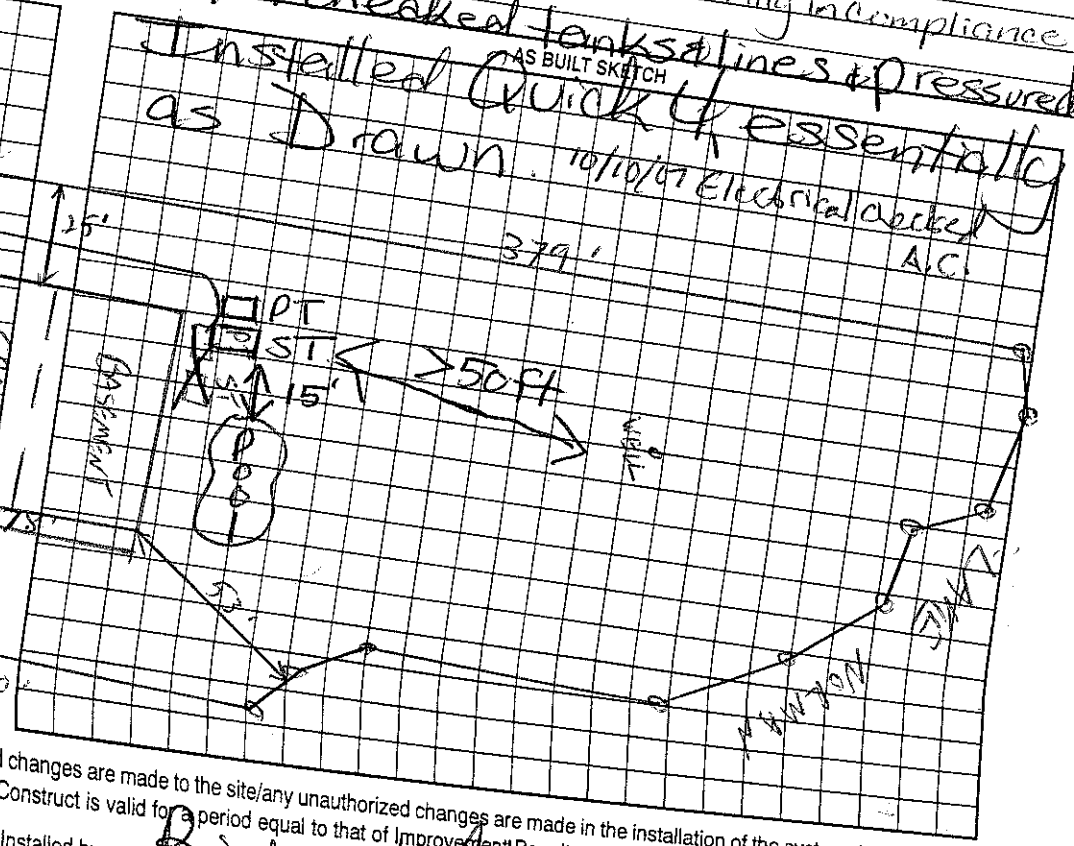

t can be suspended or revoked if any false information is supplied toward securing the permit/any unauthorized changes are made to the site/any unauthorized changes are made in the installation of the system. Improvement with plat valid without expiration. Improvement Permit with site plan valid for sixty months. Authorization to Construct is valid for a period equal to that of Improvement Permit – not to exceed sixty months.

ement Permit by: _____ date 11-22-04 Installed by: Richard Aber Nathy

zation to Construct by: _____ date 11/4/04 Operation Permit by: _____ date 8/25/06

Existing System Inspection by: _____ date 10/10/07

HEALTH DEPT. COPY: WHITE OWNER COPY (FINAL): YELLOW OWNER COPY (INITIAL): PINK