IMPROVEMENT PERMIT / AUTHORIZATION TO CONSTRUCT / OPERATION PERMIT / EXISTING SYSTEM INSPECTION

PIN# 4634-61-5556.000 DATE 2/16/05

CONTRACTOR Kimberly James Homes PHONE: Business 704-235-1440 Home

ADDRESS 7801 Davidson NC 28036

LOCATION Lot 1 TL Liva Ln, TR Bay Crossing, TL Bayshore, on Rt.

SUBDIVISION Bay Crossing BLOCK / SECTION 1 LOT 93 LOT AREA 1.03 ac SITE CLASS PS DESIGN FLOW 480 L.T.A.R. 0.5

Septic Tank 1000 Gallons: ST 317 Date 10/29/05

Pump Tank 1000 Gallons: PT Date

Pump Make Model 1 Serial No.

Distribution Unit: No Pump Square Feet 1200 Linear Feet 400

Trench Width 36" Max Trench Bottom Depth 36" Gravel Depth —

☒ New System ☐ Repair System Type: I, II, III, IV, V

System Description: Gravity 25% Reduct

Repair System Description: Pump 25% Reduct

Maintenance Agreement Required: ☐ Yes ☒ No

☒ House/Mod. Home No. Bedrooms 4

☐ Mobile Home No. Bathrooms

☐ Business No. Employees


☐ Other

Water Supply: ☒ Individual ☐ Public ☐ Community


☐ Slab ☒ Crawl Space ☐ Basement w/plumbing ☐ Basement w/o plumbing

Comments/Conditions:

INITIAL SITE SKETCH

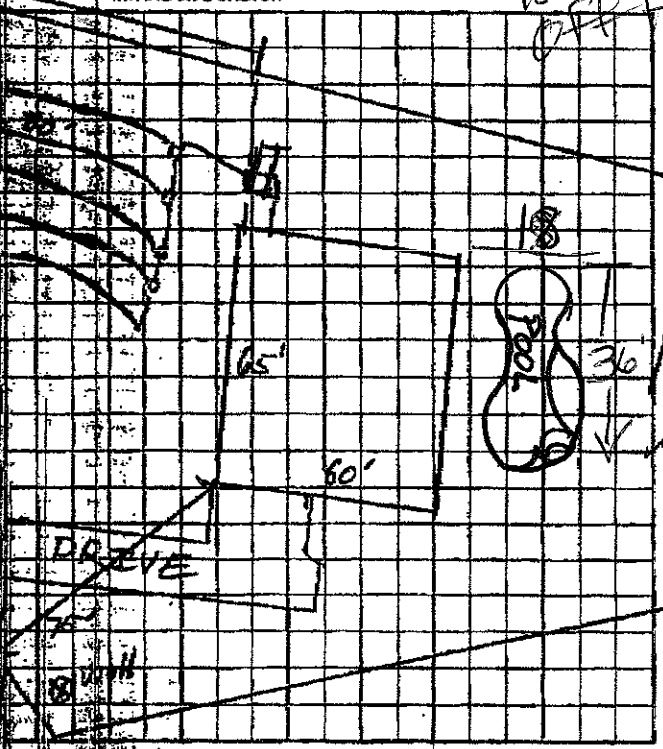

AS BUILT SKETCH

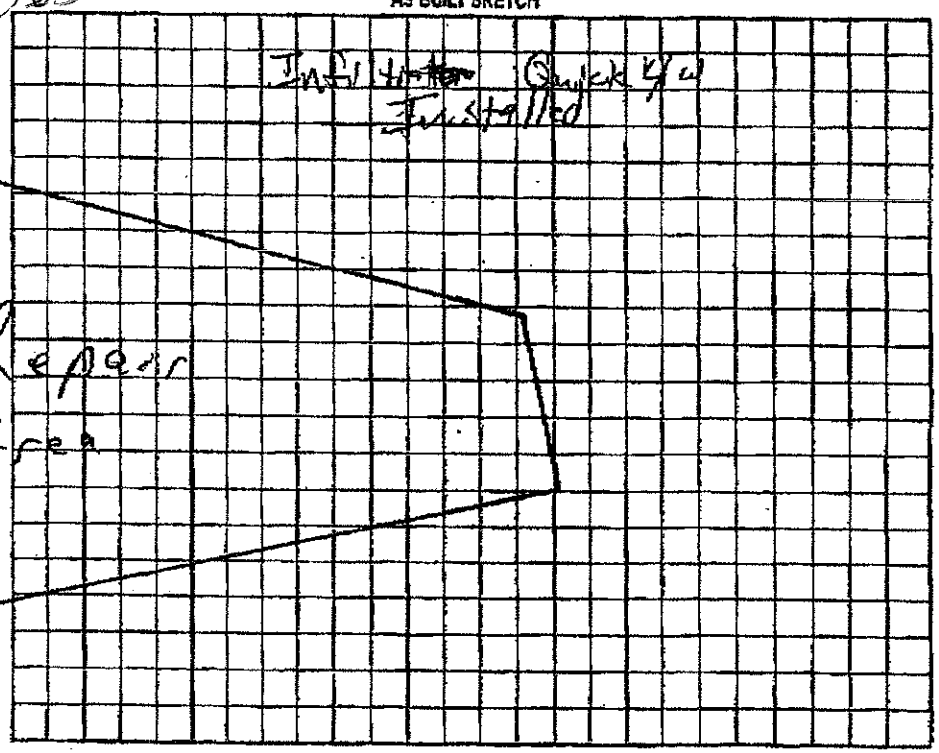

Revoked if any false information is supplied toward securing the permit/any unauthorized changes are made to the site/any unauthorized changes are made in the installation of the system. Improvement Permit/Evaluation. Improvement Permit with site plan valid for sixty months. Authorization to Construct is valid for a period equal to that of Improvement Permit – not to exceed sixty months.

RS date 3/7/05 Installed by: Rose Man

RS date 2/16/05 Operation Permit by: RS date 12/13/05

RS date 2/16/05 Existing System Inspection by: date

2/2007 11:34 FAX 704 892 3438 PRUDENTIAL CAROLINAS RLT 002/002
/15/2007 04:06 704-5649737 PAGE 01/01