IREDELL COUNTY HEALTH DEPARTMENT

STATESVILLE 704-878-5305 MOORESVILLE 704-[illegible]31

IMPROVEMENT PERMIT / AUTHORIZATION TO CONSTRUCT / OPERATION PERMIT / EXISTING SYSTEM INSPECTION

PERMIT# 121622 PIN# 4639 61 5956.091 4639-61-4766 DATE 11/9/04

OWNER OR CONTRACTOR HECHT PROPERTIES / Tegland-Brown Const. PHONE: Business 453-3651 Home

ADDRESS 885 N. HWY 16 DENVER N.C. 28037

LOCATION PERTH (S) - TR LIVA LN - TR BAY CROSSING - RIGHT TL BAY SHORE - ON RT

SUBDIVISION BAY CROSSING BLOCK / SECTION LOT 91 LOT AREA 1.724 ± SITE CLASS. PS DESIGN FLOW 480GPD L.T.A.R. 1.3600/Ac

Septic Tank: 1500 Gallons; STB 338 Date 7/11/05

Pump Tank: 1000 Gallons; PT 253 Date 7/31/05

Pump Make: _____ Model _____ Serial No. _____

Nitrification Field: No Fields 1 Square Feet 540 Linear Feet 270

No Lines 3@90' Trench Width 24" Max Trench Bottom Depth 36" Gravel Depth N/A

☑ New System ☐ Repair System Type: I, II, III, IV, V, VI

System Description: LP PANEL

Repair System Description: SAME

Maintenance Agreement Required: ☑ Yes ☐ No

☑ House/Mod. Home No. Bedrooms 4

☐ Mobile Home No. Bathrooms 4

☐ Business No. Employees _____

☐ Other _____

☐ Slab ☑ Crawl Space ☐ Basement w/plumbing ☐ Basement wo/plumbing


Water Supply: ☑ Individual ☐ Public ☐ Community

Comments:/Conditions:


Comments:/Conditions:

56 Panels 5/32" holes

INITIAL SITE SKETCH 1"=50'

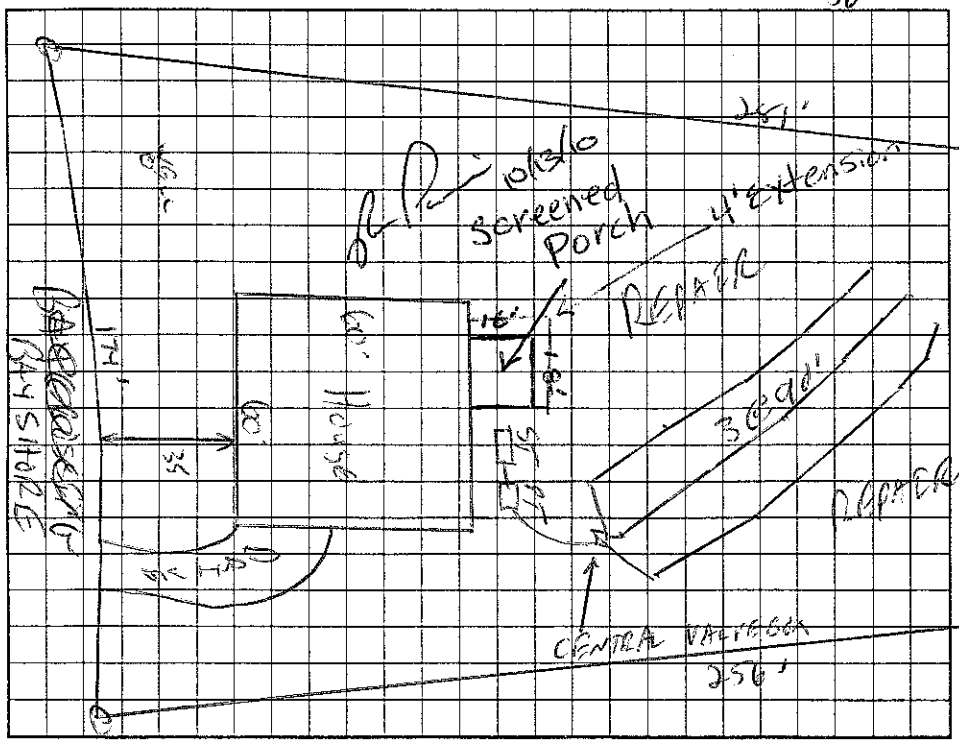

AS BUILT SKETCH

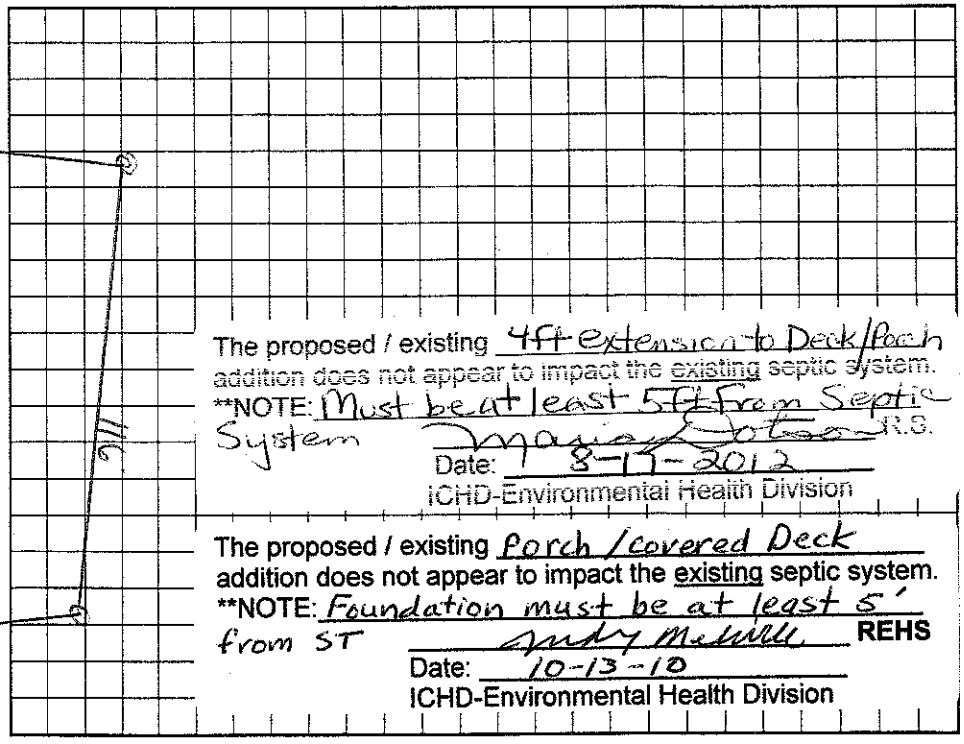

The proposed / existing 4ft extension to Deck/Porch addition does not appear to impact the existing septic system.

**NOTE: Must be at least 5ft from Septic System

Date: 8-17-2012

ICHD-Environmental Health Division R.S.

The proposed / existing Porch / covered Deck addition does not appear to impact the existing septic system.

**NOTE: Foundation must be at least 5' from ST

Date: 10-13-10

ICHD-Environmental Health Division REHS

Permit can be suspended or revoked if any false information is supplied toward securing the permit/any unauthorized changes are made to the site/any unauthorized changes are made in the installation of the system. Improvement Permit with plan valid without expiration. Improvement Permit with site plan valid for sixty months. Authorization to Construct is valid for a period equal to that of Improvement Permit – not to exceed sixty months.

Signed: _____ date 11-22-04

Improvement Permit by: _____ date 11/9/04

Authorization to Construct by: _____ date 12/29/04

Installed by: Abernathy

Operation Permit by: _____ RS date 10/5/05

Existing System Inspection by: _____ date _____

HEALTH DEPT. COPY: WHITE OWNER COPY (FINAL): YELLOW OWNER COPY (INITIAL): PINK