IREDELL COUNTY HEALTH DEPARTMENT

STATESVILLE 704-878-5305 MOORESVILLE 704-664-5281

IMPROVEMENT PERMIT / AUTHORIZATION TO CONSTRUCT / OPERATION PERMIT / EXISTING SYSTEM INSPECTION

PERMIT# 121599 PIN# 4639615556.027 Powder 4639615321 DATE 11/8/04

OWNER OR CONTRACTOR Hecht Properties / Triangle Home PHONE Business (704) 483-3651 Home

ADDRESS 885 North Highway 16 Denver, NC 28037

LOCATION Perth Rd south TR Liva Ln - TL BAY CROSSING - TL BAY SHORE - LOT ON LT - SEPTIC ON RT

SUBDIVISION Bay Crossing BLOCK / SECTION 1 LOT 27 LOT AREA 1.554 C SITE CLASS PS DESIGN FLOW 480 gpd T.A.R.

Septic Tank: 1500 ~~1000~~ Gallons; STB 338 Date 11/29/04
Pump Tank: 1000 Gallons; PT 243 Date 9/19/05
Pump Make: Goulds Model WE0-512 Serial No.
Nitrification Field: No Fields 1 Square Feet 1200 Linear Feet 400
No Lines 4@100' Trench Width 36" Max Trench Bottom Depth 36" Gravel Depth


☒ New System ☐ Repair System Type: I, II, III, IV, V, VI
System Description: PUMP 25% REDUCTION OFFSITE
Repair System Description: LP PANEL OFFSITE
Maintenance Agreement Required: ☐ Yes ☒ No

☒ House/Mod. Home ☐ Mobile Home ☐ Business ☐ Other
No. Bedrooms 4 No. Bathrooms 4 No. Employees
☐ Slab ☐ Crawl Space ☒ Basement w/plumbing ☐ Basement wo/plumbing

Water Supply: ☒ Individual ☐ Public ☐ Community


Comments/Conditions: SEE MASTER PLAT FOR PUMP SUPPLY LINE LOCATION. Reviewed Building plans & Floor plans, essentially in Compliance with I.P.

INITIAL SITE SKETCH

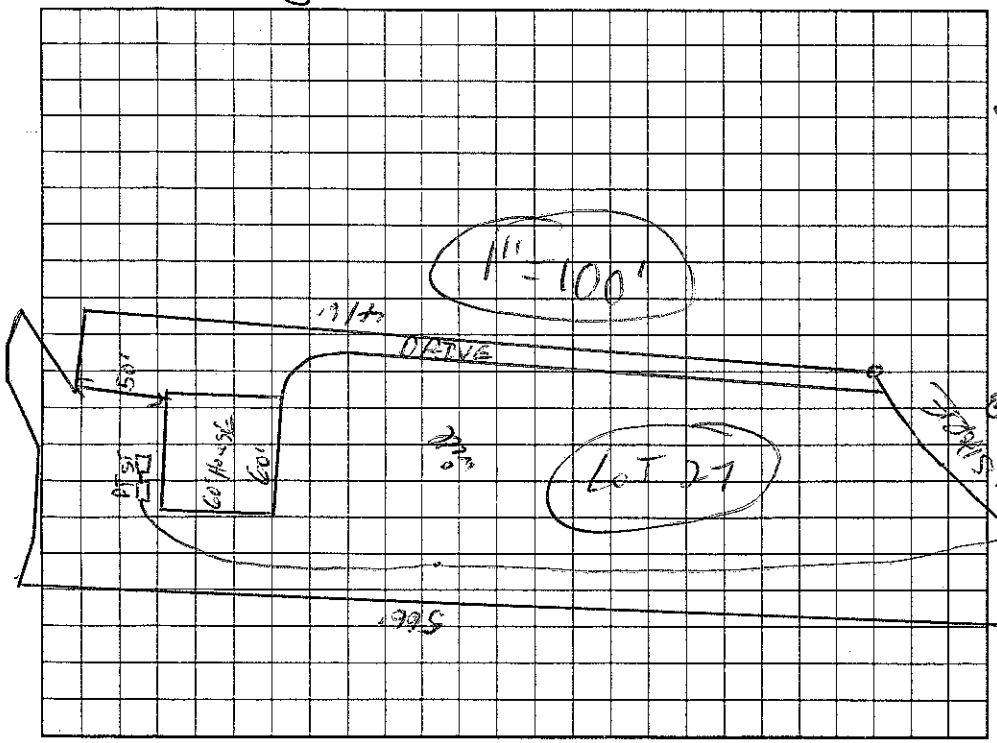

Comments/Conditions:

AS BUILT SKETCH

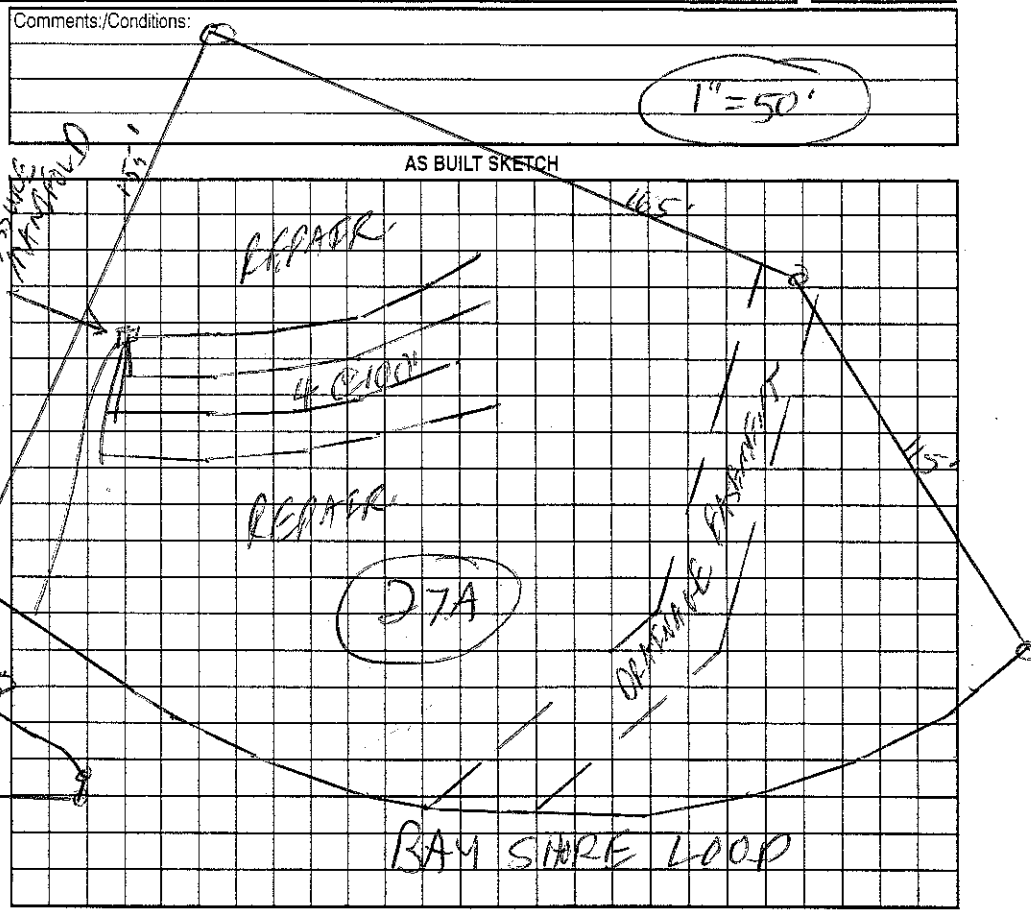

Permit can be suspended or revoked if any false information is supplied toward securing the permit/any unauthorized changes are made to the site/any unauthorized changes are made in the installation of the system. Improvement Permit with plat valid without expiration. Improvement Permit with site plan valid for sixty months. Authorization to Construct is valid for a period equal to that of Improvement Permit – not to exceed sixty months.

Signed: [signature] date 11-22-04 Installed by: Abernethy

Improvement Permit by: [signature] date 11/8/04 Operation Permit by: Wesley Sparks RS. date 6/2/06

Authorization to Construct by: Mallard H Dotson RS date 8/31/05 Existing System Inspection by: date

HEALTH DEPT. COPY: WHITE OWNER COPY (FINAL): YELLOW OWNER COPY (INITIAL): PINK