IREDELL COUNTY HEALTH DEPARTMENT

STATESVILLE 704-878-5305 MOORESVILLE 704-664-5281

IMPROVEMENT PERMIT / AUTHORIZATION TO CONSTRUCT / OPERATION PERMIT / EXISTING SYSTEM INSPECTION

PERMIT# 121638 PIN# 4639 61 5556.084 4639-61-9732 DATE 11/9/04

OWNER OR CONTRACTOR HECHT PROPERTIES / NEX HOMES PHONE: Business 483-3651 Home

ADDRESS 885 (N) HWY 16 DENVER NC 28037

LOCATION PERTH (S) - TR LIVA LN - TR BAY CROSSING - ON RT

SUBDIVISION BAY CROSSING BLOCK / SECTION 1 LOT 84 LOT AREA .91c SITE CLASS. PS DESIGN FLOW 480GPD L.T.A.R. .26 GPD/FT²

Septic Tank: ~~1000~~ 1500 Gallons; STB 338 Date 3-1-06

Pump Tank: 1000 Gallons; PT 283 Date 3-18-06

Pump Make: Goulds Model WE032M Serial No.

Nitrification Field: No Fields 1 Square Feet 600 Linear Feet 300

No Lines 4 Trench Width 24" Max Trench Bottom Depth 36" Gravel Depth N/A

☑ New System ☐ Repair System Type: I, II, III, IV, V, VI

System Description: LP PANEL

Repair System Description: SAME

Maintenance Agreement Required: ☑ Yes ☐ No

☑ House/Mod. Home No. Bedrooms 4

☐ Mobile Home No. Bathrooms 4

☐ Business No. Employees

☐ Other


☐ Slab ☑ Crawl Space ☐ Basement w/plumbing ☐ Basement wo/plumbing

Water Supply: ☑ Individual ☐ Public ☐ Community


Comments:/Conditions:

Comments:/Conditions: 5/32" hole drilled
Checked tanks & lines 4/25/06 MK
*Keep any pool 15ft from tanks & Drainfield. Supply line must be at least 10ft.
10/10/06 Drove past lot & it looks like a lot of Construction traffic has gone over Drainfield in Building pool.

INITIAL SITE SKETCH 1"=50'

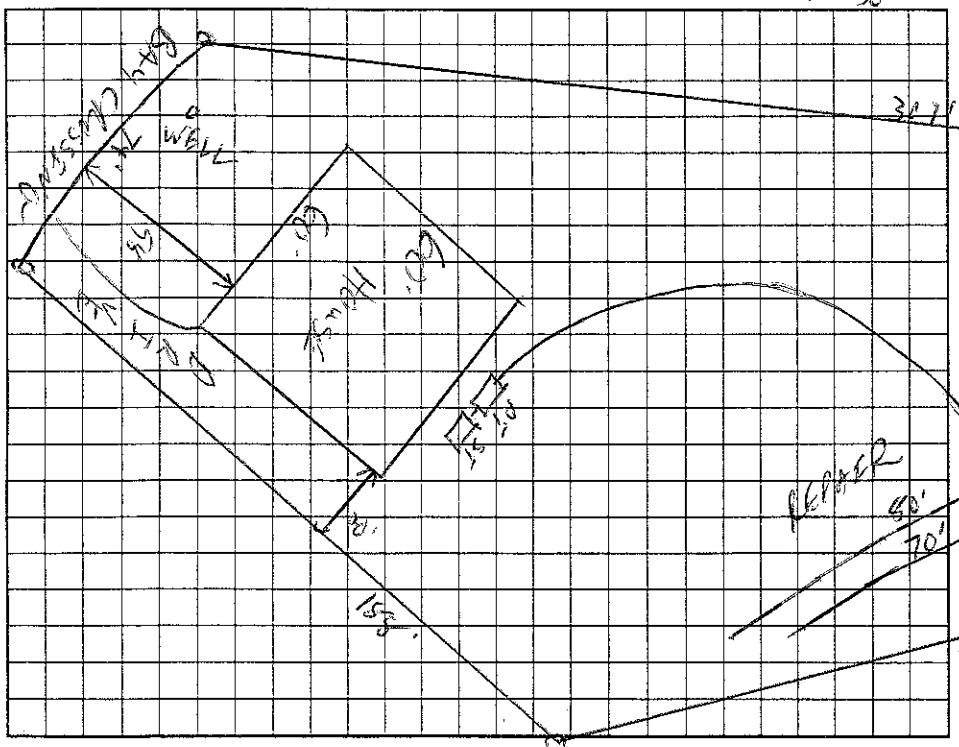

AS BUILT SKETCH

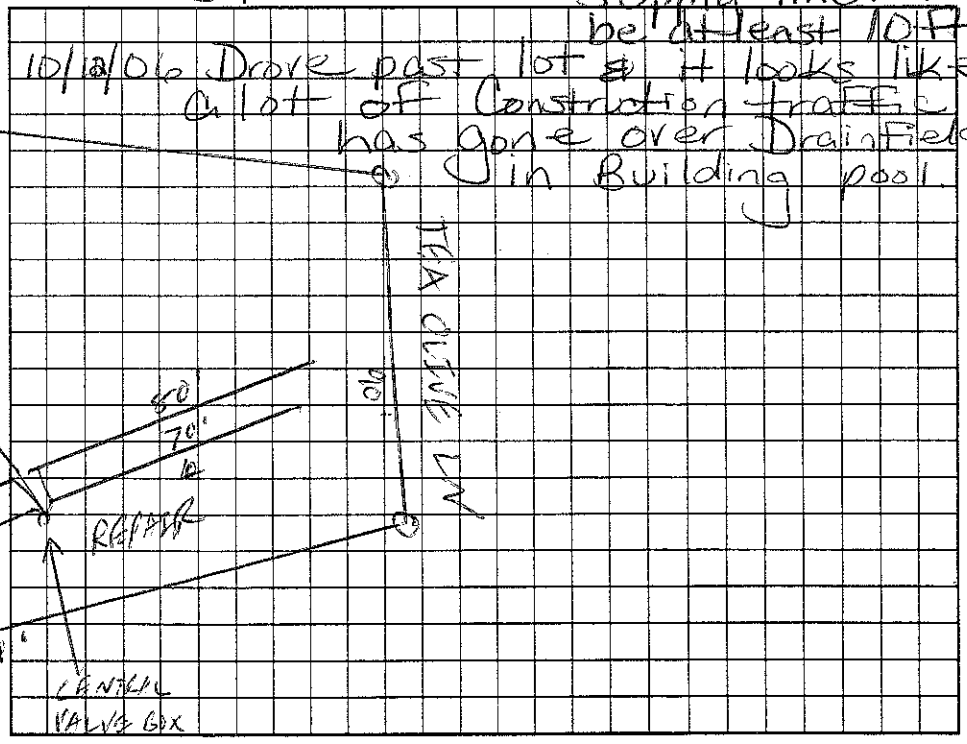

Permit can be suspended or revoked if any false information is supplied toward securing the permit/any unauthorized changes are made to the site/any unauthorized changes are made in the installation of the system. Improvement Permit with plat valid without expiration. Improvement Permit with site plan valid for sixty months. Authorization to Construct is valid for a period equal to that of Improvement Permit – not to exceed sixty months.

Signed: _____ date 11-22-04 Installed by: Richard Abernathy

Improvement Permit by: _____ RS date 11/9/04 Operation Permit by: _____ RS date 6/19/06

Authorization to Construct by: Wesley Sparks RS. date 4/15/05 Existing System Inspection by: _____ date _____

HEALTH DEPT. COPY: WHITE OWNER COPY (FINAL): YELLOW OWNER COPY (INITIAL): PINK