130

IREDELL COUNTY HEALTH DEPARTMENT

STATESVILLE 704-878-5305 MOORESVILLE 704-664-5281

IMPROVEMENT PERMIT / AUTHORIZATION TO CONSTRUCT / OPERATION PERMIT / EXISTING SYSTEM INSPECTIC

PERMIT# 125263 PIN# 4639-61-5556.038 4639620204 DATE May 23, 05

OWNER OR CONTRACTOR Heckt Properties Inc. / Jim Bradley PHONE: Business Home

ADDRESS 885 N. Hwy 16 Denver, N.C. 28037

LOCATION Perth Rd (N) TL Link Lane

SUBDIVISION Bay Crossing BLOCK / SECTION LOT 38 LOT AREA .95Ac ± SITE CLASS RS DESIGN FLOW 480gpd L.T.A.R. .3

Septic Tank: ~~1000~~ 1500 Gallons; STB 338 Date 3/25/05

Pump Tank: 1000 ✓ Gallons; PT 293 Date 4/22/05

Pump Make: Goulds Model WE0-512HH Serial No. 11/04

Nitrification Field: No Fields 1 Square Feet 1200 Linear Feet 400

No Lines 5@80' Trench Width 36" Max Trench Bottom Depth 36" Gravel Depth N/A

☒ New System ☐ Repair System Type: I, II, III, IV, V, VI

System Description: Pm 25% Reduction "accepted"

Repair System Description: Stone

Maintenance Agreement Required: ☐ Yes ☒ No

☒ House/Mod. Home No. Bedrooms 4

☐ Mobile Home No. Bathrooms

☐ Business No. Employees

☐ Other


☐ Slab ☐ Crawl Space ☒ Basement w/plumbing ☐ Basement wo/plumbing

Water Supply: ☒ Individual ☐ Public ☐ Community


Comments:/Conditions:

Comments:/Conditions:

1"=50' INITIAL SITE SKETCH

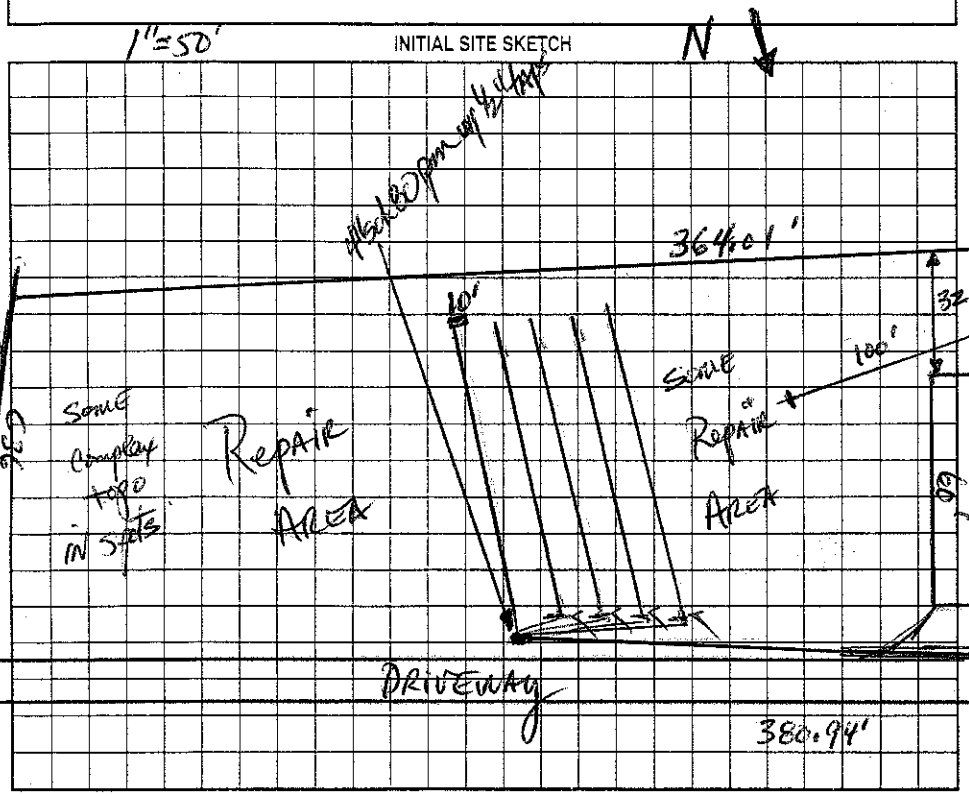

AS BUILT SKETCH

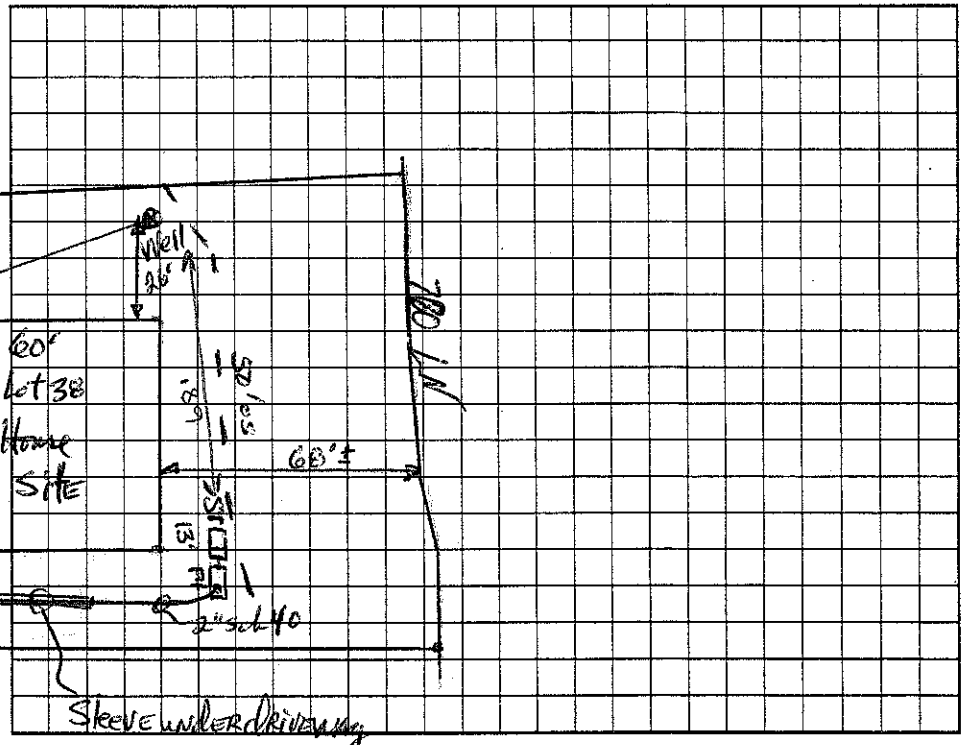

Permit can be suspended or revoked if any false information is supplied toward securing the permit/any unauthorized changes are made to the site/any unauthorized changes are made in the installation of the system. Improvement Permit with plat valid without expiration. Improvement Permit with site plan valid for sixty months. Authorization to Construct is valid for a period equal to that of Improvement Permit – not to exceed sixty months.

Signed: date 6/1/05 Installed by: Osborn & Sons

Improvement Permit by: date 5-23-05 Operation Permit by: Wesley Sparks RS date 12/7/05

Authorization to Construct by: date 12/19/05 Existing System Inspection by: date

HEALTH DEPT. COPY: WHITE OWNER COPY (FINAL): YELLOW OWNER COPY (INITIAL): PINK