130

IREDELL COUNTY HEALTH DEPARTMENT

STATESVILLE 704-878-5305 MOORESVILLE 704-664-5281

IMPROVEMENT PERMIT / AUTHORIZATION TO CONSTRUCT / OPERATION PERMIT / EXISTING SYSTEM INSPECTI

PERMIT# 125264 PIN# 4639-61-5336.039 4639-62-0333 DATE May 23, 05

OWNER OR CONTRACTOR Heritage Properties Inc. / Randy Rutkai PHONE: Business _____ Home _____

ADDRESS 885 N. Hwy 16, Denver, N.C. 28037

LOCATION Portland (N) TL Liva Lane TR Bay Crossing Dr. TL Bay Shore Loop on left

SUBDIVISION Bay Crossing BLOCK / SECTION 2 LOT 39 LOT AREA .92 Ac SITE CLASS PS DESIGN FLOW 480gpd L.T.A.R. .03

Septic Tank: ~~1000~~ 1500 Gallons; STB 524 Date 4/14/06

Pump Tank: 1000 Gallons; PT 17 Date 5/1/06

Pump Make Ecoflo Model WE1012HC Serial No. J0763928

Nitrification Field: No Lines 90 Square Feet 1200 Linear Feet 400

No Lines 5 @ 80' Trench Width 36" Max Trench Bottom Depth 36" Gravel Depth N/A

☒ New System ☐ Repair System Type: I, II, III, IV, V, VI

System Description: conv 25% Reduction

Repair System Description: SAME

Maintenance Agreement Required: ☐ Yes ☒ No

☒ House/Mod. Home No. Bedrooms 4

☐ Mobile Home No. Bathrooms ____

☐ Business No. Employees ____

☐ Other ____

☐ Slab ☐ Crawl Space ☒ Basement w/plumbing ☐ Basement wo/plumbing


Water Supply: ☒ Individual ☐ Public ☐ Community

Comments:/Conditions: 10/4/07 Okay to install in 6 lines @ 68 FT


Comments:/Conditions: Tanks. 17 Chambers per ditch 10/8/07 Checked lines used Quick 4

1"=50'

INITIAL SITE SKETCH

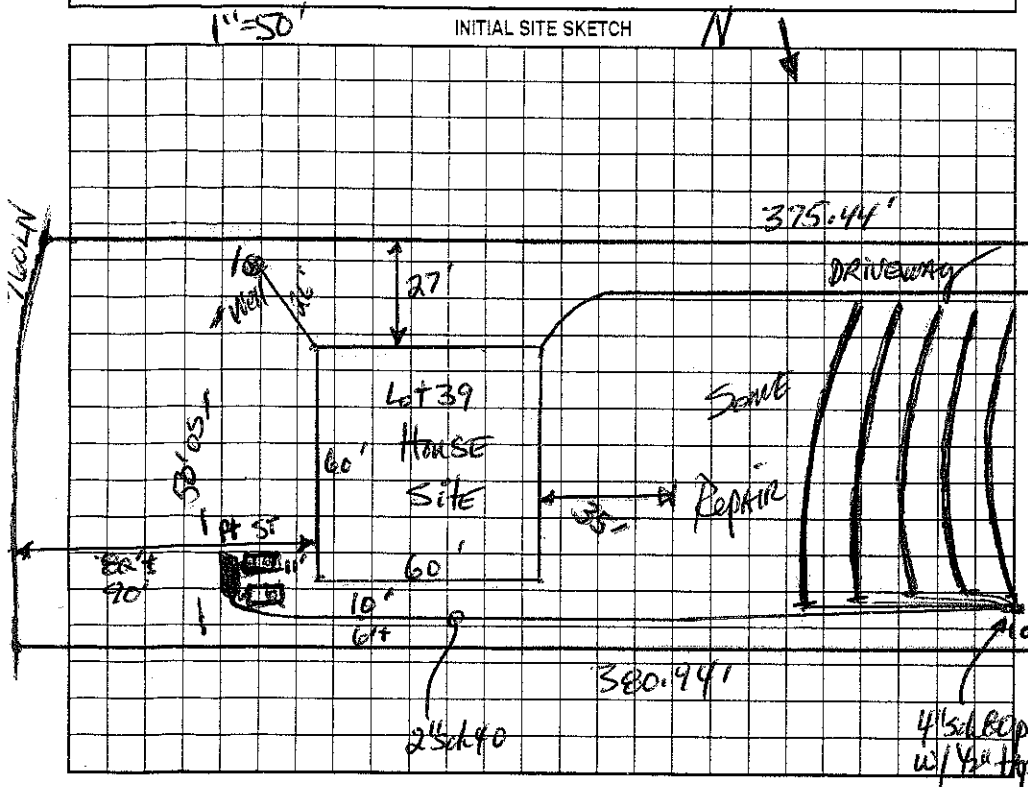

AS BUILT SKETCH

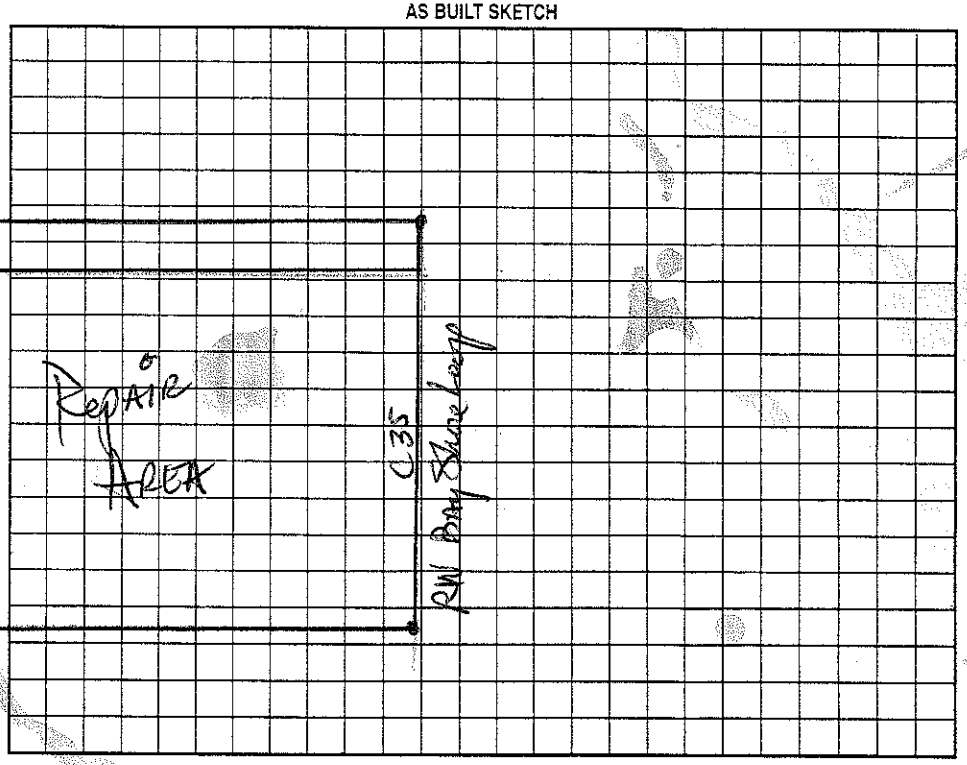

Permit can be suspended or revoked if any false information is supplied toward securing the permit/any unauthorized changes are made to the site/any unauthorized changes are made in the installation of the system. Improvement Permit with plat valid ~~without~~ expiration. Improvement Permit with site plan valid for sixty months. Authorization to Construct is valid for a period equal to that of ~~Improvement Permit~~ not to exceed sixty months.

Signed: [signature] Agent date 6/1/05

Improvement Permit by: [signature] date 5-23-05

Authorization to Construct by: [signature] date 8-1-06

Installed by: Steve Jordon

Operation Permit by: [signature] date 4-16-08

Existing System Inspection by: _____ date _____

HEALTH DEPT. COPY: WHITE OWNER COPY (FINAL): YELLOW OWNER COPY (INITIAL): PINK