IREDELL COUNTY HEALTH DEPARTMENT

STATESVILLE 704-878-5305 MOORESVILLE 704-664-5281

130

IMPROVEMENT PERMIT / AUTHORIZATION TO CONSTRUCT / OPERATION PERMIT / EXISTING SYSTEM INSPECTION

PERMIT# 12526B PIN# 4639-61-5536.040 4639620496 DATE May 23, 05

OWNER OR CONTRACTOR Heckel Properties Inc / Dethrijen PHONE: Business Home

ADDRESS 885 N Hwy 16, Denver, N.C. 28037

LOCATION Penhard (N) TL Liva Lane TR Bay Crossing Dr. TL BayShore Loop on left

SUBDIVISION Bay Crossing BLOCK / SECTION LOT 40 LOT AREA .93Ac. SITE CLASS. PS DESIGN FLOW 480gpd L.T.A.R. .3

Septic Tank: ~~1000~~ 1500 Gallons: STB 338 Date 2/13/06

Pump Tank: 1000 ✓ Gallons: PT 283 Date 4/30/06

Pump Make: Gould Model WE4-712HC Serial No.

Nitrification Field: No Fields 1 Square Feet 1200 Linear Feet 400

No Lines 5 @ 80' Trench Width 36" Max Trench Bottom Depth 36"

☒ New System ☐ Repair System Type: I, II, III, IV, V, VI

System Description: pm 25% Reduction

Repair System Description: LPPPPS

Maintenance Agreement Required: ☐ Yes ☒ No initially

Gravel Depth NA

☒ House/Mod. Home No. Bedrooms 4

☐ Mobile Home No. Bathrooms

☐ Business No. Employees

☐ Other

☐ Slab ☐ Crawl Space ☒ Basement w/plumbing ☐ Basement wo/plumbing


Water Supply: ☒ Individual ☐ Public ☐ Community

Comments:/Conditions:


Comments:/Conditions: Lines, tanks & pressure Checked by AWS 6/15/06!

1"=50'

INITIAL SITE SKETCH

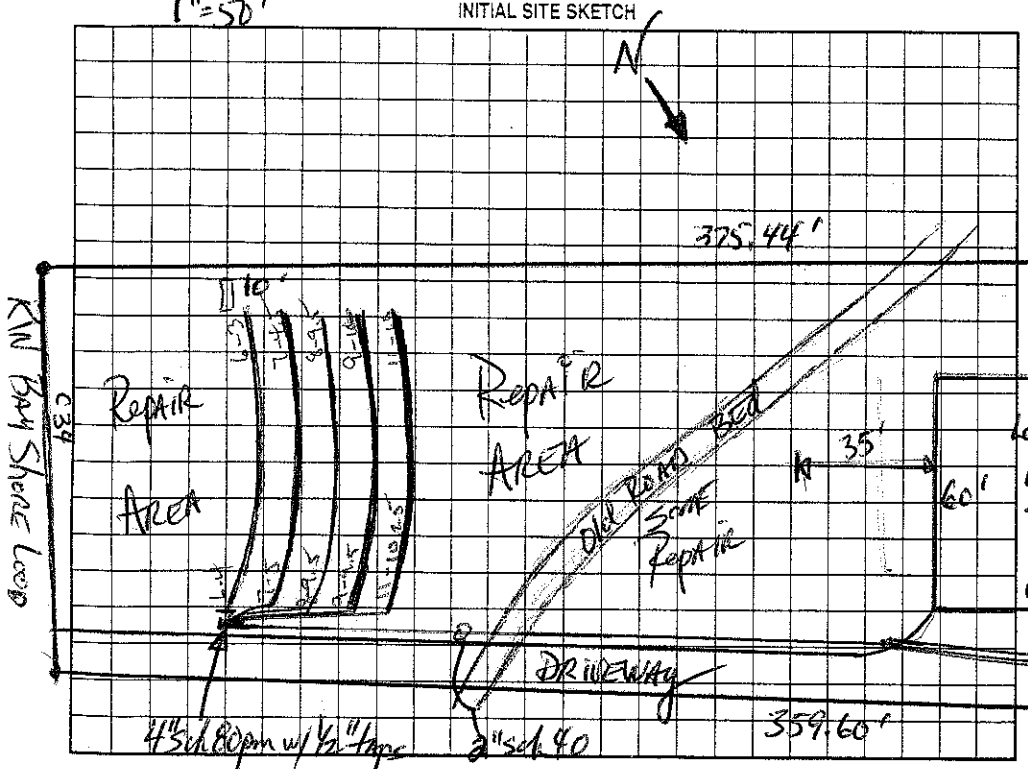

AS BUILT SKETCH

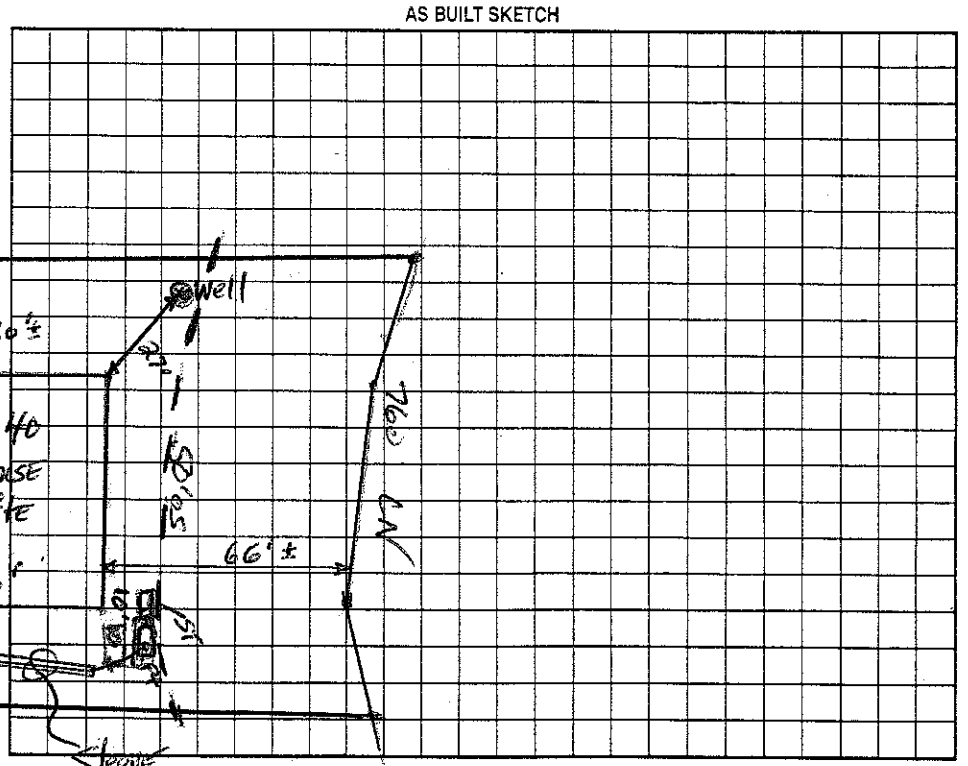

Permit can be suspended or revoked if any false information is supplied toward securing the permit/any unauthorized changes are made to the site/any unauthorized changes are made in the installation of the system. Improvement Permit with plat valid without expiration. Improvement Permit with site plan valid for sixty months. Authorization to Construct is valid for a period equal to that of Improvement Permit – not to exceed sixty months.

Signed: date 6/1/05 Installed by: Larry Hawkley PS

Improvement Permit by: date 5-23-05 Operation Permit by: Maria H Wilson PS date 10/27/06

Authorization to Construct by: date 12/7/05 Existing System Inspection by: date

HEALTH DEPT. COPY: WHITE OWNER COPY (FINAL): YELLOW OWNER COPY (INITIAL): PINK