IREDELL COUNTY HEALTH DEPARTMENT

STATE F 704-878-5305 MOORESVILLE 704-664-5281

IMPROVEMENT PERMIT / AUTHORIZATION TO CONSTRUCT / OPERATION PERMIT / EXISTING SYSTEM INSPECTION

PERMIT# 125272 PIN# 4639 61 5556 .041 4639621532 DATE 8/25/05

OWNER OR CONTRACTOR Salvatore Andolina PHONE: Business 704-634-9094 Home

ADDRESS 127-D Promenade Dr. Mooresville, NC. 28115

LOCATION Perth (N) TL Livaken TR Bay Crossing Dr. TL Bay Shore Lp. on (L)

SUBDIVISION Bay Crossing BLOCK / SECTION LOT 41 LOT AREA .93ac SITE CLASS. PS DESIGN FLOW 480 L.T.A.R. .3

Septic Tank: 1500 Gallons; STB 336 Date 3/6/06

Pump Tank: 1000 Gallons; PT 283 Date 8/1/05

Pump Make: Gould Model WE0512HH4 Serial No.

Nitrification Field: No Fields 1 Square Feet 1200 Linear Feet 400

No Lines 5@80' Trench Width 3' Max Trench Bottom Depth 3' Gravel Depth

☐ New System ☐ Repair System Type: I, II, III, IV, V, VI

System Description: PressMan → 25% Reduction

Repair System Description: 16" LP PABPS

Maintenance Agreement Required: ☐ Yes ☒ No INITIALLY

☒ House/Mod. Home ☐ Mobile Home ☐ Business ☐ Other

No. Bedrooms 4 No. Bathrooms 4 No. Employees

☐ Slab ☐ Crawl Space ☒ Basement w/plumbing ☐ Basement wo/plumbing


Water Supply: ☒ Individual ☐ Public ☐ Community

Comments:/Conditions:


Comments:/Conditions:

(1" = 50')

INITIAL SITE SKETCH

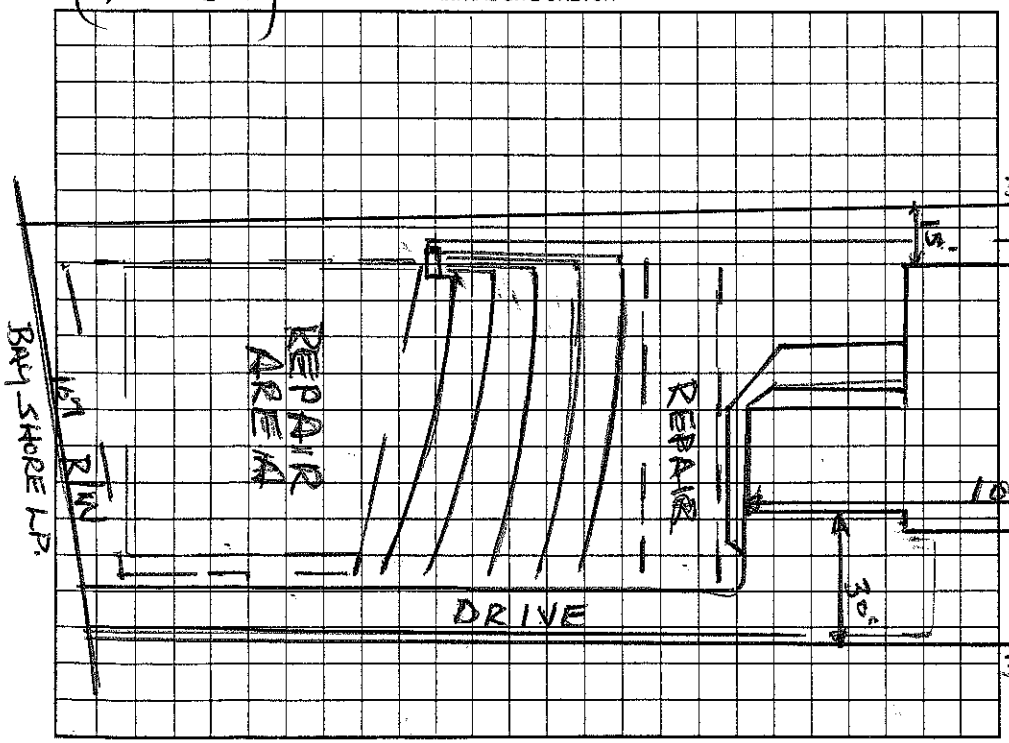

AS BUILT SKETCH

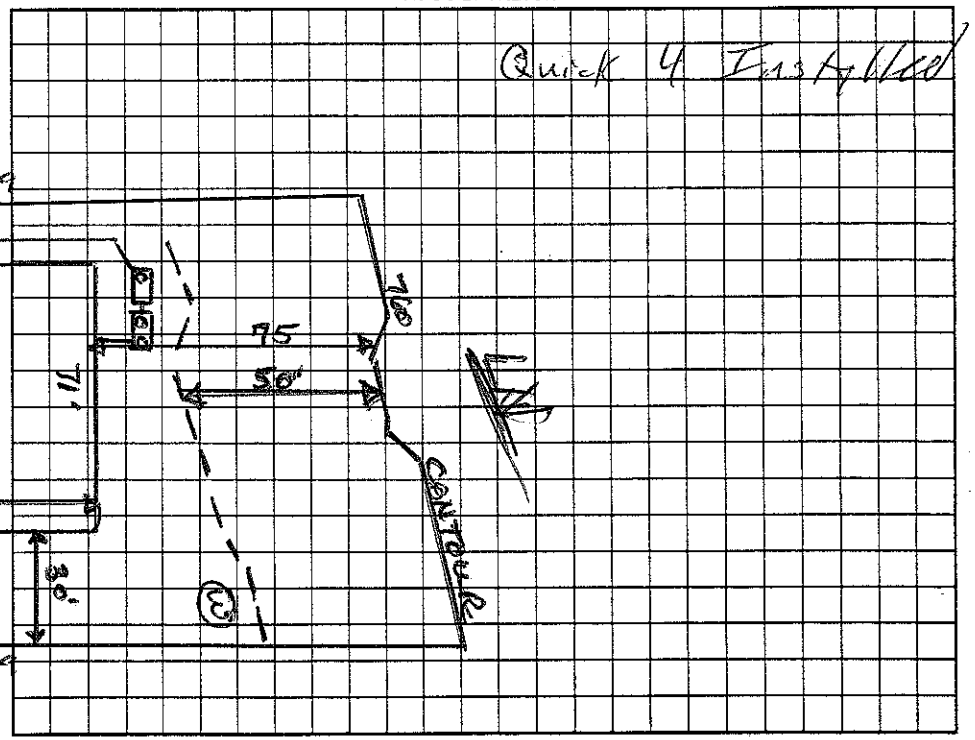

Permit can be suspended or revoked if any false information is supplied toward securing the permit/any unauthorized changes are made to the site/any unauthorized changes are made in the installation of the system. Improvement Permit with plat valid without expiration. Improvement Permit with site plan valid for sixty months. Authorization to Construct is valid for a period equal to that of Improvement Permit – not to exceed sixty months.

Signed: Salvatore Andolina date 8-29-05 Installed by: Abernathy

Improvement Permit by: Wesley Sparks RS. date 8/25/05 Operation Permit by: RS date 6/5/06

Authorization to Construct by: Wesley Sparks RS date 8/25/05 Existing System Inspection by: date

HEALTH DEPT. COPY: WHITE OWNER COPY (FINAL): YELLOW OWNER COPY (INITIAL): PINK