IREDELL COUNTY HEALTH DEPARTMENT

STATESVILLE 704-878-5305 130 MOORESVILLE 704-664-5281 2130

IMPROVEMENT PERMIT / AUTHORIZATION TO CONSTRUCT / OPERATION PERMIT / EXISTING SYSTEM INSPECTION

PERMIT# 125321 PIN# ~~4639-61-5556.094~~ 4639622046 DATE May 26, 05

OWNER OR CONTRACTOR Heidt Properties Inc. / DV Wise PHONE: Business Home

ADDRESS 885 N Hwy 16 Denver, N.C. 28037

LOCATION 2 Post Rd. (N) TL Liva Lane TR Bay Crossing DR. TL 1st Bay Shore Loop on Right

SUBDIVISION Bay Crossing BLOCK / SECTION 2 LOT 94 LOT AREA .82 Ac SITE CLASS. PS DESIGN FLOW 480 gpd L.T.A.R. .3

Septic Tank: 1000 Gallons; STB 338 Date 4-4-06
Pump Tank: 1000 Gallons; PT 283 Date 6-10-06
Pump Make: Goulds Model WE0312M Serial No.
Nitrification Field: No Fields 1 Square Feet 1200 Linear Feet 400
No Lines 3 Trench Width 36" Max Trench Bottom Depth 36"

☒ New System ☐ Repair System Type: I, II, III, IV, V, VI
System Description: pm - 25% Reduction
Repair System Description: LPPBPS
Maintenance Agreement Required: ☐ Yes ☒ No Initially


Gravel Depth N/A ☐ Slab ☒ Crawl Space ☐ Basement w/plumbing ☐ Basement wo/plumbing

☒ House/Mod. Home No. Bedrooms 4
☐ Mobile Home No. Bathrooms
☐ Business No. Employees
☐ Other

Water Supply: ☒ Individual ☐ Public ☐ Community

Comments:/Conditions: Shave off old burn" 280.48'

INITIAL SITE SKETCH

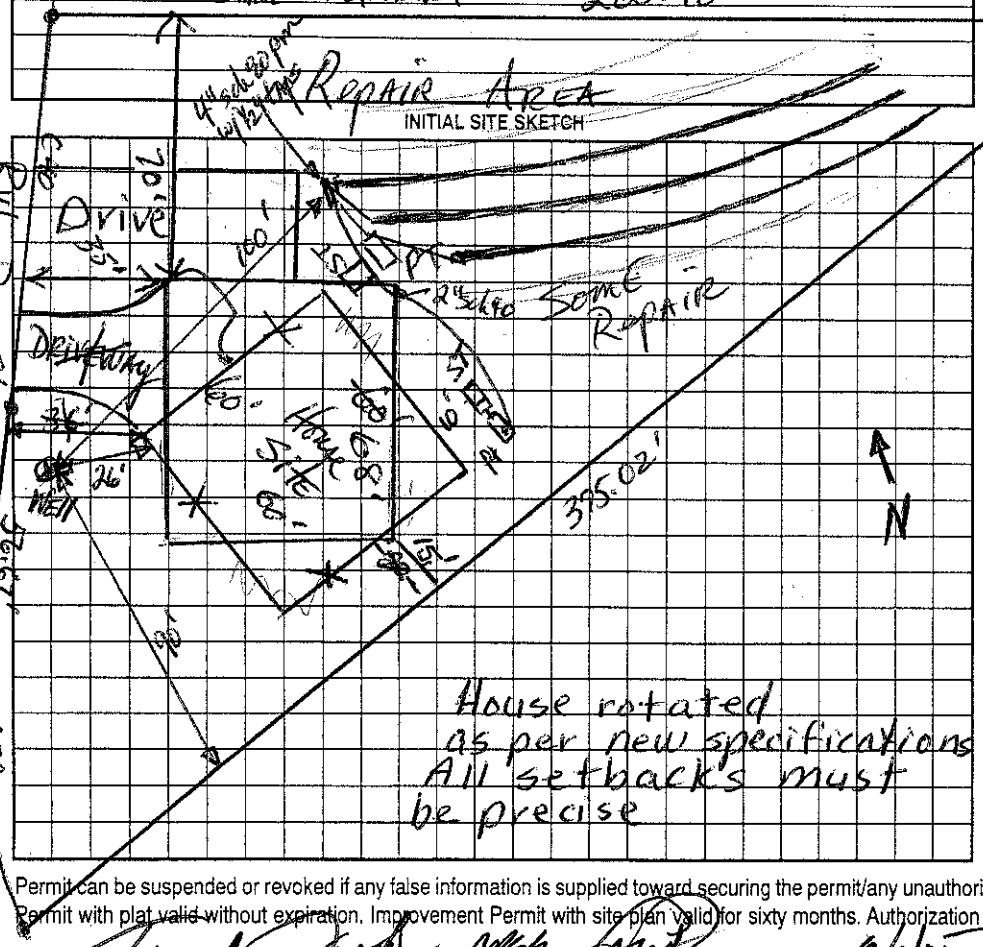

Comments:/Conditions: Installed Quick 4 as Shown Checked 10/11/06 & Tanks Checked 10/11/06 Checked pressure 10/13/06 MS

AS BUILT SKETCH 1"=50'

Permit can be suspended or revoked if any false information is supplied toward securing the permit/any unauthorized changes are made to the site/any unauthorized changes are made in the installation of the system. Improvement Permit with plat valid without expiration. Improvement Permit with site plan valid for sixty months. Authorization to Construct is valid for a period equal to that of Improvement Permit – not to exceed sixty months.

Signed: date 6/1/05 Installed by: Richard Abernathy

Improvement Permit by: date 5-26-05 Operation Permit by: date 3/12/07

Authorization to Construct by: date 4-24-06 Existing System Inspection by: date

HEALTH DEPT. COPY: WHITE OWNER COPY (FINAL): YELLOW OWNER COPY (INITIAL): PINK