~~1:30~~ 11:00

IREDELL COUNTY HEALTH DEPARTMENT

STATESVILLE 704-878-5305 MOORESVILLE 704-664-5281

IMPROVEMENT PERMIT / AUTHORIZATION TO CONSTRUCT / OPERATION PERMIT / EXISTING SYSTEM INSPECTIO

PERMIT# 125277 PIN# 4639-61-5556, 043 4639-62-2743 DATE June 15, 05

OWNER OR CONTRACTOR Heath Prop. Inc. / Lamonica PHONE: Business Home

ADDRESS 885 N Hwy 16, Denver, N.C. 28037

LOCATION Fourth Rd. (N) TL Liva Lane TR Bay Crossing Dr. to end TL Bay Shore Loop on Right

SUBDIVISION Bay Crossing BLOCK / SECTION 2 LOT 43/43A LOT AREA .93Ac + 19,577ft² SFE SITE CLASS. PS SFE DESIGN FLOW 480gpd L.T.A.R. .25 SFE 43A

Septic Tank: 1500 ~~1000~~ Gallons; STB 444 Date 11-13-07

Pump Tank: 1000 Gallons; PT 283 Date 11-21-07

Pump Make: Goulds Model WE512H Serial No.

Nitrification Field: No Fields 1 Square Feet 1440 Linear Feet 480

No Lines 6@80' Trench Width 36" Max Trench Bottom Depth 36" Gravel Depth NA

☒ New System ☐ Repair System Type: I, II, III, IV, V, VI

System Description: pm 25% Reduction on SFE 43A

Repair System Description: LPPPBPS on SFE 43A

Maintenance Agreement Required: ☐ Yes ☒ No initially

☒ House/Mod. Home ☐ Mobile Home ☐ Business ☐ Other

No. Bedrooms 4 No. Bathrooms No. Employees


☐ Slab ☐ Crawl Space ☒ Basement w/plumbing ☐ Basement wo/plumbing

Water Supply: ☒ Individual ☐ Public ☐ Community


Comments:/Conditions: 75ft to well
3" supply line from tank to off site Connection

Comments:/Conditions: 12/7/07 Cheaked Quick 4 Drain lines 1/8/08 Check tanks & Set 3ft pressure

INITIAL SITE SKETCH

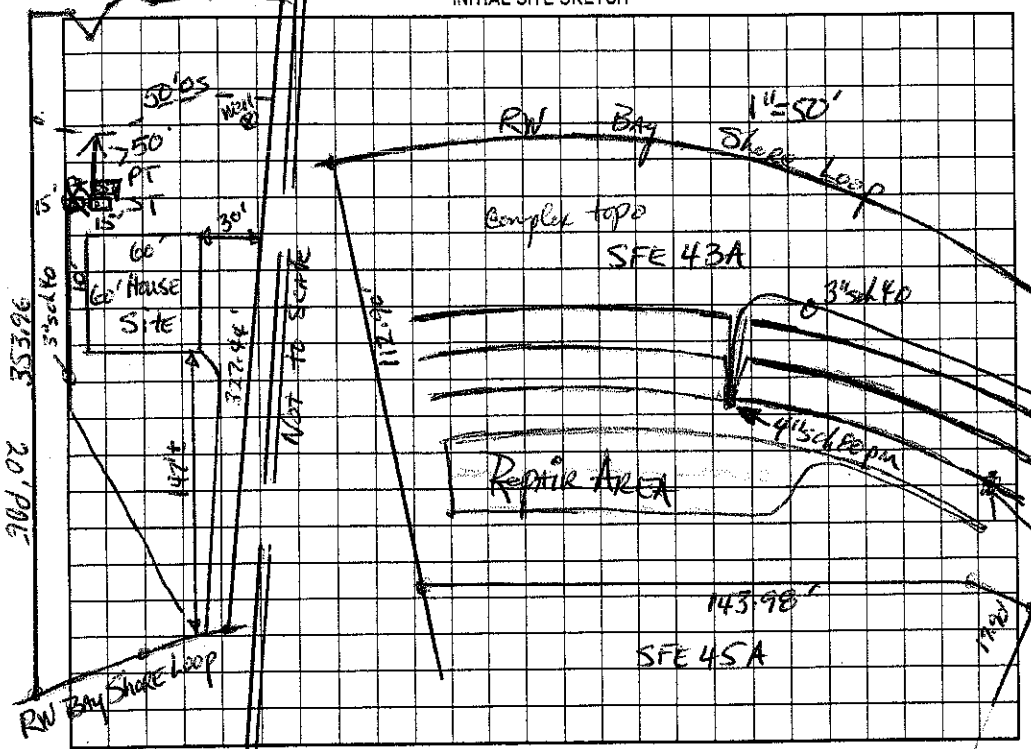

AS BUILT SKETCH

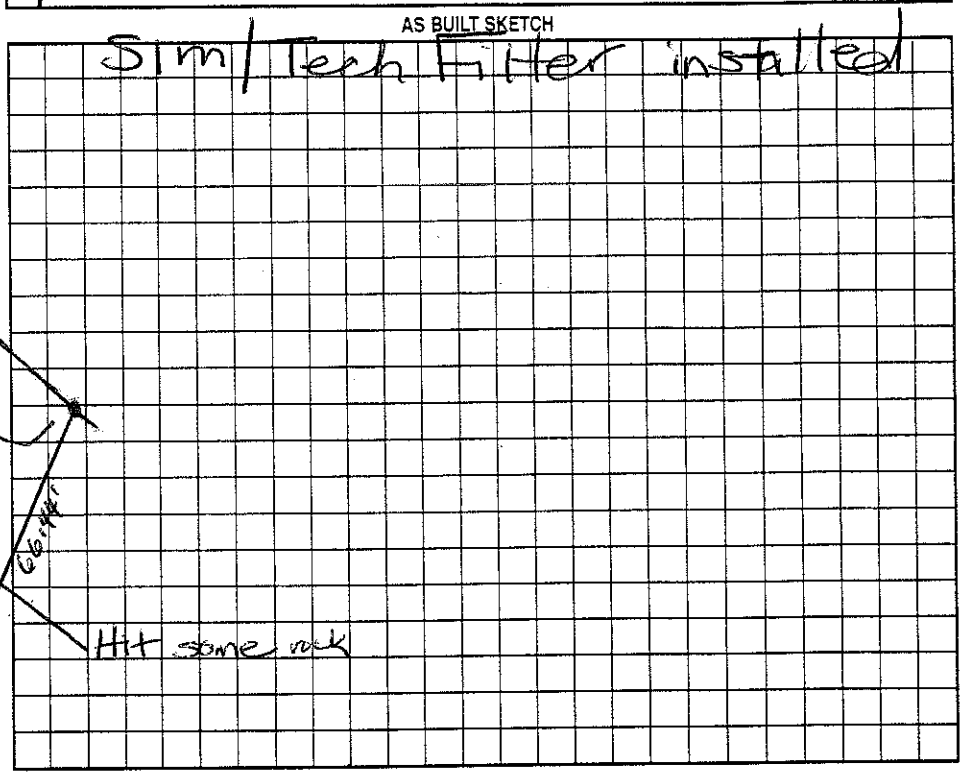

Permit can be suspended or revoked if any false information is supplied toward securing the permit/any unauthorized changes are made to the site/any unauthorized changes are made in the installation of the system. Improvement Permit with plat valid without expiration. Improvement Permit with site plan valid for sixty months. Authorization to Construct is valid for a period equal to that of Improvement Permit – not to exceed sixty months.

Signed: [signature] date 6/17/05

Improvement Permit by: [signature], RS date 6-15-05

Authorization to Construct by: [signature] date 2/27/07

Installed by: C. Wayne Orbison

Operation Permit by: [signature], RS date 3/10/08

Existing System Inspection by: date

HEALTH DEPT. COPY: WHITE OWNER COPY (FINAL): YELLOW OWNER COPY (INITIAL): PINK