IREDELL COUNTY HEALTH DEPARTMENT

STATESVILLE 704-878-5305 MOORESVILLE 704-664-5281

IMPROVEMENT PERMIT / AUTHORIZATION TO CONSTRUCT / OPERATION PERMIT / EXISTING SYSTEM INSPECTION

PERMIT # 153217 PIN # 4639-71-5886 62 4358 DATE 10-21-08

OWNER or APPLICANT Larry Blakley PHONE: Business 828-757-0878 Home:

OWNER or APPLICANT ADDRESS 5852 Shady Grove Ln Lenoir NC 28645

LOCATION / DIRECTIONS Liva Lane TR Bay Crossing TR Tea Olive 133 Tea Olive Lane

SUBDIVISION Bay Crossing BLOCK / SECTION 1 LOT # 71 LOT AREA .68 DESIGN FLOW 480 L.T.A.R. .3

Septic Tank ____ Gallons: STB ____ Date ____

Pump Tank ____ Gallons: P T ____ Date ____

Pump Make ____ Model EXISTING Serial # ____

Nitrification Field No Fields____ No Lines____ Linear Feet ____

Trench Width ____ Max. Trench Bottom Depth ____ Gravel Depth ____

☐ New System ☐ Repair ☐ Expansion System Type I (II) III IV V VI

System Description: Gravity 25%

Repair System Description: SAME

Maintenance Agreement Required ☐ YES ☒ NO

☒ GRAVITY ☐ PRESSURE

☒ Residence No. Bedrooms 4

☐ Business No. Persons ____

☐ Other No. Employees ____

☐ Slab ☐ Crawl Space


☐ Basement w/plumbing ☐ Basement w/o plumbing

Water Supply: ☒ Private ☐ Public ☐ Community


Comments / Conditions: System is OK for proposed addition

Comments / Conditions

INITIAL SITE SKETCH

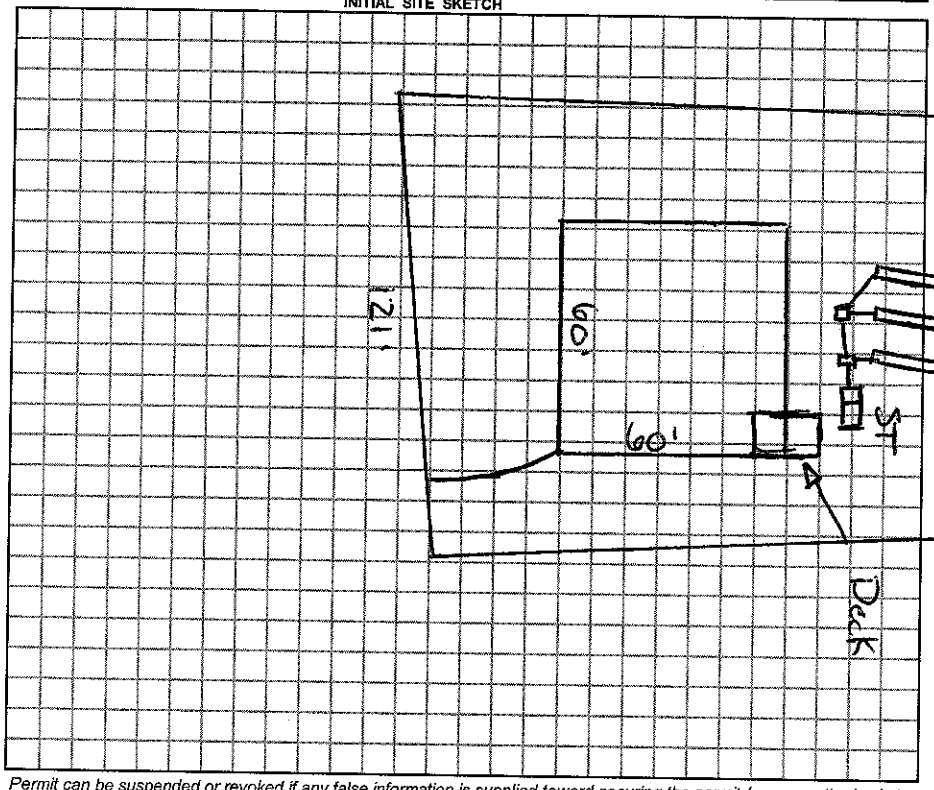

AS BUILT SKETCH

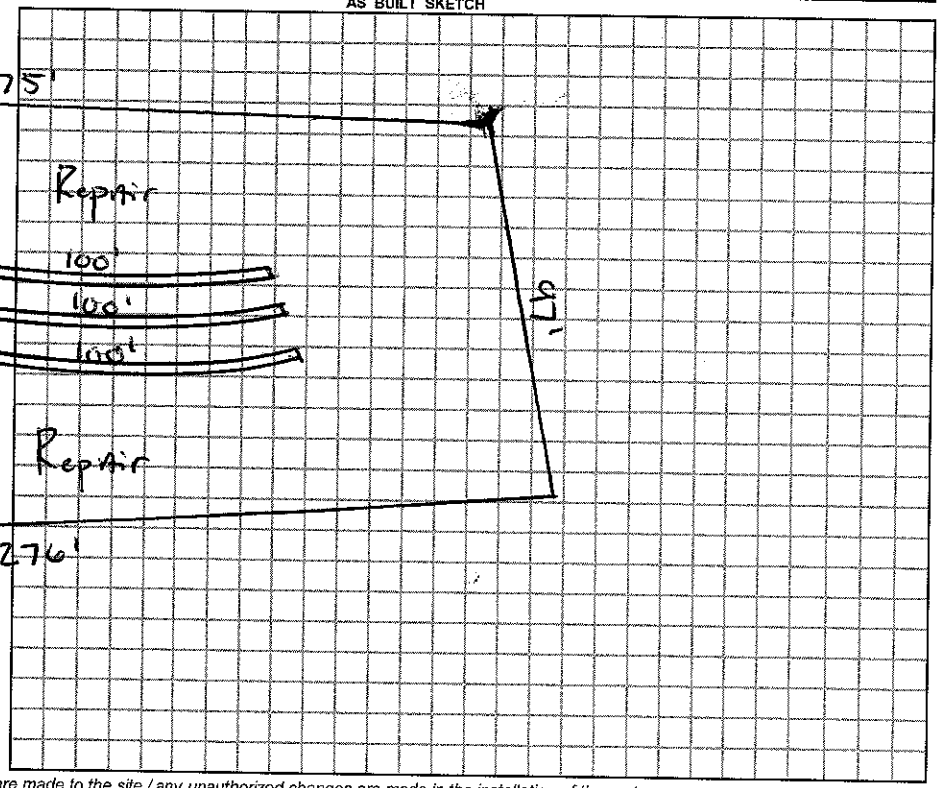

Permit can be suspended or revoked if any false information is supplied toward securing the permit / any unauthorized changes are made to the site / any unauthorized changes are made in the installation of the system.

☐ *IMPROVEMENT PERMIT w / plat valid without expiration.* ☐ *IMPROVEMENT PERMIT w / site plan valid for 60 mos.* ☐ *AUTHORIZATION TO CONSTRUCT valid for period equal to IMPROVEMENT PERMIT-not to exceed 60 mo.*

Owner / Applicant Signature: Larry Blakley Date ____

Improvement Permit by: ____ Date ____

Authorzation to Construct by: ____ Date ____

YOU SHOULD CONTACT A LOCATOR SERVICE PRIOR TO ANY EXCAVATION.

Installed by: ____

Operation Permit by: ____ Date: ____

Existing System Inspected by: B-A Date: 10-21-08

WHITE COPY Environmental Health YELLOW COPY (Final) Owner / Applicant PINK COPY (Initial) Owner / Applicant