IREDELL COUNTY HEALTH DEPARTMENT

STATESVILLE 704-878-5305 175 MOORESVILLE 704-664-5281 330

IMPROVEMENT PERMIT / AUTHORIZATION TO CONSTRUCT / OPERATION PERMIT / EXISTING SYSTEM INSPECTION

PERMIT# 125336 PIN# 4639-61-5556.098 4639-62-5406 DATE June 10, 05

OWNER OR CONTRACTOR Hewlett Prop. Inc. PHONE: Business _____ Home _____

ADDRESS 885 N. Hwy 16 Denver N.C. 28037

LOCATION Perth Rd (N) TL Liva Lane TR Bay Crossing Dr. TL 1st Bay Shore loop on Right

SUBDIVISION Bay Crossing BLOCK / SECTION _____ LOT 98/98A LOT AREA .78AC + 33,541 SF SITE CLASS. PS SFE DESIGN FLOW 480 gpd L.T.A.R. .3 on SFE 98A

Septic Tank: 1000 Gallons; STB 444 Date 2-10-06

Pump Tank: 1000 Gallons; PT 27 Date 11-11-06

Pump Make: _____ Model _____ Serial No. _____

Nitrification Field: No Fields 1 Square Feet 540/810 Linear Feet 270

No Lines 4 Trench Width 24" min 18" oc Max Trench Bottom Depth 36" Gravel Depth N/A

☒ New System ☐ Repair System Type: I, II, III, IV, V, VI

System Description: LPPPBPS

Repair System Description: LPPPBPS

Maintenance Agreement Required: ☒ Yes ☐ No

☒ House/Mod. Home No. Bedrooms 4

☐ Mobile Home No. Bathrooms ____

☐ Business No. Employees ____

☐ Other _____


☐ Slab ☒ Crawl Space ☐ Basement w/plumbing ☐ Basement wo/plumbing

Water Supply: ☒ Individual ☐ Public ☐ Community

Comments:/Conditions: 24" 36" max 9'oc

Comments:/Conditions:

INITIAL ~~SITE SKETCH~~ 1"=100'

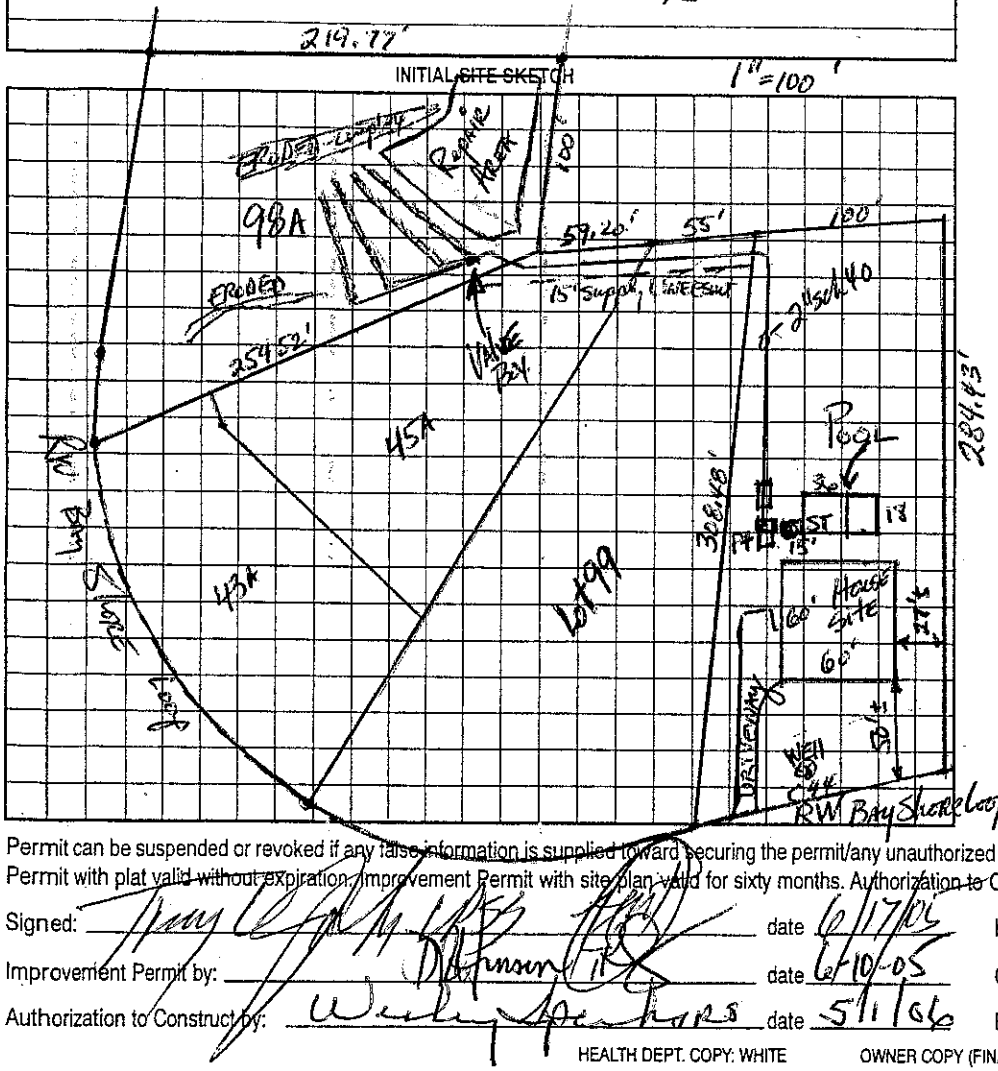

AS BUILT SKETCH

The proposed / existing Pool addition does not appear to impact the existing septic system.

**NOTE: _____ REHS

Date: 8-16-10

ICHD-Environmental Health Division

Permit can be suspended or revoked if any false information is supplied toward securing the permit/any unauthorized changes are made to the site/any unauthorized changes are made in the installation of the system. Improvement Permit with plat valid without expiration. Improvement Permit with site plan valid for sixty months. Authorization to Construct is valid for a period equal to that of Improvement Permit – not to exceed sixty months.

Signed: _____ date 6/17/05

Improvement Permit by: _____ date 6-10-05

Authorization to Construct by: _____ date 5/1/06

Installed by: Richard Abernathy

Operation Permit by: _____ date 5-5-07

Existing System Inspection by: _____ date _____

HEALTH DEPT. COPY: WHITE OWNER COPY (FINAL): YELLOW OWNER COPY (INITIAL): PINK