IREDELL COUNTY HEALTH DEPARTMENT

STATESVILLE 704-878-5305 175 MOORESVILLE 704-664-5281 330

IMPROVEMENT PERMIT / AUTHORIZATION TO CONSTRUCT / OPERATION PERMIT / EXISTING SYSTEM INSPECTION

PERMIT# 125336 PIN# 4639-61-5556.098 4639-62-5406 DATE June 10, 05

OWNER OR CONTRACTOR Heidt Prop. Inc. PHONE: Business Home

ADDRESS 885 N. Hwy 16, Denver NC. 28037

LOCATION Post Rd (N), TL Liva Lane TR Bay Crossing Dr. TL 1st Bay Shore Loop on Right

SUBDIVISION Bay Crossing BLOCK / SECTION LOT 98/98A LOT AREA .78AC + 33,541 FT SF SITE CLASS. PS SPE DESIGN FLOW 480 gpd L.T.A.R. .3 on SFE 98A

Septic Tank: 1000 Gallons; STB 444 Date 2-19-06 [X] New System [ ] Repair System Type: I, II, III, IV, V, VI

Pump Tank: 1000 Gallons; PT 27 Date 11-11-06 System Description: LPPPBPS

Pump Make: Model Serial No. Repair System Description: LPPPBPS

Nitrification Field: No Fields 1 Square Feet 540/810 Linear Feet 270 Maintenance Agreement Required: [X] Yes [ ] No

No Lines 4 Trench Width 24" min 36" Max Trench Bottom Depth 36" Gravel Depth N/A

[X] House/Mod. Home No. Bedrooms 4

[ ] Mobile Home No. Bathrooms

[ ] Business No. Employees

[ ] Other


[ ] Slab [X] Crawl Space [ ] Basement w/plumbing [ ] Basement wo/plumbing

Water Supply: [X] Individual [ ] Public [ ] Community

Comments:/Conditions: @ 36" MAF 90c

Comments:/Conditions:

INITIAL ~~SITE SKETCH~~

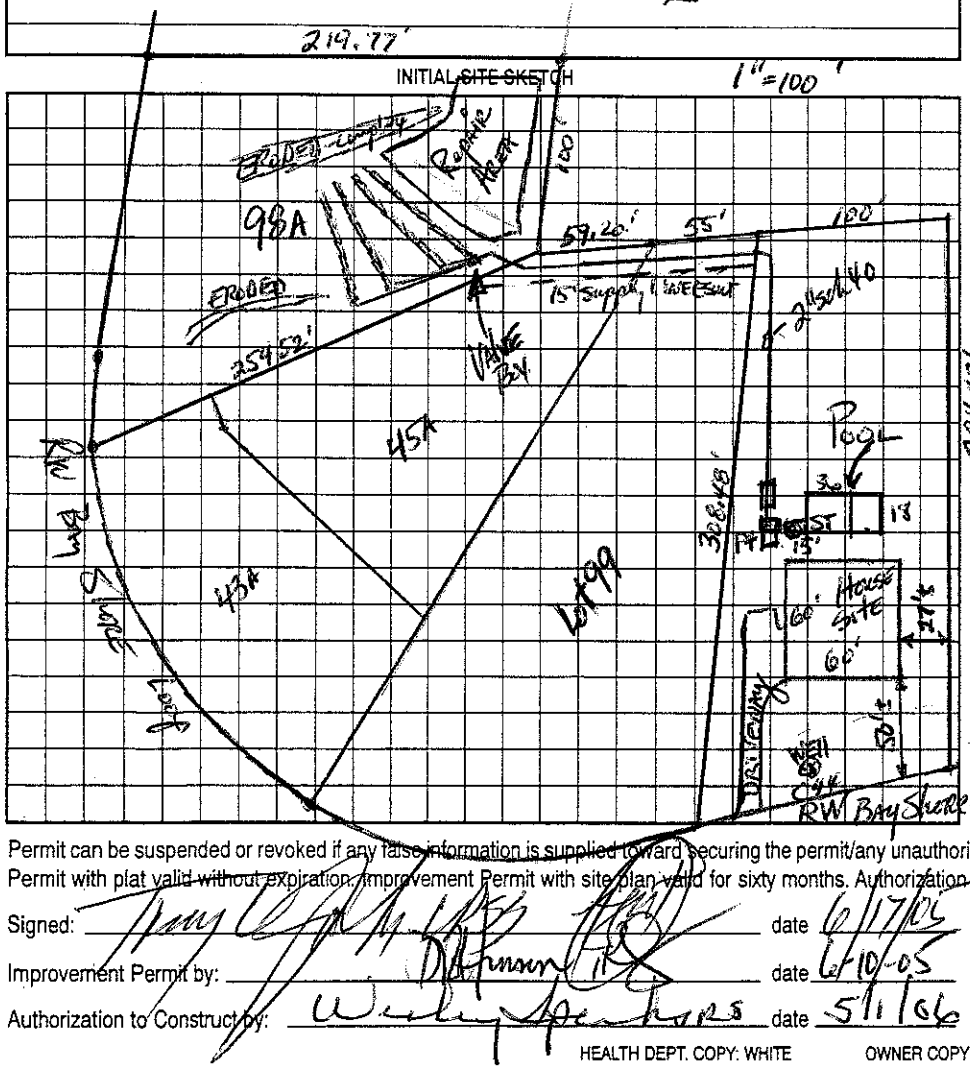

AS BUILT SKETCH

The proposed / existing Pool addition does not appear to impact the existing septic system.

**NOTE: REHS

Date 8-16-10

ICHD-Environmental Health Division

Permit can be suspended or revoked if any false information is supplied toward securing the permit/any unauthorized changes are made to the site/any unauthorized changes are made in the installation of the system. Improvement Permit with plat valid without expiration. Improvement Permit with site plan valid for sixty months. Authorization to Construct is valid for a period equal to that of Improvement Permit – not to exceed sixty months.

Signed: date 6/17/05 Installed by: Richard Abernathy

Improvement Permit by: date 6-10-05 Operation Permit by: date 5-5-07

Authorization to Construct by: date 5/1/06 Existing System Inspection by: date

HEALTH DEPT. COPY: WHITE OWNER COPY (FINAL): YELLOW OWNER COPY (INITIAL): PINK