[illegible] COUNTY DEPARTMENT STATESVILLE 704-878-5305 MOORESVILLE 704-664-5281

IMPROVEMENT PERMIT / AUTHORIZATION TO CONSTRUCT / OPERATION PERMIT / EXISTING SYSTEM INSPECTION

PERMIT # 125338 PIN # 4639622565 1 DATE 1-4-2011

OWNER or APPLICANT Bruce Ingwall PHONE: Business 9807229186 Home: Curt 7046345823

OWNER or APPLICANT ADDRESS 157-B J Hoyston Rd Troutman, NC 28166

LOCATION / DIRECTIONS Perth Rd N TL Liva Ln TR Bay Crossing TL 1st Bay Shore Lp on Rt #176

SUBDIVISION Bay Crossing BLOCK / SECTION 2 LOT # 19 LOT AREA 1.95Ac DESIGN FLOW 360gpd L.T.A.R. .25

Septic Tank 1500 Gallons: STB 338 Date 11-29-10 ☒ New System ☐ Repair ☐ Expansion System Type I II III IV V VI

Pump Tank 1500 Gallons: PT 477 Date 10-20-10 System Description: LP - 25% Reduction

Pump Make Geo Jet Model WEC712HU Serial # 5591016748 Repair System Description: LP Panel Block

Nitrification Field No Fields 1 No Lines 8 Linear Feet 600 Maintenance Agreement Required ☒ YES ☐ NO

Trench Width 36" Max. Trench Bottom Depth 36" Gravel Depth N/A ☐ GRAVITY ☒ PRESSURE


☒ Residence No. Bedrooms 5 ☐ Business No. Persons ☐ Other No. Employees ☐ Slab ☐ Crawl Space ☐ Basement w/plumbing ☐ Basement w/o plumbing

Water Supply ☒ Private Already Installed ☐ Public ☐ Community


Comments / Conditions: Drill one hole (either 3/16" or 5/32") per Plastic Chamber Segment. (Every 4ft for "Quicky" or every 5ft for "ADS 36" or EZ Flow)

Comments / Conditions: Install Drainlines on Contour, Do Not install Drainfield any closer to house. Then as shown. Must keep Drainfield 100ft from well. ☒ Use in line filter in PT (Turn for 2 holes per lateral down to facilitate draining.

INITIAL SITE SKETCH

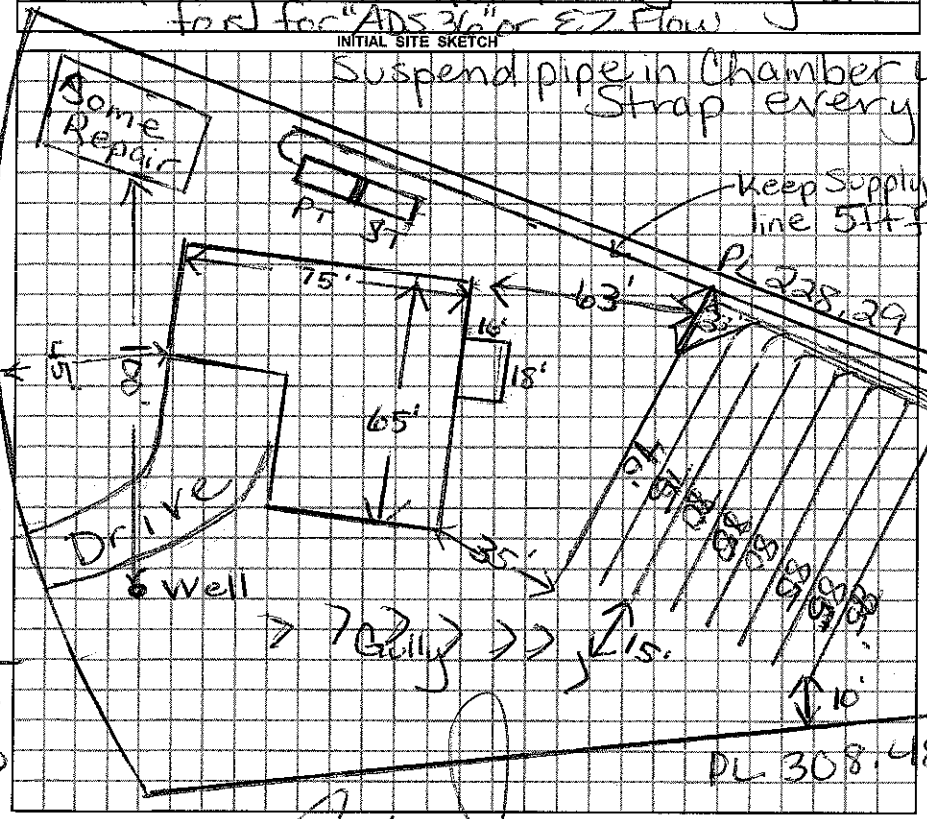

AS BUILT SKETCH

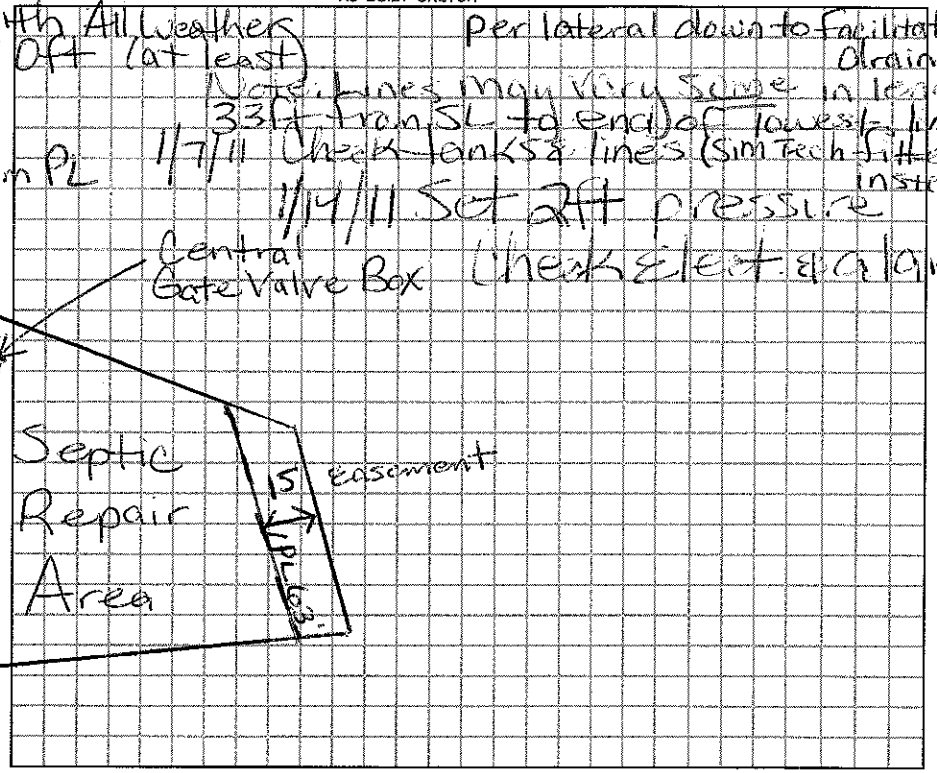

Permit can be suspended or revoked if any false information is supplied toward securing the permit / any unauthorized changes are made to the site / any unauthorized changes are made in the installation of the system.

☐ *IMPROVEMENT PERMIT w / plat valid without expiration* ☐ *IMPROVEMENT PERMIT w / site plan valid for 60 mos.* ☐ *AUTHORIZATION TO CONSTRUCT valid for period equal to IMPROVEMENT PERMIT-not to exceed 60 mo.*

Owner / Applicant Signature: [signature] Date 1-4-11

Improvement Permit by: [signature] REHS Date 1/4/2011

Authorization to Construct by: [signature] REHS Date 1/4/2011

YOU SHOULD CONTACT A LOCATOR SERVICE PRIOR TO ANY EXCAVATION.

Installed by: Curt Dunning RS

Operation Permit by: [signature] Date: 6/17/2011

Existing System Inspected by: _____ Date: _____

WHITE COPY Environmental Health YELLOW COPY (Final) Owner / Applicant PINK COPY (Initial) Owner / Applicant