REDELL COUNTY HEALTH DEPARTMENT

STATESVILLE 704-878-5305 MOORESVILLE 704-664-5281

MPROVEMENT PERMIT / AUTHORIZATION TO CONSTRUCT / OPERATION PERMIT / EXISTING SYSTEM INSPECTION

RMIT# 125338 PIN# 4639-61-5556.099 DATE May 27 05

WNER OR CONTRACTOR Heidt Properties Inc. PHONE: Business Home

DDRESS 805 N. Hwy 16 Denver N.C. 28037

OCATION Forbes Rd (N) TL Lilla Lane TR Bay Crossing Dr. TL 1st Bay Shore Loop on Right

UBDIVISION Bay Crossing BLOCK / SECTION LOT 99 LOT AREA .196AC SITE CLASS PS DESIGN FLOW 480gpd L.T.A.R. .25

eptic Tank: 1000 Gallons: ST# Date

ump Tank: 1000 Gallons: PT Date

ump Make: Model Serial No.

itrification Field: No Fields 1 Square Feet 1440 Linear Feet 480

lo Lines 6 @ 80' Trench Width 36" Max Trench Bottom Depth 36" Gravel Depth N/A

☒ New System ☐ Repair System Type: I. II. III. IV. V. VI

System Description: pumped sys. 25% Reduction

Repair System Description: Similar to ABOVE

Maintenance Agreement Required: ☐ Yes ☒ No

☒ House/Mod. Home No. Bedrooms 4

☐ Mobile Home No. Bathrooms

☐ Business No. Employees

☐ Other


☐ Slab ☒ Crawl Space ☐ Basement w/plumbing ☐ Basement wo/plumbing

Water Supply: ☒ Individual ☐ Public ☐ Community

omments:/Conditions:


SFE 43A

INITIAL SITE SKETCH 1"=50'

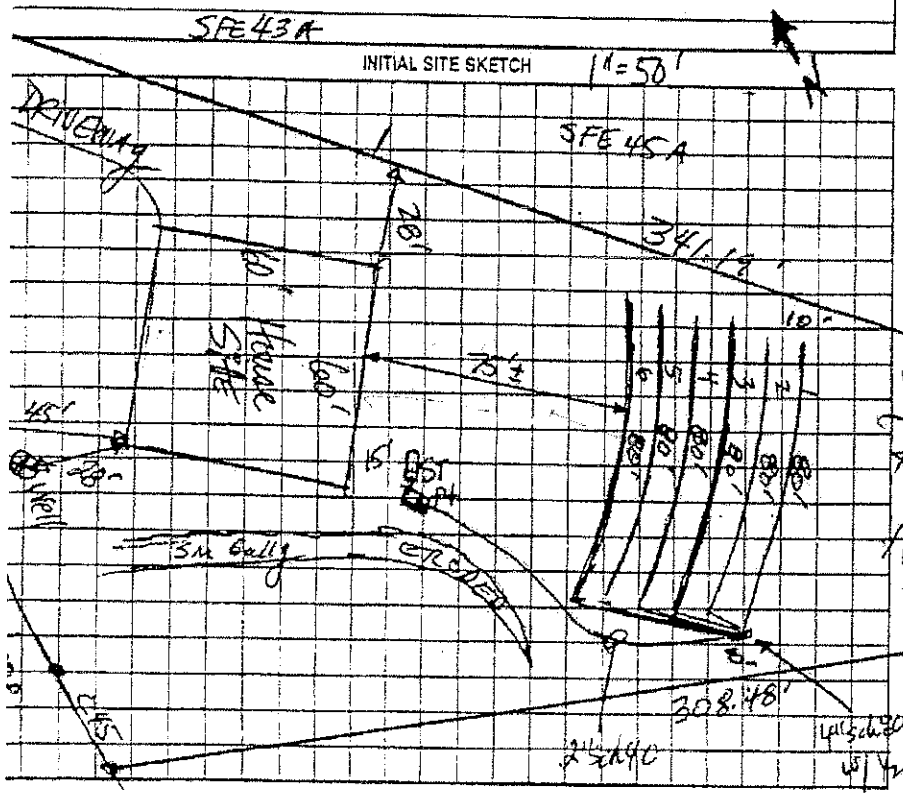

Comments:/Conditions:

AS BUILT SKETCH

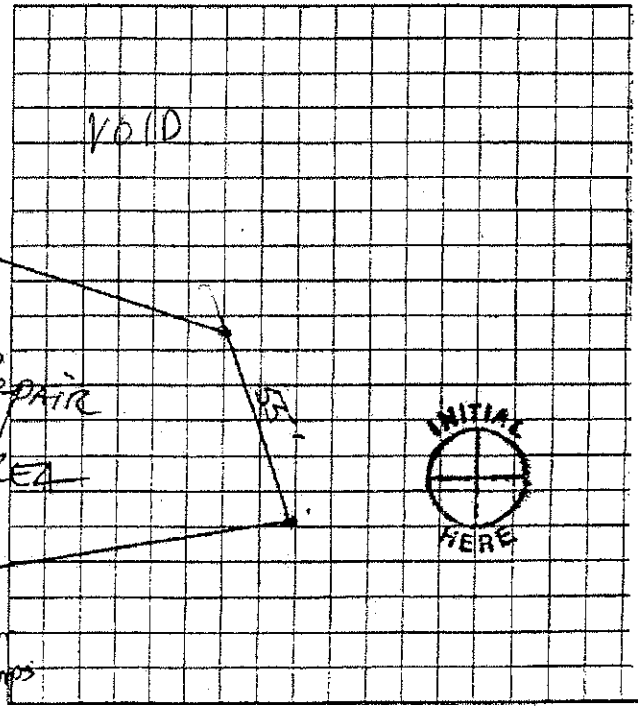

Improvement Permit Only - Do not Issue Building Permit

rmit can be suspended or revoked if any false information is supplied toward securing the permit/any unauthorized changes are made to the site/any unauthorized changes are made in the installation of the system. Improvement rmit with plot valid without expiration. Improvement Permit with site plan valid for sixty months. Authorization to Construct is valid for a period equal to that of Improvement Permit – not to exceed sixty months.

gned: date 6/1/05 Installed by:

provement Permit by: date 5-27-05 Operation Permit by: date

thorization to Construct by: date Existing System Inspection by: 2bd 600' Trench date

HEALTH DEPT COPY WHITE OWNER COPY (FINAL) YELLOW OWNER COPY (INITIAL) PINK

586 Foot line