IREDELL COUNTY HEALTH DEPARTMENT

STATESVILLE 704-878-5305 MOORESVILLE 704-664-5281

IMPROVEMENT PERMIT / AUTHORIZATION TO CONSTRUCT / OPERATION PERMIT / EXISTING SYSTEM INSPECTION

PERMIT# 121626 PIN# 4639615556.108 4639626262 DATE 2-14-05

OWNER OR CONTRACTOR William Lowell PHONE: Business (704) 488-7977 Home 6064-7001

ADDRESS

LOCATION Perth Rd N TL Liva Ln TR Bay Crossing TL Golden Bell @ End

SUBDIVISION Bay Crossing BLOCK / SECTION 1 LOT 108 LOT AREA .84 Acre SITE CLASS. PS DESIGN FLOW 480gpd L.T.A.R. .3

Septic Tank: 1000 Gallons; STB 444 Date 8-7-06
Pump Tank: 1000 Gallons; PT 29 Date 9-14-06
Pump Make: Gould Model G06DS Serial No. WE031M0
Nitrification Field: No Fields 1 Square Feet 1200' Linear Feet 400'
No Lines 4@100' Trench Width 36" Max Trench Bottom Depth 36" Gravel Depth N/A

☒ New System ☐ Repair System Type: I, II, III, IV, V, VI
System Description: Pump (Pm) 25% Reduction
Repair System Description: Pump (LP) Panel Blk
Maintenance Agreement Required: ☐ Yes ☒ No Not Initially


☒ House/Mod. Home No. Bedrooms 4
☐ Mobile Home No. Bathrooms 3
☐ Business No. Employees
☐ Other
☐ Slab ☒ Crawl Space ☐ Basement w/plumbing ☐ Basement wo/plumbing

Water Supply: ☒ Individual ☐ Public ☐ Community

Comments:/Conditions: Keep Septic System at least 10' to PL, 100' to well & 15' From Pool. Scale 1:50 PL 327

Comments:/Conditions: ☆ 11/3/06 Okay to put Pressure Manifold on other side

INITIAL SITE SKETCH

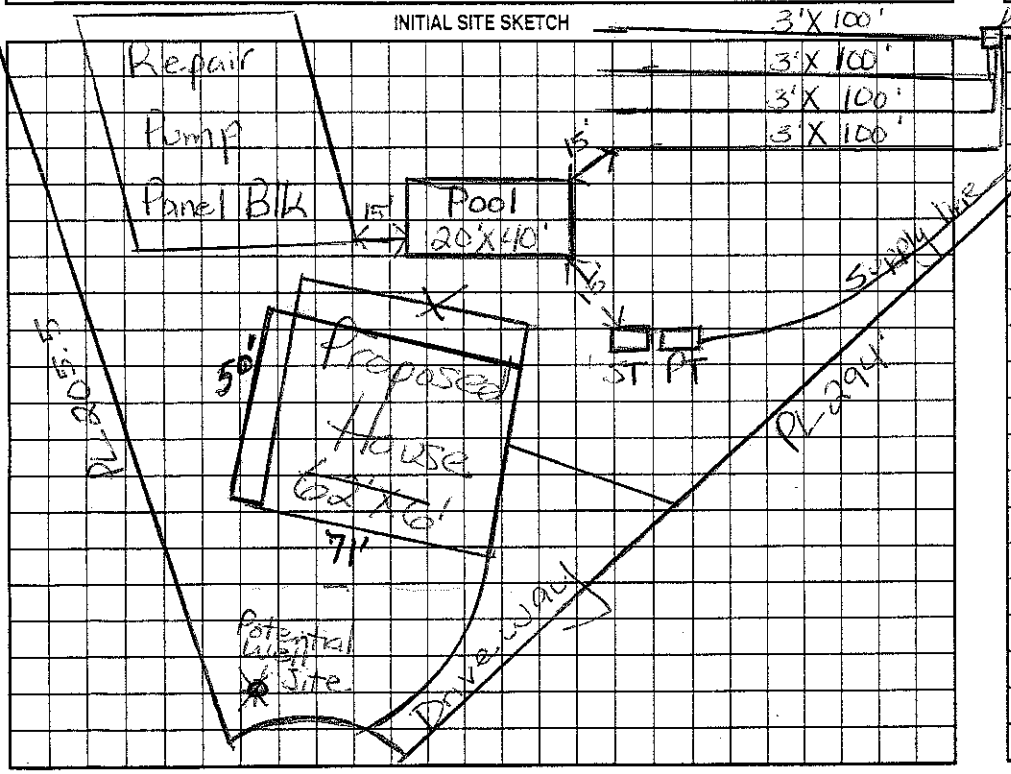

AS BUILT SKETCH

Permit can be suspended or revoked if any false information is supplied toward securing the permit/any unauthorized changes are made to the site/any unauthorized changes are made in the installation of the system. Improvement Permit with plat valid without expiration. Improvement Permit with site plan valid for sixty months. Authorization to Construct is valid for a period equal to that of Improvement Permit – not to exceed sixty months.

Signed: William Lowell date 2/15/05 Installed by: Orbison

Improvement Permit by: Maria Hill Dotson RS date 2/14/05 Operation Permit by: Joseph E. Allen date 11/6/06

Authorization to Construct by: Maria Hill Dotson RS date 2/14/05 Existing System Inspection by: date

HEALTH DEPT. COPY: WHITE OWNER COPY (FINAL): YELLOW OWNER COPY (INITIAL): PINK