IREDELL COUNTY HEALTH DEPARTMENT

STATESVILLE 704-8[illegible]5 MOORESVILLE 704-664-5281

IMPROVEMENT PERMIT / AUTHORIZATION TO CONSTRUCT / OPERA[illegible] PERMIT / EXISTING SYSTEM INSPECTION

PERMIT# 121503 PIN# 4639961 5556.111 4639-62-7050 DATE 4/12/05

OWNER OR CONTRACTOR SCHREINER DEV PHONE: Business 483-3651 Home

ADDRESS 555 N HWY 16 DENVER NC 28037

LOCATION PERTH (N) - T L LIVALN - TR BAYCROSSING - ON LT CORNER OF GOLDEN BELL

SUBDIVISION BAYCROSSING BLOCK / SECTION 1 LOT 111 LOT AREA .704C SITE CLASS. PS DESIGN FLOW 450GPD L.T.A.R. .256-PO/PE

Septic Tank: 1000/1500 Gallons; STB 338 Date 4-8-05
Pump Tank: 1000 Gallons; PT 27 Date 4-13-05
Pump Make: Model Serial No.
Nitrification Field: No Fields 1 Square Feet 660 Linear Feet 330
No Lines 4 Trench Width 24" Max Trench Bottom Depth 36" Gravel Depth N/A

☑ New System ☐ Repair System Type: I, II, III, (IV), V, VI
System Description: LP PANEL
Repair System Description: SAME
Maintenance Agreement Required: ☑ Yes ☐ No

☐ House/Mod. Home No. Bedrooms 4
☐ Mobile Home No. Bathrooms 4
☐ Business No. Employees
☐ Other
☐ Slab ☑ Crawl Space ☐ Basement w/plumbing ☐ Basement wo/plumbing


Water Supply: ☐ Individual ☐ Public ☐ Community

Comments:/Conditions:


1"=50'

Comments:/Conditions: tanks & lines 5/24/05
Pres, Elect & alarm 5/27/05

INITIAL SITE SKETCH

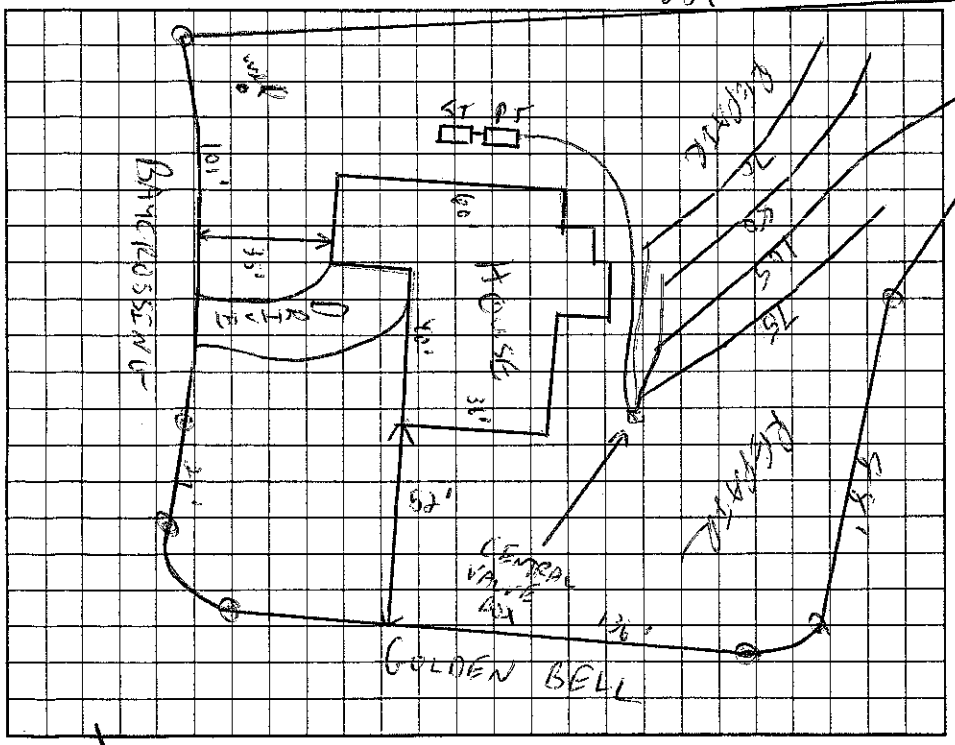

AS BUILT SKETCH UNMETERED

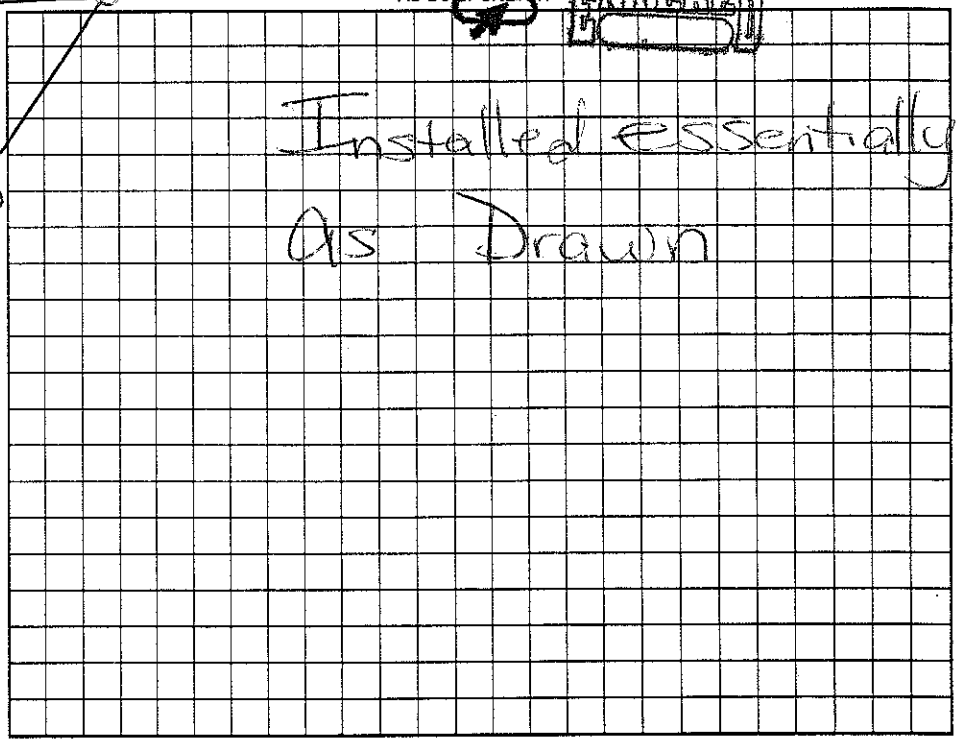

Permit can be suspended or revoked if any false information is supplied toward securing the permit/any unauthorized changes are made to the site/any unauthorized changes are made in the installation of the system. Improvement Permit with plat valid without expiration. Improvement Permit with site plan valid for sixty months. Authorization to Construct is valid for a period equal to that of Improvement Permit – not to exceed sixty months.

Signed: [signature] date 4/13/05

Improvement Permit by: [signature] RS date 4/12/05

Authorization to Construct by: [signature] RS date 4/12/05

Installed by: R&T Deaton RS

Operation Permit by: [signature] date 5/27/05

Existing System Inspection by: date

HEALTH DEPT. COPY: WHITE OWNER COPY (FINAL): YELLOW OWNER COPY (INITIAL): PINK

IREDELL COUNTY HEALTH DEPARTMENT

STATESVILLE 704-878-5305 MOORESVILLE 704-664-5281

IMPROVEMENT PERMIT / AUTHORIZATION TO CONSTRUCT / OPERATION PERMIT / EXISTING SYSTEM INSPECTIO

PERMIT# 12-1503 PIN# 4639 61-5556. 111 DATE 11/10/04

OWNER OR CONTRACTOR HEGHT PROPERTIES / SCHREINER DEV. PHONE: Business 453-3651 Home

ADDRESS 585 (N) HWY 16 DENVER NC 28037

LOCATION PORTA (N) - TL LINA LN - TL BAYCROSSING - ON LT CORNER OF GOLDEN BELL

SUBDIVISION BAYCROSSING BLOCK / SECTION 1 LOT 111 LOT AREA 1.7 AC SITE CLASS. CS DESIGN FLOW 480 GPD L.T.A.R. .267 GAL/SF

Septic Tank: 1000 Gallons; STB Date

Pump Tank: 1000 Gallons; PT Date

Pump Make: Model Serial No.

Nitrification Field: No Fields 1 Square Feet 600 Linear Feet 300

No Lines 3@100' Trench Width 24" Max Trench Bottom Depth 36" Gravel Depth N/A

☑ New System ☐ Repair System Type: I, II, III, IV, V, VI

System Description: LPP PANEL

Repair System Description: SAME

Maintenance Agreement Required: ☑ Yes ☐ No

☑ House/Mod. Home No. Bedrooms 4

☐ Mobile Home No. Bathrooms 4

☐ Business No. Employees

☐ Other


☐ Slab ☑ Crawl Space ☐ Basement w/plumbing ☐ Basement wo/plumbing

Water Supply: ☑ Individual ☐ Public ☐ Community


Comments:/Conditions:

Comments:/Conditions:

INITIAL SITE SKETCH 1" = 50'

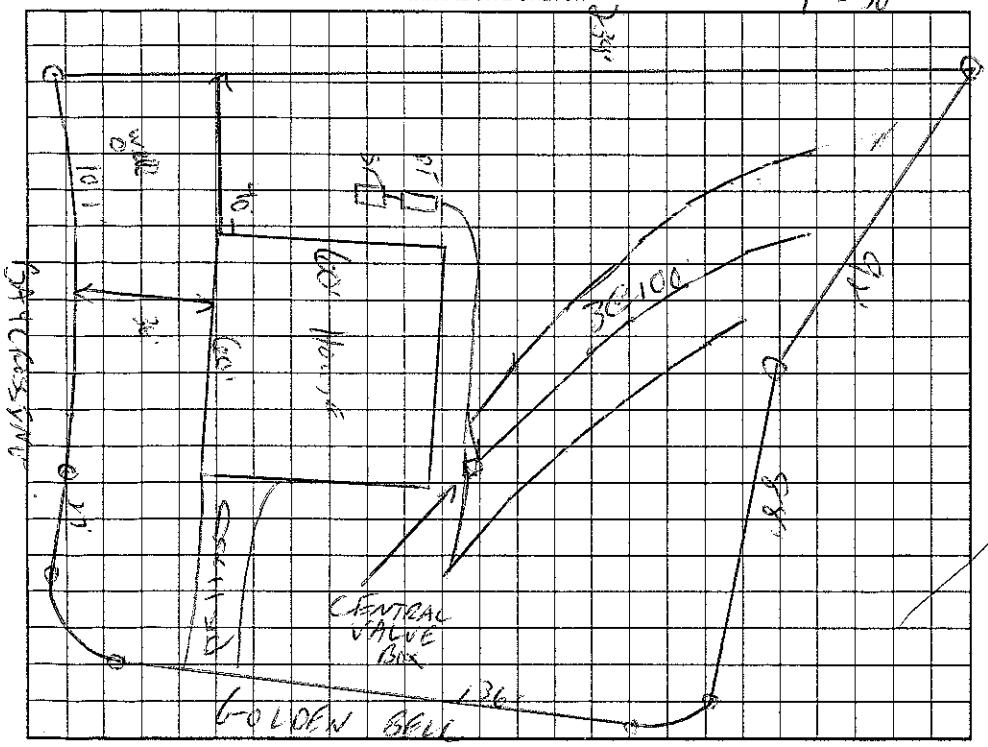

AS BUILT SKETCH

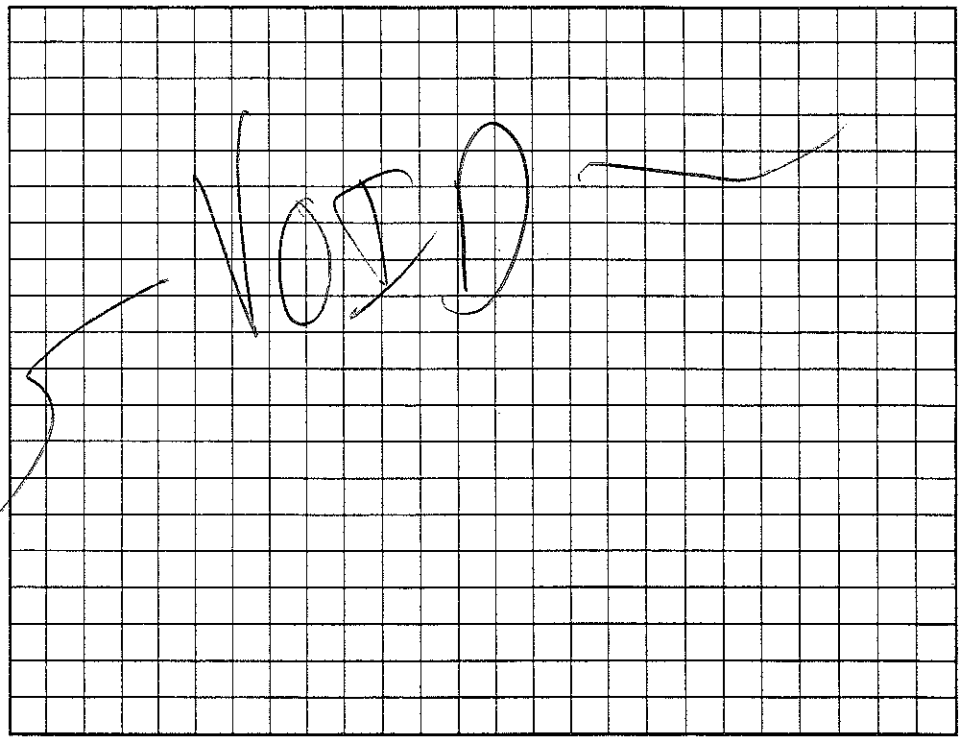

Permit can be suspended or revoked if any false information is supplied toward securing the permit/any unauthorized changes are made to the site/any unauthorized changes are made in the installation of the system. Improvement Permit with plat valid without expiration. Improvement Permit with site plan valid for sixty months. Authorization to Construct is valid for a period equal to that of Improvement Permit – not to exceed sixty months.

Signed: date 11-22-04 Installed by:

Improvement Permit by: RS date 11/10/04 Operation Permit by: date

Authorization to Construct by: RS date 11/10/05 Existing System Inspection by: date

HEALTH DEPT. COPY: WHITE OWNER COPY (FINAL): YELLOW OWNER COPY (INITIAL): PINK

IREDELL COUNTY HEALTH DEPARTMENT

STATESVILLE 704-878-5305 MOORESVILLE 704-664-5281

IMPROVEMENT PERMIT / AUTHORIZATION TO CONSTRUCT / OPERATION PERMIT / EXISTING SYSTEM INSPECTI

PERMIT# 12503 PIN# 4639 61 7456.111 DATE 11/10/01

OWNER OR CONTRACTOR WIGHT [illegible] SCHNITZER P.V. PHONE: Business 453-3651 Home

ADDRESS 845 CN HWY 16 MOORESVILLE 28117

LOCATION I-77 (N) TL LIM LN TO [illegible] V OF [illegible]

SUBDIVISION [illegible] BLOCK / SECTION 1 LOT 111 LOT AREA [illegible] SITE CLASS. 05 DESIGN FLOW [illegible] L.T.A.R. [illegible]

Septic Tank: 1000 Gallons: STS Date

Pump Tank: 1000 Gallons: PT Date

Pump Make: Model Serial No.

Nitrification Field: No Fields 1 Square Feet 600 Linear Feet 300

No Lines 5 @ 100 Trench Width: 24" Max Trench Bottom Depth: 36" Grave Depth N/A

☒ New System ☐ Repair System Type: ☐ I ☐ II ☒ IV ☐ VI

System Description: [illegible]

Repair System Description:

Maintenance Agreement Required: ☒ Yes ☐ No

☒ House/Mod. Home No. Bedrooms 4

☐ Mobile Home No. Bathrooms 4

☐ Business No. Employees

☐ Other

☐ Slab ☒ Crawl Space ☐ Basement w/plumbing ☐ Basement wo/plumbing

Water Supply: ☒ Individual ☐ Public ☐ Community


Comments/Conditions:

Who to set tanks

MSL and

Comments/Conditions:

INITAL SITE SKETCH 1" = 50'

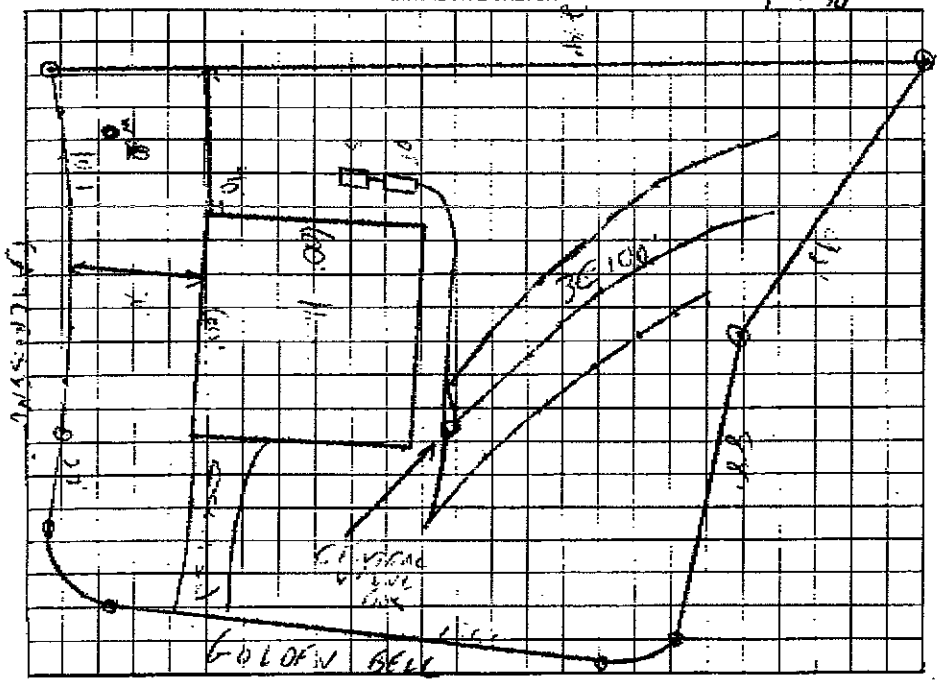

AS BUILT SKETCH

Permit can be suspended or revoked if any false information is supplied toward securing the permit/any unauthorized changes are made to the site/any unauthorized changes are made in the installation of the system. Improvement Permit with plat valid without expiration; Improvement Permit with site plan valid for sixty months. Authorization to Construct is valid for a period equal to that of Improvement Permit – not to exceed sixty months.

Signed: [signature] date 11-22-01 Installed by:

Improvement Permit by: [signature] date 11/10/01 Operation Permit by: date

Authorization to Construct by: [signature] date 11/10/01 Existing System Inspection by: date

HEALTH DEPT. COPY: WHITE OWNER COPY (FINAL): YELLOW OWNER COPY (INITIAL): PINK

7046558995

APR 08,2005 16:12