IREDELL COUNTY HEALTH DEPARTMENT

STATESVILLE 704-8 5 MOORESVILLE 704-664-5281

IMPROVEMENT PERMIT / AUTHORIZATION TO CONSTRUCT / OPERA... PERMIT / EXISTING SYSTEM INSPECTION

PERMIT# 121503 PIN# 4639615556.111 4639-62-7050 DATE 4/12/05

OWNER OR CONTRACTOR SCHREINER DEV. PHONE: Business 483-3651 Home

ADDRESS 885 N HWY 16 DENVER NC 28037

LOCATION PERTH (N) - T L LIVA LN - TR BAYCROSSING - ON LT CORNER OF GOLDEN BELL

SUBDIVISION BAYCROSSING BLOCK / SECTION 1 LOT 111 LOT AREA .704 SITE CLASS. PS DESIGN FLOW 450GPD L.T.A.R. .256-80/120

Septic Tank: 1000/1500 Gallons; STB 338 Date 4-8-05
Pump Tank: 1000 Gallons; PT 27 Date 4-13-05
Pump Make: Model Serial No.
Nitrification Field: No Fields 1 Square Feet 660 Linear Feet 330
No Lines 4 Trench Width 24" Max Trench Bottom Depth 36" Gravel Depth N/A

☑ New System ☐ Repair System Type: I, II, III, (IV), V, VI
System Description: LP PANEL
Repair System Description: SAME
Maintenance Agreement Required: ☑ Yes ☐ No

☐ House/Mod. Home No. Bedrooms 4
☐ Mobile Home No. Bathrooms 4
☐ Business No. Employees
☐ Other
☐ Slab ☑ Crawl Space ☐ Basement w/plumbing ☐ Basement wo/plumbing


Water Supply: ☐ Individual ☐ Public ☐ Community

Comments:/Conditions:

1"=50'

Comments:/Conditions: tanks & lines 5/24/05
Pres, Elect & alarm 5/27/05

INITIAL SITE SKETCH

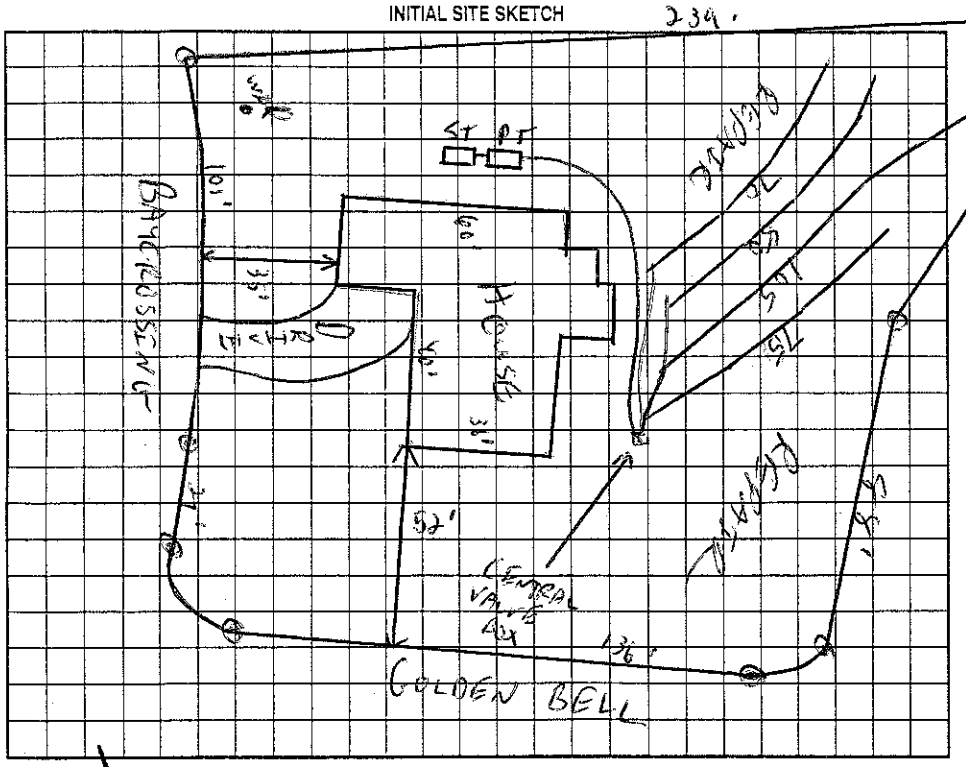

AS BUILT SKETCH

Installed essentially as Drawn

Permit can be suspended or revoked if any false information is supplied toward securing the permit/any unauthorized changes are made to the site/any unauthorized changes are made in the installation of the system. Improvement Permit with plat valid without expiration. Improvement Permit with site plan valid for sixty months. Authorization to Construct is valid for a period equal to that of Improvement Permit – not to exceed sixty months.

Signed: date 4/13/05
Improvement Permit by: RS date 4/12/05
Authorization to Construct by: RS date 4/12/05

Installed by: R&H date
Operation Permit by: date 5/27/05
Existing System Inspection by: date

HEALTH DEPT. COPY: WHITE OWNER COPY (FINAL): YELLOW OWNER COPY (INITIAL): PINK