IREDELL COUNTY HEALTH DEPARTMENT

STATESVILLE 704-878-5305 MOORESVILLE 704-664-5281

IMPROVEMENT PERMIT / AUTHORIZATION TO CONSTRUCT / OPERATION PERMIT / EXISTING SYSTEM INSPECTION

PERMIT# 121625 PIN# 4639615556.106 4639-62-8280 DATE 11/9/04

OWNER OR CONTRACTOR HECHT PROPERTIES / BRADLEY CUSTOM BUILDERS Phone: Business 453-3651 Home

ADDRESS 385 (N) HWY 16 DENVER NC 28037

LOCATION PERTH (S) - TR LIVA LN - TR BAYCROSSING - TL GOLDEN BELL ON RT

SUBDIVISION BAYCROSSING BLOCK / SECTION 1 LOT 106 LOT AREA .6 AC SITE CLASS PS DESIGN FLOW 4x060 L.T.A.R. .25 600 FT²

Septic Tank: 1500 Gallons; STB 338 Date 12/19/05
Pump Tank: 1000 Gallons; PT 27 Date 12/19/05
Pump Make: Model Serial No.
Nitrification Field: No Fields 1 Square Feet 640 Linear Feet 370
No Lines 3 Trench Width 24" Max Trench Bottom Depth 36" Gravel Depth N/A

☑ New System ☐ Repair System Type: I, II, III, (IV), V, VI
System Description: LP PANEL
Repair System Description: SAME
Maintenance Agreement Required: ☑ Yes ☐ No


☑ House/Mod. Home No. Bedrooms 4
☐ Mobile Home No. Bathrooms 4
☐ Business No. Employees
☐ Other
☐ Slab ☑ Crawl Space ☐ Basement w/plumbing ☐ Basement wo/plumbing

Water Supply: ☑ Individual ☐ Public ☐ Community

Comments:/Conditions:

Comments:/Conditions: Linear Valve Box

1"=50' INITIAL SITE SKETCH

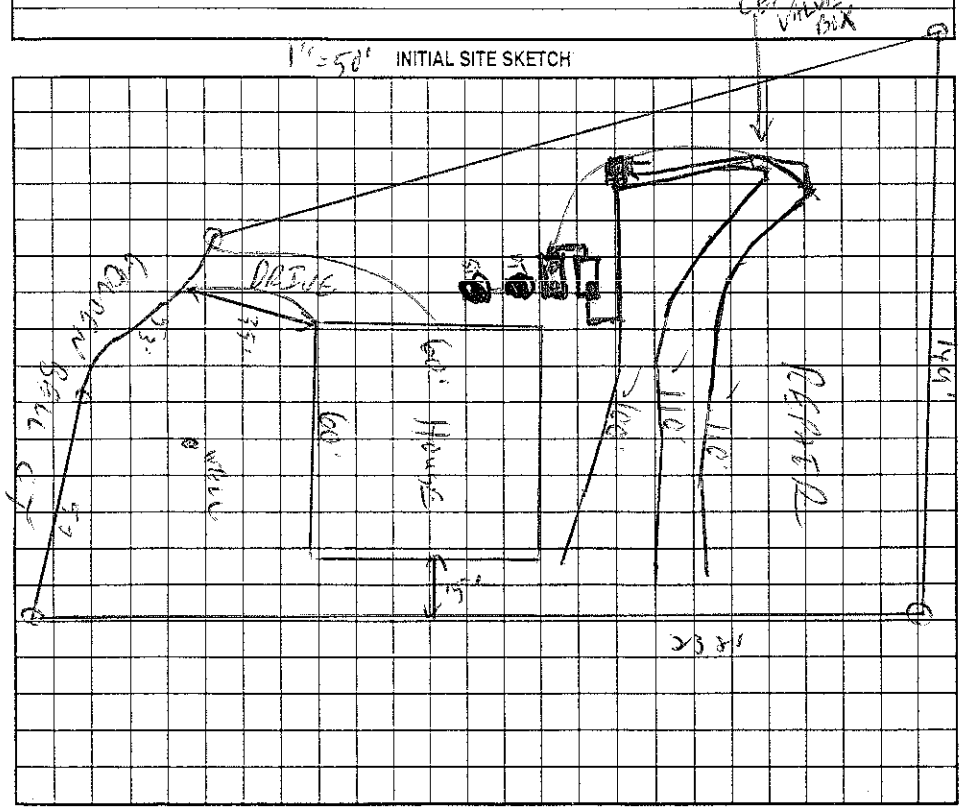

AS BUILT SKETCH

Permit can be suspended or revoked if any false information is supplied toward securing the permit/any unauthorized changes are made to the site/any unauthorized changes are made in the installation of the system. Improvement Permit with plan valid without expiration. Improvement Permit with site plan valid for sixty months. Authorization to Construct is valid for a period equal to that of Improvement Permit – not to exceed sixty months.

Signed: date 11-22-04

Improvement Permit by: date 11/9/04

Authorization to Construct by: Wesley Sparks RS. date 7/6/05

Installed by: Anderson & Sons

Operation Permit by: Wesley Sparks RS date 3/22/06

Existing System Inspection by: date

HEALTH DEPT. COPY: WHITE OWNER COPY (FINAL): YELLOW OWNER COPY (INITIAL): PINK