IREDELL COUNTY HEALTH DEPARTMENT

STATESVILLE 704-878-5305 MOORESVILLE 704-664-5281

IMPROVEMENT PERMIT / AUTHORIZATION TO CONSTRUCT / OPERATION PERMIT / EXISTING SYSTEM INSPECTION

PERMIT# 25287 PIN# 4639-61-5356.049 4639-62-8869 DATE June 10, 05

OWNER OR CONTRACTOR Heart Properties Inc. / JD North Construction PHONE: Business Home

ADDRESS 885 N. Hwy 16 Denver N.C. 28037

LOCATION Peeled N TL Lina Lane TR Bay Crossing DR to end TL Bay Shore Loop on Right

SUBDIVISION Bay Crossing BLOCK / SECTION LOT 49 LOT AREA .71AC SITE CLASS. RS DESIGN FLOW 440gpd L.T.A.R. .3

Septic Tank: 1000 Gallons; STB Date

Pump Tank: 1000 Gallons; PT Date

Pump Make: Myers Model MW450 Serial No. 25325D009

Nitrification Field: No. Fields 1 Square Feet 540/810 Linear Feet 220

No Lines 4 Trench Width 24" MIN/36" MAX Max Trench Bottom Depth 36" Gravel Depth N/A

☒ New System ☐ Repair System Type: I, II, III, IV, V, VI

System Description: LPPPBPS

Repair System Description: LPPPBPS on 49A

Maintenance Agreement Required: ☒ Yes ☐ No

☒ House/Mod. Home No. Bedrooms 4

☐ Mobile Home No. Bathrooms

☐ Business No. Employees

☐ Other

☐ Slab ☐ Crawl Space ☒ Basement w/plumbing ☐ Basement wo/plumbing

Water Supply: ☒ Individual ☐ Public ☐ Community


Comments:/Conditions: OR=36" MAX 90C

1/23/06 Reviewed Building plan & Siteplan, essentially in Compliance with I.P.


Comments:/Conditions:

1,500 Gal Tanks Installed

1"=50' INITIAL SITE SKETCH

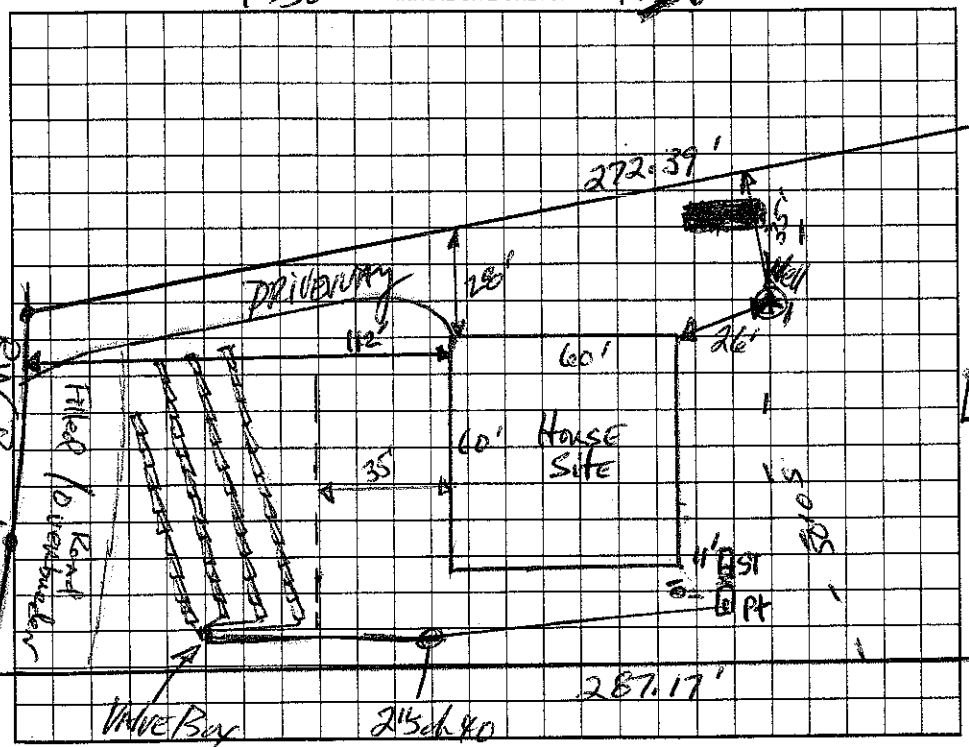

AS BUILT SKETCH

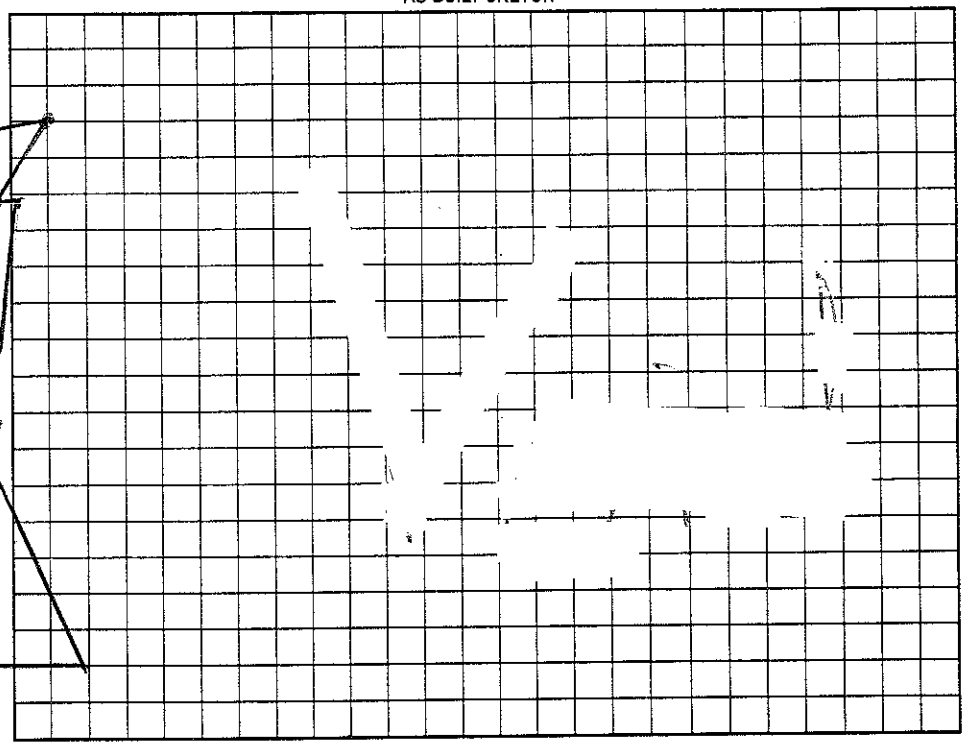

Permit can be suspended or revoked if any false information is supplied toward securing the permit/any unauthorized changes are made to the site/any unauthorized changes are made in the installation of the system. Improvement Permit with plat valid without expiration. Improvement Permit with site plan valid for sixty months. Authorization to Construct is valid for a period equal to that of Improvement Permit – not to exceed sixty months.

Signed: date 6/17/05

Improvement Permit by: date 6-10-05

Authorization to Construct by: RS date 1/23/06

Installed by: Specialty Septic (Jamie O'Daniel)

Operation Permit by: date 1/26/07

Existing System Inspection by: date

HEALTH DEPT. COPY: WHITE OWNER COPY (FINAL): YELLOW OWNER COPY (INITIAL): PINK