$150

IREDELL COUNTY HEALTH DEPARTMENT

STATESVILLE 704-878-5305 MOORESVILLE 704-664-5281

IMPROVEMENT PERMIT / AUTHORIZATION TO CONSTRUCT / OPERATION PERMIT / EXISTING SYSTEM INSPECTION

PERMIT# 122540 PIN# ~~4639104034.000~~ 4639630388.000 DATE 7-19-07

OWNER OR APPLICANT Hopkins & Hopkins PHONE: Business _____ Home 309-1323

ADDRESS P.O. Box 682 Huntersville NC

LOCATION Perth Rd North to Fern Hill TL Northington Woods on right #198

SUBDIVISION Northington Woods BLOCK / SECTION _____ LOT 18 LOT AREA 1.022 Acre SITE CLASS. RS DESIGN FLOW 360 gpd L.T.A.R. .3

Septic Tank: 1000 Gallons: STB 794 Date 1-6-07

Pump Tank: 1000 Gallons: PT 283 Date 2-22-07

Pump Make Little Giant Model 9EH Serial No. _____

Nitrification Field: No Fields 1 Square Feet 900' Linear Feet 300'

No Lines 3@100' Trench Width 36" Max Trench Bottom Depth 36"

☒ New System ☐ Repair ☐ Expansion System Type: I II III IV V VI

System Description: Pump-25% Reduction

Repair System Description: Pump-Panel Blk

Maintenance Agreement Required: ☐ Yes ☒ No

☒ House/Mod. Home No. Bedrooms 3

☐ Mobile Home No. Persons _____

☐ Business No. Employees _____


☐ Other _____

Water Supply: ☐ Individual ☑ Public ☐ Community

Gravel Depth N/A ☐ Gravity ☒ Pressure ☐ Slab ☒ Crawl Space ☐ Basement w/plumbing ☐ Basement wo/plumbing


Comments/Conditions: Note: This permit replaces previous permit from 8-31-06. Well installed in wrong spot therefore permit had to be redrawn for Lots 18 & 19

INITIAL SITE SKETCH

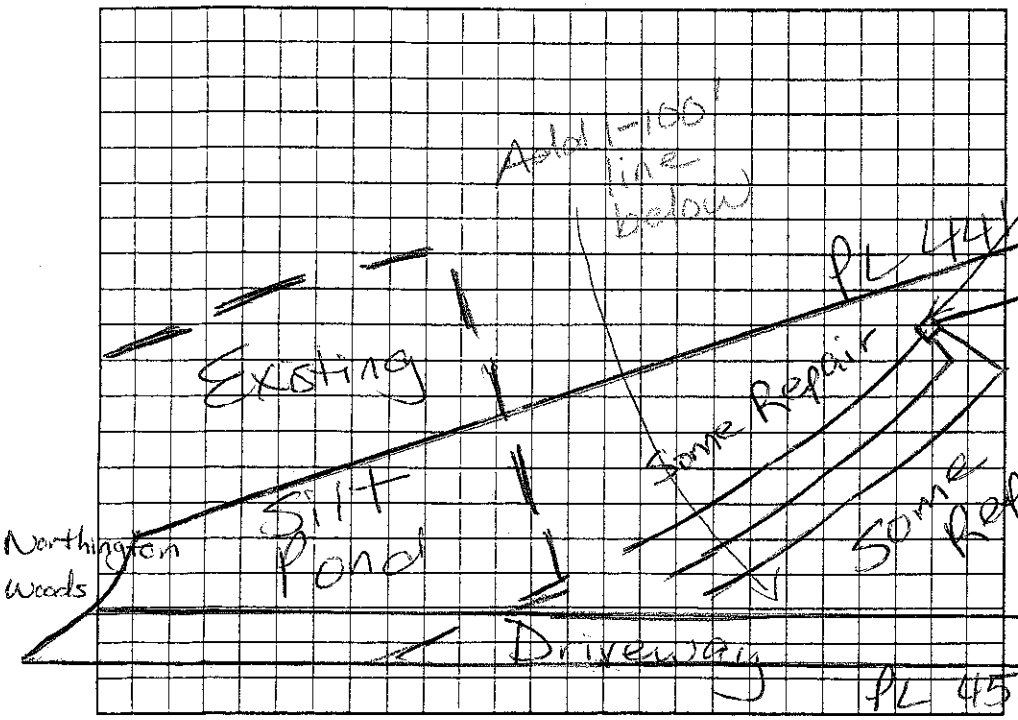

Comments/Conditions: Chalk where alarm wires enter alarm box
3/28/07 Checked tanks & lines
4/17/07 " " elect & pressure

AS BUILT SKETCH

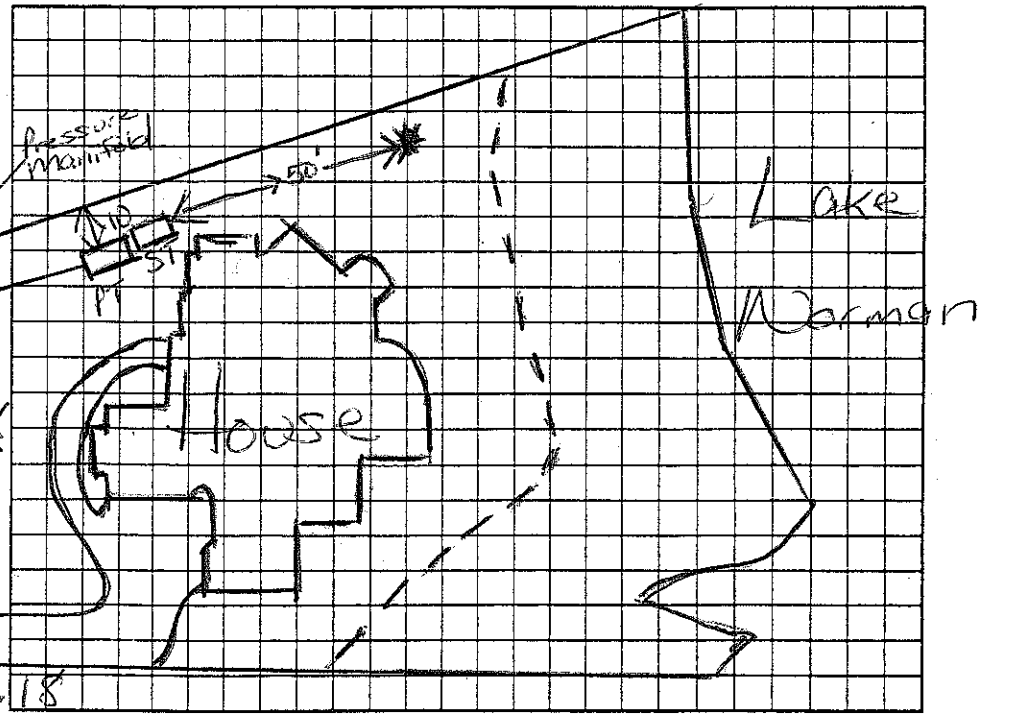

Permit can be suspended or revoked if any false information is supplied toward securing the permit/any unauthorized changes are made to the site/any unauthorized changes are made in the installation of the system. Improvement Permit with plat valid without expiration ☐ Improvement Permit with site plan valid for sixty months ☐ Authorization to Construct is valid for a period equal to that of Improvement Permit – not to exceed sixty months.

Signed: _____ date 6-13-07 Installed by: Larry Tucker Construction

Improvement Permit by: _____ date 7/19/07 Operation Permit by: _____ date 8/27/07

Authorization to Construct by: _____ date 7/19/07 Existing System Inspection by: _____ date _____

HEALTH DEPT. COPY: WHITE OWNER COPY (FINAL): YELLOW OWNER COPY (INITIAL): PINK

IREDELL COUNTY HEALTH DEPARTMENT

STATESVILLE 704-878-5305 MOORESVILLE 704-664-5281

IMPROVEMENT PERMIT / AUTHORIZATION TO CONSTRUCT / OPERATION PERMIT / EXISTING SYSTEM INSPECTION

PERMIT# 122546 PIN# 4639640340.018 DATE 8-31-06

OWNER OR APPLICANT Hopkins & Hopkins Jim PHONE: Business 875-0680 Home 309-1323

ADDRESS P.O. Box 682 Huntersville, NC

LOCATION Perth Rd North TL Fern Hill TL Northington Woods on right at end.

SUBDIVISION Northington Wds BLOCK / SECTION ____ LOT 18 LOT AREA 1.022 Acre SITE CLASS. PS DESIGN FLOW 360gpd T.A.R. .3

Septic Tank: 1000 Gallons: STB 794 Date 1-6-07
Pump Tank: 1000 Gallons: PT 283 Date 2-22-07
Pump Make: Little Giant Model TEH Serial No. ____
Nitrification Field: No Fields 1 Square Feet 900' Linear Feet 300'
No Lines 3@100' Trench Width 36" Max Trench Bottom Depth 36" Gravel Depth N/A

☒ New System ☐ Repair ☐ Expansion System Type: I II (III) IV V VI
System Description: Pump - 25% Reduction
Repair System Description: Pump - Panel Blk
Maintenance Agreement Required: ☐ Yes ☒ No Not Initially
☐ Gravity ☒ Pressure ☐ Slab ☐ Crawl Space ☐ Basement w/plumbing ☐ Basement wo/plumbing


☒ House/Mod. Home ☐ Mobile Home ☐ Business ☐ Other
No. Bedrooms 3 No. Persons ____ No. Employees ____

Water Supply: ☒ Individual ☐ Public ☐ Community


Comments/Conditions: ☆Note: Do not cut drive more than 2Ft down, Otherwise 15Ft setback to drainfield will be needed. Keep tanks at least 10' to PL & 50' to lake

Comments/Conditions: Keep any cut >2Ft at least 15Ft from Drainfield. Well must be at least 50Ft from any Septic System, 50 from lake & 25Ft from House.

INITIAL SITE SKETCH

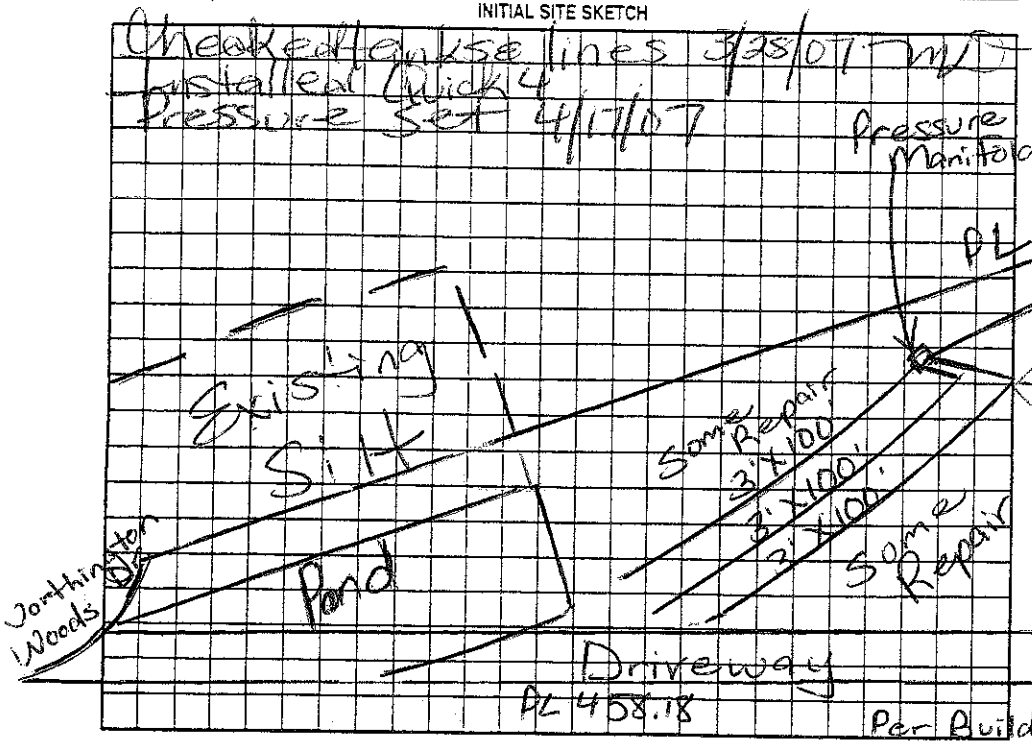

AS BUILT SKETCH

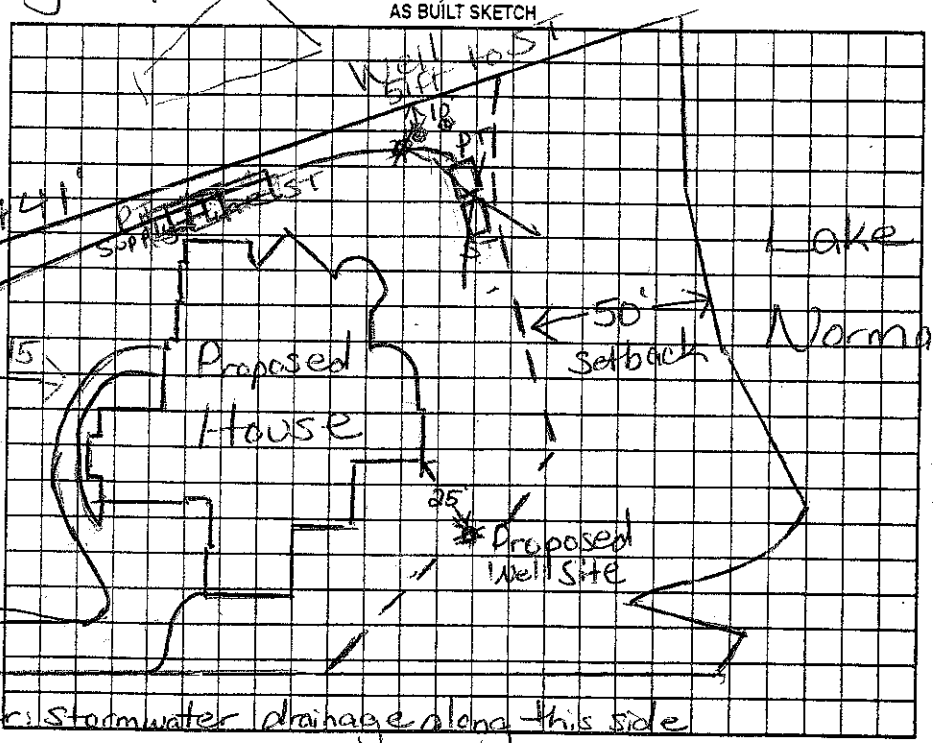

Permit can be suspended or revoked if any false information is supplied toward securing the permit/any unauthorized changes are made to the site/any unauthorized changes are made in the installation of the system. Improvement Permit with plat valid without expiration ☐ Improvement Permit with site plan valid for sixty months ☐ Authorization to Construct is valid for a period equal to that of Improvement Permit – not to exceed sixty months.

Signed: ____ date ____ Installed by: Larry Lucker Construction

Improvement Permit by: Maria H Nolan RS date 8/31/06 Operation Permit by: ____ date ____

Authorization to Construct by: Maria H Nolan RS date 8/31/06 Existing System Inspection by: ____ date ____

HEALTH DEPT. COPY: WHITE OWNER COPY (FINAL): YELLOW OWNER COPY (INITIAL): PINK