4639 64 0240

IREDELL COUNTY HEALTH DEPARTMENT

STATESVILLE 704-878-5305 MOORESVILLE 704-664-5281

IMPROVEMENT PERMIT / AUTHORIZATION TO CONSTRUCT / OPERATION PERMIT / EXISTING SYSTEM INSPEC

PERMIT# 124984 PIN# 4639-64-0340, 028 DATE Feb 24, 05

OWNER OR CONTRACTOR Shoemaker Dev. Group LLC / Mitch Cocan PHONE: Business Home

ADDRESS 1143 D. Executive Circle, Emey N.C. 27511

LOCATION Peeth Rd. N. TL FERN Hill Rd. TL Northington Woods Dr. TL Waterbury Dr immediately on Right

SUBDIVISION Northington Woods BLOCK / SECTION LOT 28 LOT AREA .90Ac SITE CLASS. PS DESIGN FLOW 480gpd L.T.A.R. .03

Septic Tank: 1000 Gallons; STB 1012 Date 3-10-07
Pump Tank: 1000 Gallons; PT 17 Date 5-4-07
Pump Make: Goulds Model Goulds PES1M Serial No. [illegible]
Nitrification Field: No Fields 1 Square Feet 540/810 Linear Feet 270
No Lines 4 Trench Width 24" min 36" max Max Trench Bottom Depth 36" Gravel Depth NA

☑ New System ☐ Repair System Type: I, II, III, ⓘ V, VI
System Description: LPPPBPS
Repair System Description: LPPPBPS
Maintenance Agreement Required: ☑ Yes ☐ No

☑ House/Mod. Home No. Bedrooms 4
☐ Mobile Home No. Bathrooms
☐ Business No. Employees
☐ Other
☐ Slab ☐ Crawl Space ☑ Basement w/plumbing ☐ Basement wo/plumbing


Water Supply: ☑ Individual ☐ Public ☐ Community

Comments:/Conditions: ≤ 36" max 90c
IN LINE filter and anti-syphon hole required in pumptank supply line


Comments:/Conditions: 11/17/06 Reviewed floor plans, essentially in compliance with original permit. Note: House is slightly deeper than original permit. Septic shall [illegible] still fit. Electrical checked 3/12/08 Maintenance agreement recd 9/21/07

1" = 50'

INITIAL SITE SKETCH

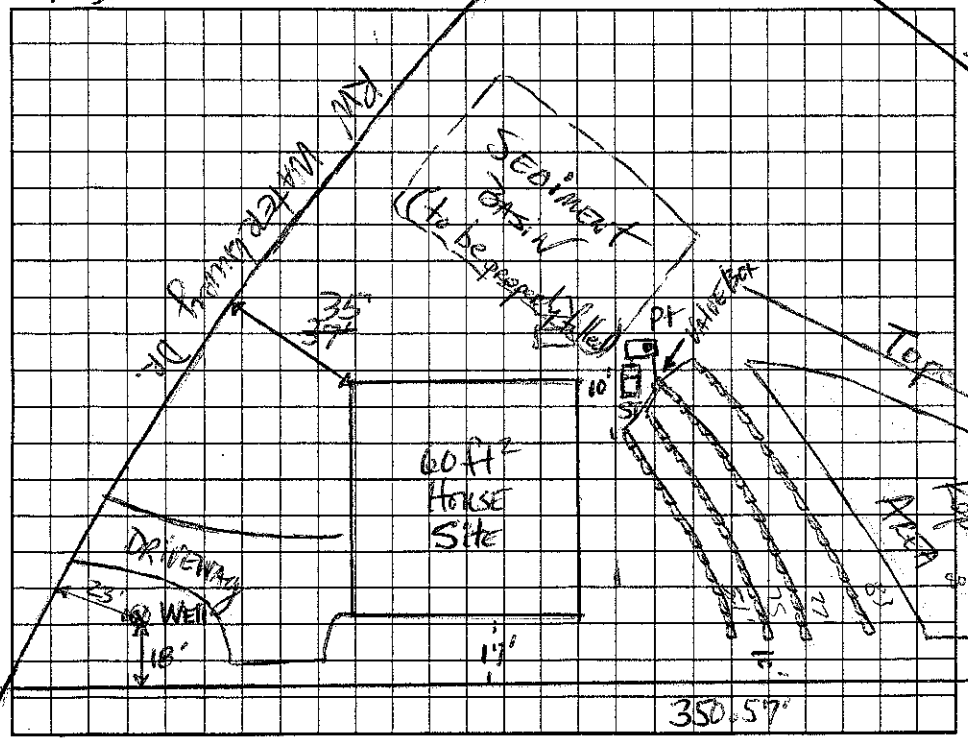

AS-BUILT SKETCH

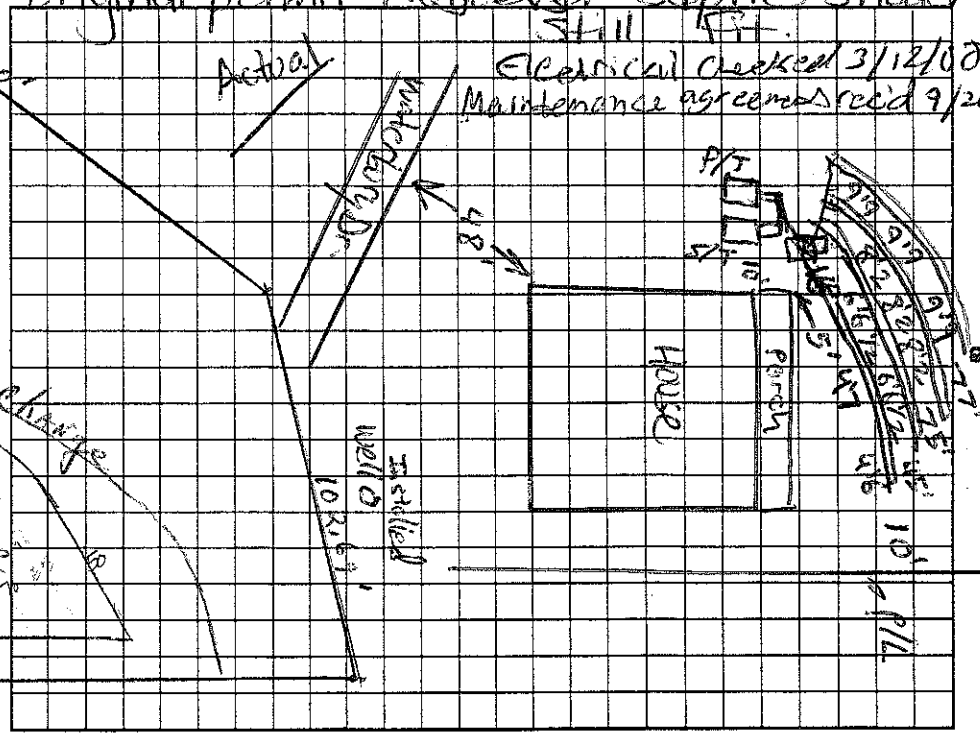

Permit can be suspended or revoked if any false information is supplied toward securing the permit/any unauthorized changes are made to the site/any unauthorized changes are made in the installation of the system. Improvement Permit with plat valid without expiration. Improvement Permit with site plan valid for sixty months. Authorization to Construct is valid for a period equal to that of Improvement Permit – not to exceed sixty months.

Signed: [signature] date 5/16/05 Installed by: Frye Grading

Improvement Permit by: [signature] RS date 2-24-05 Operation Permit by: Anthony Cocan Jr date 3/12/08

Authorization to Construct by: [signature] RS date 11/17/06 Existing System Inspection by: date

HEALTH DEPT. COPY: WHITE OWNER COPY (FINAL): YELLOW OWNER COPY (INITIAL): PINK