IREDELL COUNTY HEALTH DEPARTMENT

STATESVILLE 704-878-5305 MOORESVILLE 704-664-5281

IMPROVEMENT PERMIT / AUTHORIZATION TO CONSTRUCT / OPERATION PERMIT / EXISTING SYSTEM INSPECTION

PERMIT# 122578 PIN# ~~4639-64-0340.048~~ 4639-64-2897 DATE March 17, 05

OWNER OR CONTRACTOR Shoreline Dev. Group LLC PHONE: Business _____ Home _____

ADDRESS 1143 D. Executive Circle, Cany N.C. 27511

LOCATION Perth Rd. N. TL Fern Hill TL Northington Woods Dr. TL Wakefield Dr. TL Whispering Cove Ct. on Right

SUBDIVISION Northington Woods BLOCK / SECTION _____ LOT 48 LOT AREA ± .724 Ac SITE CLASS PS DESIGN FLOW 480gpd L.T.A.R. ± 3

Septic Tank: 1000 Gallons; STB 1012 Date 2-23-07
Pump Tank: _____ Gallons; PT _____ Date _____
Pump Make: _____ Model _____ Serial No. _____
Nitrification Field: No Fields 2 Square Feet 540/610 Linear Feet 270
No Lines 3+3 Trench Width 24" min 36" max Max Trench Bottom Depth 36"

☑ New System ☐ Repair System Type: I, II, (III), IV, V, VI
System Description: Gravity PPBPS (2 Sub Fields)
Repair System Description: LP PPBPS
Maintenance Agreement Required: ☐ Yes ☑ No

☑ House/Mod. Home No. Bedrooms 4
☐ Mobile Home No. Bathrooms ____
☐ Business No. Employees ____
☐ Other _____


Gravel Depth N/A ☐ Slab ☑ Crawl Space ☐ Basement w/plumbing ☐ Basement wo/plumbing

Water Supply: ☑ Individual ☐ Public ☐ Community


Comments/Conditions: ~~OP~~ 36" min 96"
* Due to Gas line ±6' from property line lines were installed 40' long with a D-box w/Flowlevelers w/ 1 added 35' line 270' Repair area still possible AC.

Comments/Conditions: Inspection of home shows plans altered to make due to 5 BR + Bonus Room, this was promised to be corrected by making open access no door way into bonus room. This must be verified as corrected b/f release/hold on OP.

INITIAL SITE SKETCH 1" = 50'

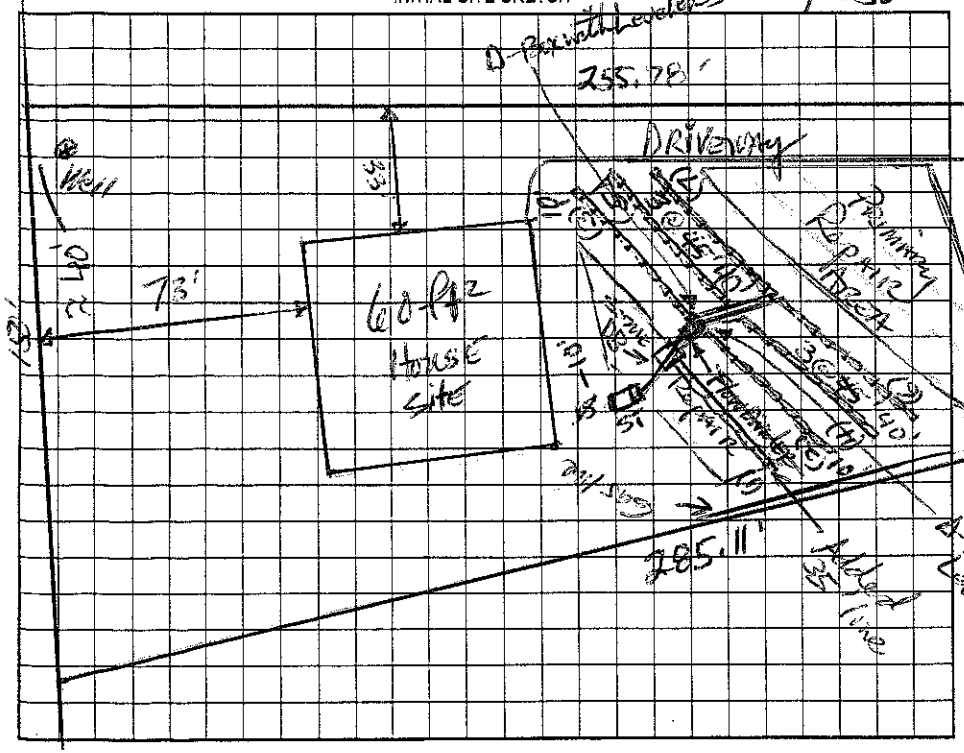

AS BUILT SKETCH

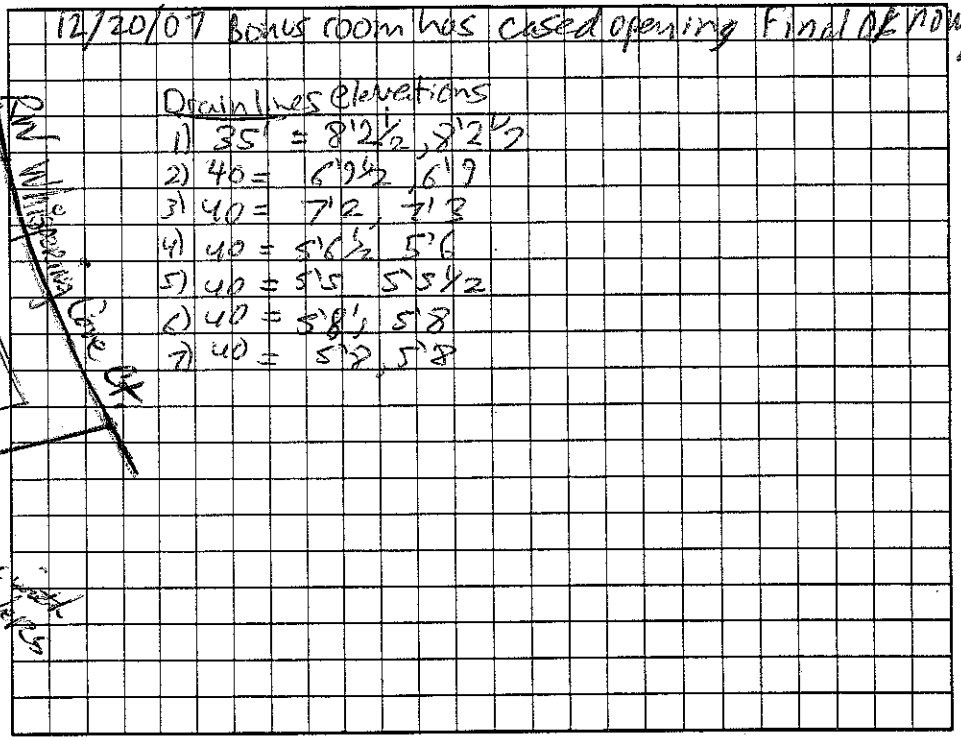

Permit can be suspended or revoked if any false information is supplied toward securing the permit/any unauthorized changes are made to the site/any unauthorized changes are made in the installation of the system. Improvement Permit with plat valid without expiration. Improvement Permit with site plan valid for sixty months. Authorization to Construct is valid for a period equal to that of Improvement Permit – not to exceed sixty months.

Signed: Lee B Sullivan date 5-16-05 Installed by: Frye Grading

Improvement Permit by: DHumm, RS date 3-17-05 Operation Permit by: Anthony Cohen Jr. date 9/20/07

Authorization to Construct by: Jerry Medlin date 11-17-06 Existing System Inspection by: _____ date _____

HEALTH DEPT. COPY: WHITE OWNER COPY (FINAL): YELLOW OWNER COPY (INITIAL): PINK