IREDELL COUNTY HEALTH DEPARTMENT

STATESVILLE 704-878-5305 MOORESVILLE 704-664-5281

3:00

IMPROVEMENT PERMIT / AUTHORIZATION TO CONSTRUCT / OPERATION PERMIT / EXISTING SYSTEM INSPECTION

PERMIT# 122576 PIN# ~~4639-64-0340.046~~ 4639 64 3519 DATE March 14, 05

OWNER OR CONTRACTOR Alexander Construction / LARRY DAVIS PHONE: Business _____ Home _____

ADDRESS 1143 D. Executive Circle, Cary N.C. 27511

LOCATION (133 Waterbury). South Rd N TL Ferry Hill TL Northington Woods Dr. TL Waterbury Dr. on left @ int with Whispering Cove Ct.


SUBDIVISION Northington Woods BLOCK / SECTION _____ LOT 46 LOT AREA .64/ac SITE CLASS. PS DESIGN FLOW 460gpd L.T.A.R. .3

Septic Tank: 1000 Gallons; STB 1007 Date 2-13-06	☑ New System ☐ Repair System Type: I, II, III, IV, V, VI	☑ House/Mod. Home No. Bedrooms 4	Water Supply:
Pump Tank: 1000 Gallons; PT 274 Date 2-1-06	System Description: LPPBPS	☐ Mobile Home No. Bathrooms ___	☑ Individual
Pump Make: ___ Model ___ Serial No. ___	Repair System Description: LPPBPS	☐ Business No. Employees ___	☐ Public
Nitrification Field: No Fields 1 Square Feet 540/810 Linear Feet 270	Maintenance Agreement Required: ☑ Yes ☐ No	☐ Other ___	☐ Community
No Lines 5 Trench Width 24" MIN/ac Max Trench Bottom Depth 36" Gravel Depth N/A		☐ Slab ☑ Crawl Space ☐ Basement w/plumbing ☐ Basement wo/plumbing	

Comments:/Conditions: @ 36" max 96c

Comments:/Conditions: Black Label Filter
3-17-06 Top 4 lines checked
JM Pump tank needs rechecking to verify not deeper than 3', OK 3-20-06

1"=50' INITIAL SITE SKETCH

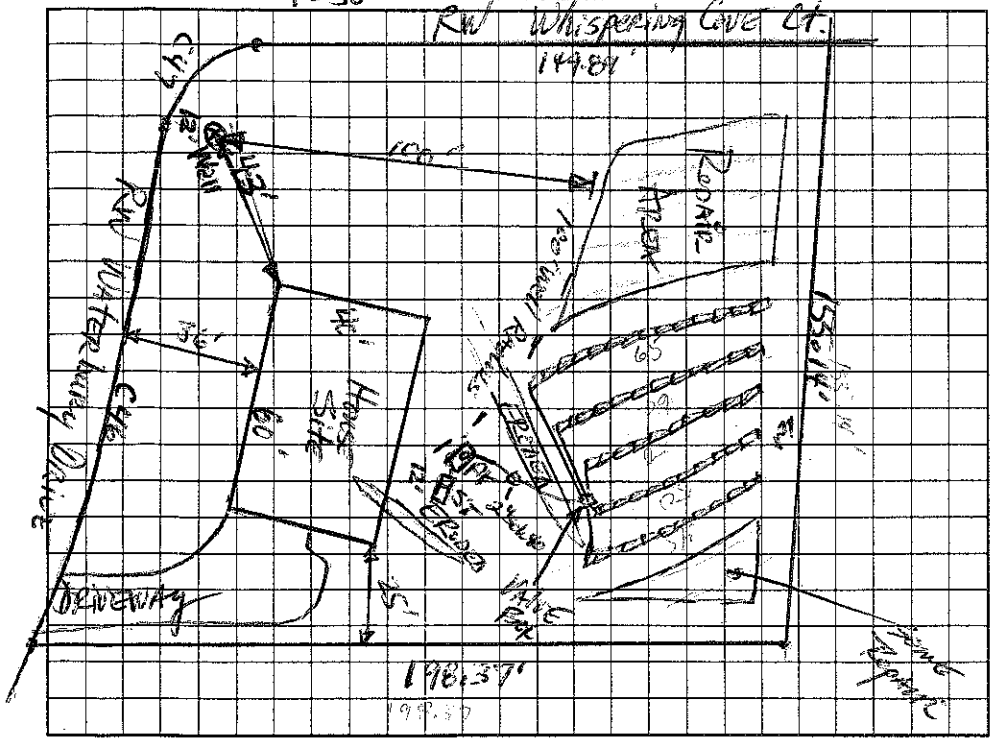

AS BUILT SKETCH

Top Line 44'
2nd 49'
3rd 52'
4th 57'
5th 63'
265'

Permit can be suspended or revoked if any false information is supplied toward securing the permit/any unauthorized changes are made to the site/any unauthorized changes are made in the installation of the system. Improvement Permit with plat valid without expiration. Improvement Permit with site plan valid for sixty months. Authorization to Construct is valid for a period equal to that of Improvement Permit – not to exceed sixty months.

Signed: _____ date 5-16-05 Installed by: Richard Abernathy

Improvement Permit by: _____ date 3-14-05 Operation Permit by: _____ date 7/25/06

Authorization to Construct by: _____ date 10/28/05 Existing System Inspection by: _____ date _____

HEALTH DEPT. COPY: WHITE OWNER COPY (FINAL): YELLOW OWNER COPY (INITIAL): PINK