IREDELL COUNTY HEALTH DEPARTMENT

STATESVILLE 704-878-5305 — MOORESVILLE 704-664-5281

IMPROVEMENT PERMIT / AUTHORIZATION TO CONSTRUCT / OPERATION PERMIT / EXISTING SYSTEM INSPECTI

10:30

PERMIT# 122559 PIN# 4639640340.035 4639-64-8286 DATE 2-20-06

OWNER OR CONTRACTOR J & K Developers, LLC PHONE: Business 516-4355 Home 828 478-9099

ADDRESS 3843 Gordon St. Terrell, NC 28682

LOCATION Hwy 150 West TR Perth Rd TL Fern Hill TL Northington Woods Dr TL Waterburg Dr on right

SUBDIVISION Northington Woods BLOCK / SECTION ____ LOT 35 LOT AREA .886 Acre SITE CLASS. PS DESIGN FLOW 480 gpd L.T.A.R. .25/.3 B4 Repair Wide sac

Septic Tank: 1000' Gallons; STB 1001 Date 1-10-06

Pump Tank: 1000' Gallons; PT 374 Date 1-10-06

Pump Make: Little Giant Model 9EP (Serial No.S WE0512) 480'

Nitrification Field: No Fields 1 Square Feet 1440' Linear Feet

No Lines 7@69' Trench Width 36" Max Trench Bottom Depth 36"

☒ New System ☐ Repair System Type: I, II, III, IV, V, VI

System Description: Pump - PM - 25% Reduction

Repair System Description: LPPP BPS

Maintenance Agreement Required: ☐ Yes ☒ No Not Initially

☒ House/Mod. Home ☐ Mobile Home ☐ Business ☐ Other

No. Bedrooms 4 No. Bathrooms ____ No. Employees ____

Water Supply: ☒ Individual ☐ Public ☐ Community


Gravel Depth N/A ☐ Slab ☒ Crawl Space ☐ Basement w/plumbing ☐ Basement wo/plumbing

Comments:/Conditions: 4 lines @ 69ft & 3 lines @ 68ft = 480ft
Keep Septic System (Tanks, Drain Field & Supply line) at least 50ft from all wells


Comments:/Conditions: Must keep drainlines 9ft on center to reserve enough room for repair.
3/13/06 Checked lines; tanks need to move over to left.

Scale 1: 50

INITIAL SITE SKETCH

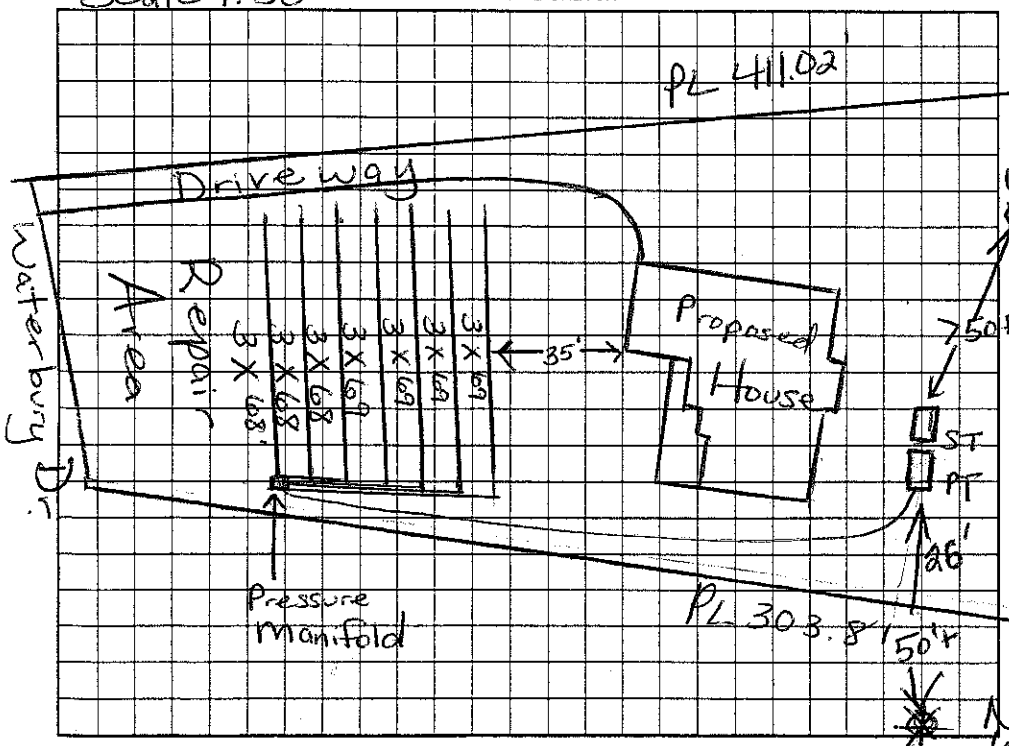

AS BUILT SKETCH

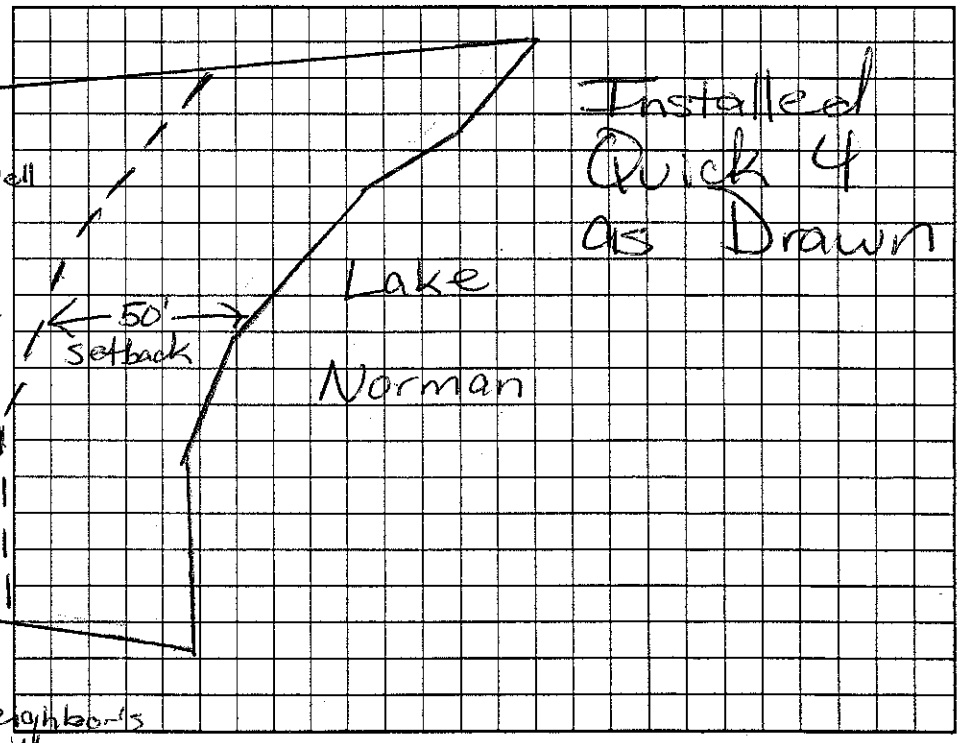

Permit can be suspended or revoked if any false information is supplied toward securing the permit/any unauthorized changes are made to the site/any unauthorized changes are made in the installation of the system. Improvement Permit with plat valid without expiration. Improvement Permit with site plan valid for sixty months. Authorization to Construct is valid for a period equal to that of Improvement Permit – not to exceed sixty months.

Signed: Sandy Riggins date 3/3/06

Improvement Permit by: Maria H. Tolson RS date 2/20/06

Authorization to Construct by: Maria H. Tolson RS date 2/20/06

Installed by: Richard Abernathy

Operation Permit by: ____ RS date 4/11/06

Existing System Inspection by: ____ date ____

HEALTH DEPT. COPY: WHITE OWNER COPY (FINAL): YELLOW OWNER COPY (INITIAL): PINK

Pd $100.00 1/31/06