2:30 BF 201373

IREDELL COUNTY HEALTH DEPARTMENT

Statesville Office (704) 878-5305 Mooresville Office (704) 660-3625 PERMIT # ~~122565~~

IMPROVEMENT PERMIT / AUTHORIZATION TO CONSTRUCT / OPERATION PERMIT / EXISTING SYSTEM

PIN # 4639-64-8667

APPLICANT: PMA INVESTMENTS APPLICANT ADDRESS: 452 WOODBRIDGE RD STATESVILLE

SITE ADDRESS: 161 WATERBURY DR. PHONE: 704-658-5514 ALT. PHONE:

SITE DIRECTIONS: PERTH, FERNHILL, NORTHINGTON WOODS, WATERBURY

SUBDIVISION: NORTHINGTON WOODS SECTION: LOT # 43 LOT AREA: .707 AC DESIGN FLOW: 360 L.T.A.R.: .275

Septic Tank 1000 (gal) STB ~~825~~ 1000 Date 6/23/14
Pump Tank (gal) PT Date
Pump Make Model Serial #
Nitrification Fields 1 # Lines 3@110' Linear Ft: 330'
Trench Width 36" Max. Trench Bottom Depth 36" Gravel Depth


☒ New System ☐ Repair ☐ Expansion System Type: I II (III) IV V VI
System Description: 25% REDUCTION
Repair System Description: PANEL
Maintenance Agreement Required: ☐ YES ☒ NO
☒ GRAVITY ☐ PRESSURE

☒ Residence No. Bedrooms 3
☐ Business No. Persons 6
☐ Other No. Employees
☐ Slab ☒ Crawl Space
☐ Basement w/plumbing ☐ Basement w/o plumbing


Water Supply: ☒ Private ☐ Public ☐ Community

Comments / Conditions:

INITIAL SITE SKETCH

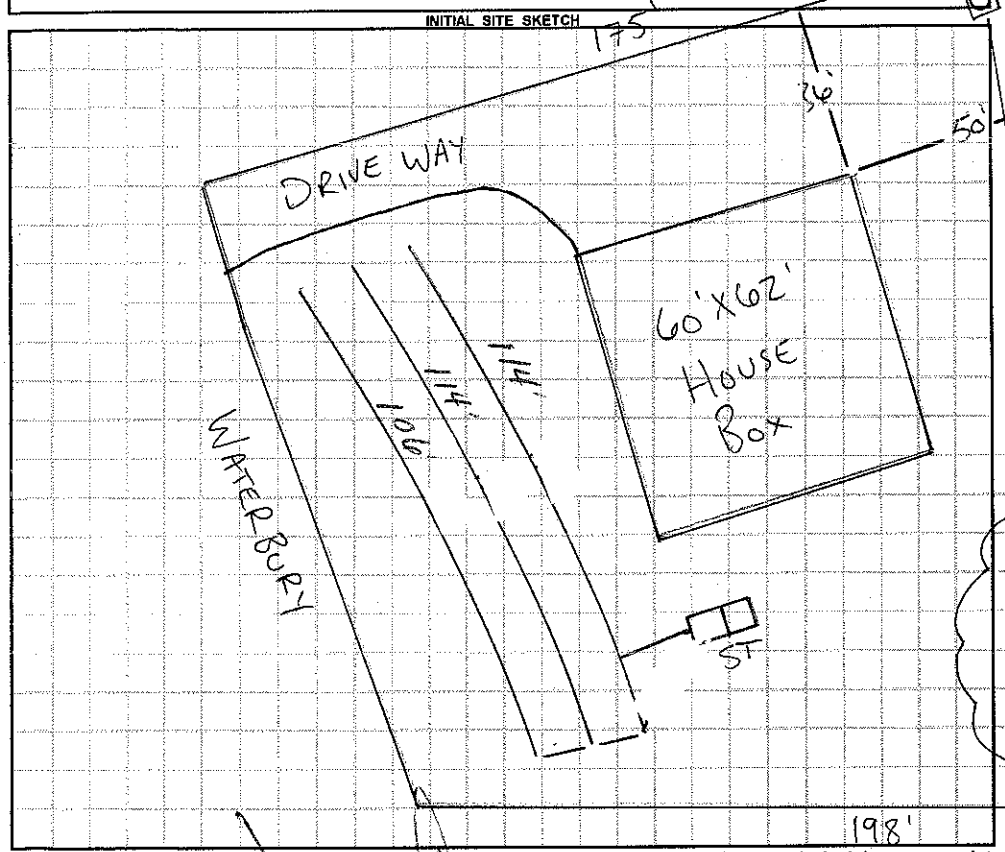

AS BUILT SKETCH

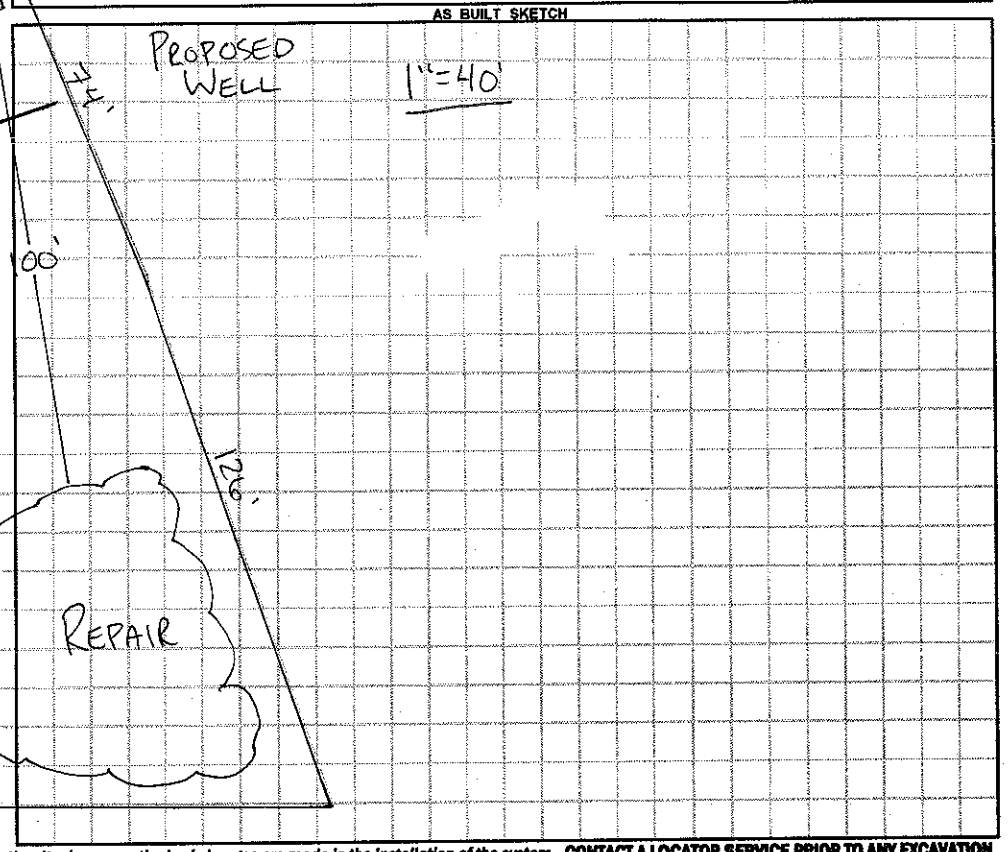

Permit can be suspended or revoked if any false information is supplied toward securing the permit / any unauthorized changes are made to the site / any unauthorized changes are made in the installation of the system. **CONTACT A LOCATOR SERVICE PRIOR TO ANY EXCAVATION**

☐ **IMPROVEMENT PERMIT** *with plat valid without expiration.* ☒ **IMPROVEMENT PERMIT** *with site plan valid for 60 mos.* ☒ **AUTHORIZATION TO CONSTRUCT** *valid for period equal to IMPROVEMENT PERMIT--not to exceed 60 mo.*

Owner / Applicant Signature: Date: 2/24/14

IMPROVEMENT PERMIT by: ~~APPROVED FEB 20 2014~~ Date:

AUTHORIZATION TO CONSTRUCT by: APPROVED FEB 20 2014 Date:

Installed by: Roman Septic

OPERATION PERMIT by: Date: 8/7/14

Existing System Inspected by: Date:

Health Dept. Copy - WHITE Applicant (Final Approval) - YELLOW Applicant (Conditional Approval) - PINK