IREDELL COUNTY HEALTH DEPARTMENT

STATESVILLE 704-878-5305 MOORESVILLE 704-664-5281

IMPROVEMENT PERMIT / AUTHORIZATION TO CONSTRUCT / OPERATION PERMIT / EXISTING SYSTEM INSPECTION

PERMIT# 122591 PIN# ~~4639-64-0340.052~~ 4639651268.000 DATE March 28, 05

OWNER OR CONTRACTOR Shavender Nov. Group LLC / Anaheim Homes PHONE: Business _____ Home _____

ADDRESS 1143 D. Executive Circle, Cary, N.C. 27511

LOCATION Kelly Rd. N. TL Ferry Hill Rd. TL Northington Woods Dr. TL Waterbury Dr. TL Whispering Creek Ct. on right nearest end

SUBDIVISION Northington Woods BLOCK / SECTION _____ LOT 52 LOT AREA .960 SITE CLASS PS DESIGN FLOW 480gpd L.T.A.R. 63 #138

Septic Tank: 1000 Gallons; STB 1012 Date 10-30-06

Pump Tank: 1000 Gallons; PT 17 Date 1-15-07

Pump Make: Gowds Model WE10124 Serial No. C07890 48

Nitrification Field: No Fields 1 Square Feet 1200 Linear Feet 400

No Lines 3 Trench Width 36" Max Trench Bottom Depth 36" Gravel Depth NA

☑ New System ☐ Repair System Type: I, II, III, IV, V, VI

System Description: pm 25% Reduction

Repair System Description: pm/lf 25-50% Reduction

Maintenance Agreement Required: ☐ Yes ☑ No

☑ House/Mod. Home No. Bedrooms 4

☐ Mobile Home No. Bathrooms ____

☐ Business No. Employees ____

☐ Other ____


☐ Slab ☑ Crawl Space ☐ Basement w/plumbing ☐ Basement wo/plumbing

Water Supply: ☑ Individual ☐ Public ☐ Community


Comments:/Conditions:

Comments:/Conditions: Installed Quick 4 Chamber
3 lines as per initial site sketch
Yellow tuf-tite filter

1"=50' INITIAL SITE SKETCH

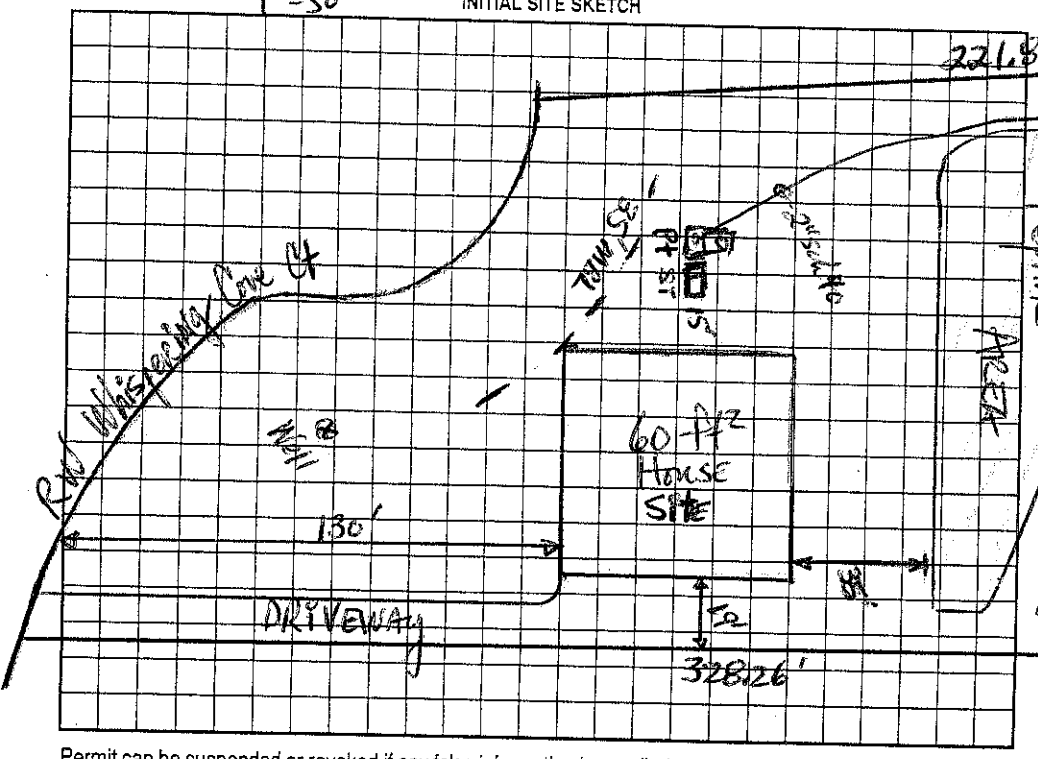

AS BUILT SKETCH

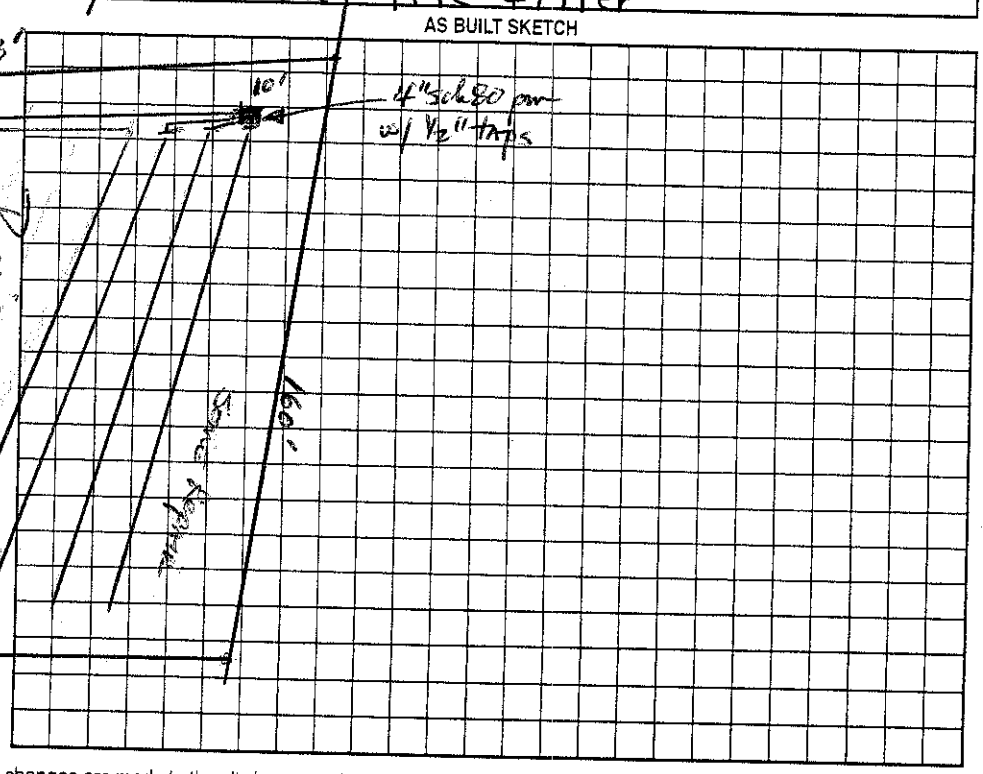

Permit can be suspended or revoked if any false information is supplied toward securing the permit/any unauthorized changes are made to the site/any unauthorized changes are made in the installation of the system. Improvement Permit with plat valid without expiration. Improvement Permit with site plan valid for sixty months. Authorization to Construct is valid for a period equal to that of Improvement Permit – not to exceed sixty months.

Signed: _____ date 5-16-05 Installed by: Frye Grading 704-902-1380 Tommy

Improvement Permit by: _____ date 3-28-05 Operation Permit by: Wesley Sparks R.S. date 8/10/07

Authorization to Construct by: _____ date 8/22/06 Existing System Inspection by: _____ date _____

HEALTH DEPT. COPY: WHITE OWNER COPY (FINAL): YELLOW OWNER COPY (INITIAL): PINK