IREDELL COUNTY HEALTH DEPARTMENT

STATESVILLE 704-878-5305 MOORESVILLE 704-664-5281

IMPROVEMENT PERMIT / AUTHORIZATION TO CONSTRUCT / OPERATION PERMIT / EXISTING SYSTEM INSPECTION

PERMIT# 122593 PIN# ~~4635-64-0340.054~~ 4639651513.000 DATE March 29, 05

OWNER OR CONTRACTOR Alexander Dev. Group LLC / Anderson PHONE: Business _____ Home _____

ADDRESS 1143 D. Executive Circle / Conover N.C.

LOCATION Fourth Rd. N. TL Fews Hill Rd. TL Northington Woods Dr. TL Waterbury Dr. TL Whispering Love Ct at end

SUBDIVISION Northington Woods BLOCK / SECTION _____ LOT 54 LOT AREA 1.01 Ac SITE CLASS PS DESIGN FLOW 480 gpd L.T.A.R. .3

Septic Tank: 1000 Gallons; STB 294 Date 3-3-05

Pump Tank: 1000 Gallons; PT 17 Date 4-22-05

Pump Make: Zoeller Model PE51MMA Serial No. _____

Nitrification Field: No Fields 1 Square Feet 1200 Linear Feet 400

No Lines 4 Trench Width 36" Max Trench Bottom Depth 36" Gravel Depth N/A

☑ New System ☐ Repair System Type: I, II, III, IV, V, VI

System Description: pm 25% Reduction

Repair System Description: LPPPBPS

Maintenance Agreement Required: ☐ Yes ☑ No w/ initially

☑ House/Mod. Home No. Bedrooms 4

☐ Mobile Home No. Bathrooms _____

☐ Business No. Employees _____

☐ Other _____

☐ Slab ☑ Crawl Space ☐ Basement w/plumbing ☐ Basement wo/plumbing


Water Supply: ☑ Individual ☐ Public ☐ Community

Comments:/Conditions:


Comments:/Conditions:

yellow poly-lok
- Quick 4s
- pressure head set
5-18-07 JG

1"=50' INITIAL SITE SKETCH

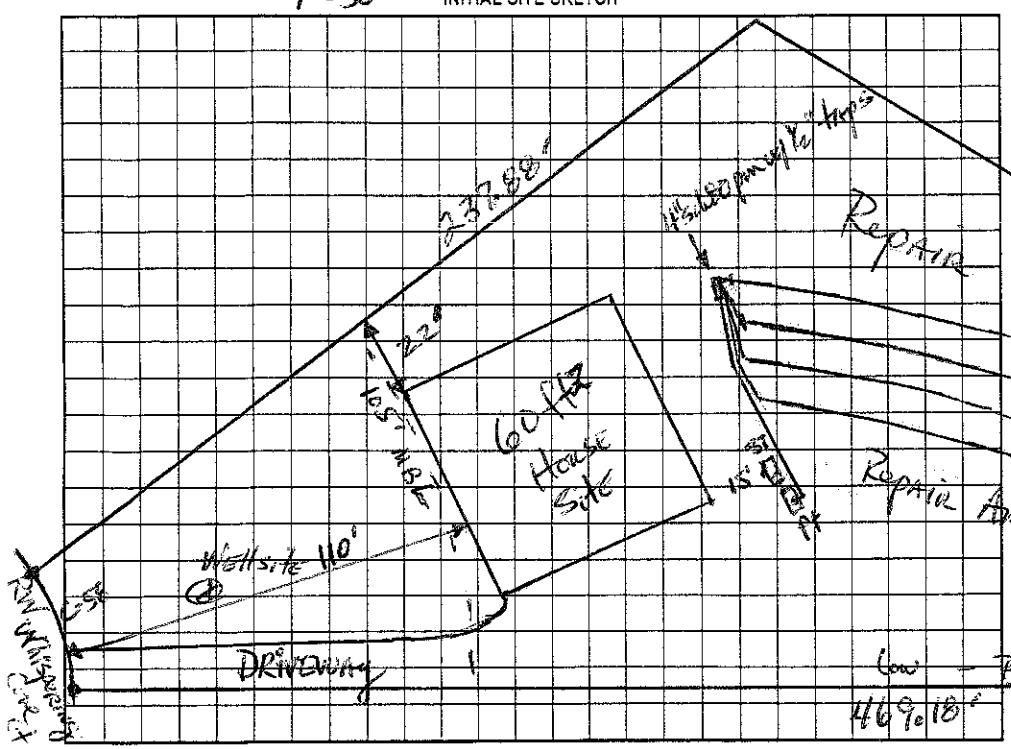

AS BUILT SKETCH

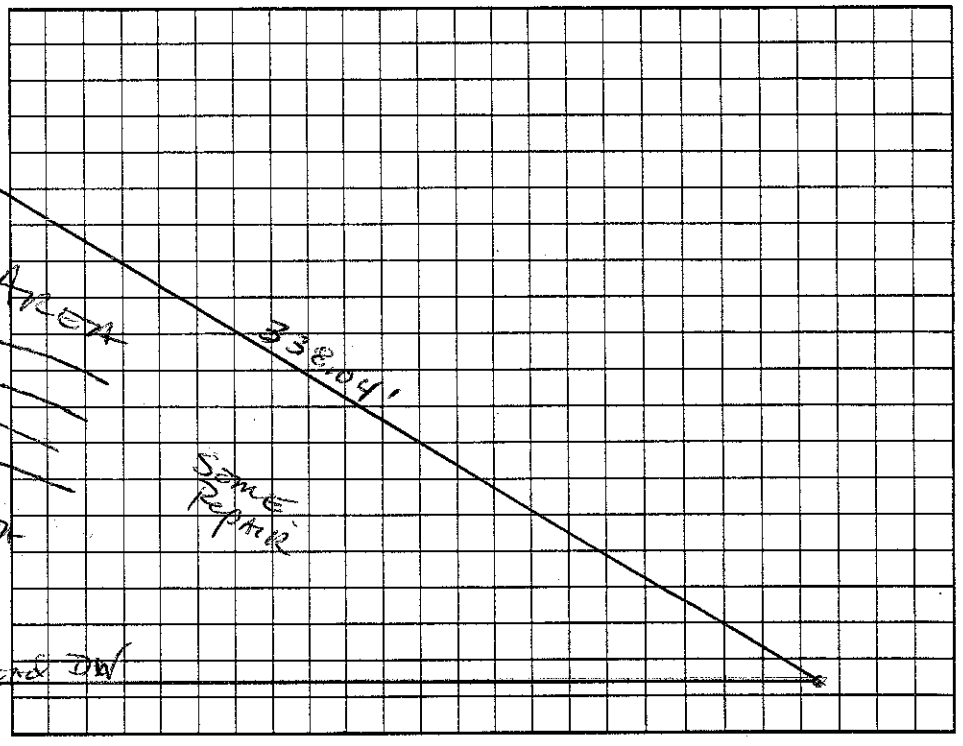

Permit can be suspended or revoked if any false information is supplied toward securing the permit/any unauthorized changes are made to the site/any unauthorized changes are made in the installation of the system. Improvement Permit with plat valid without expiration. Improvement Permit with site plan valid for sixty months. Authorization to Construct is valid for a period equal to that of Improvement Permit – not to exceed sixty months.

Signed: _____ date 5-16-05 Installed by: Tommy Tingle Wesley Sparks RS. date 9/18/07

Improvement Permit by: _____ date 3-29-05 Operation Permit by: _____ date _____

Authorization to Construct by: _____ date 9/27/06 Existing System Inspection by: _____ date _____

HEALTH DEPT. COPY: WHITE OWNER COPY (FINAL): YELLOW OWNER COPY (INITIAL): PINK