(E)

IREDELL COUNTY HEALTH DEPARTMENT

STATESVILLE 704-878-5305 MOORESVILLE 704 281

IMPROVEMENT PERMIT / AUTHORIZATION TO CONSTRUCT / OPERATION PERMIT / EXISTING SYSTEM INSPECTION

PERMIT# 07 1926 PIN# 4639 69 7130 902-0085 DATE 1/12/01

OWNER OR CONTRACTOR Shaw Const. Co. PHONE: Business 528-4494 Home

ADDRESS PO Box 1061 Troutman, NC. 28166

LOCATION Perth Rd. N TL Neill Farm Rd. ~ 1/2 mile on (R)

SUBDIVISION PLEASANT SHADE BLOCK / SECTION LOT 1 LOT AREA 1.13 AC SITE CLASS. PS DESIGN FLOW 360 L.T.A.R. .3

Septic Tank: 1000 Gallons; STB 1009 Date 8/6/01
Pump Tank: Gallons; PT Date
Pump Make: Model Serial No.
Nitrification Field: No Fields 1 Square Feet 1200 Linear Feet 400
No Lines 5@80' Trench Width 3' Max Trench Bottom Depth 3'

[X] New System ☐ Repair System Type: I, (II), III, IV, V, VI
System Description: GRAV - CONVENTIONAL
Repair System Description: TYPE 3
Maintenance Agreement Required: ☐ Yes [X] No

Gravel Depth 12"


[X] House/Mod. Home No. Bedrooms 3
☐ Mobile Home No. Bathrooms 3
☐ Business No. Employees
☐ Other
☐ Slab ☐ Crawl Space [X] Basement w/plumbing ☐ Basement wo/plumbing

Water Supply:
[X] Individual
☐ Public
☐ Community


Comments:/Conditions:

Comments:/Conditions:

INITIAL SITE SKETCH

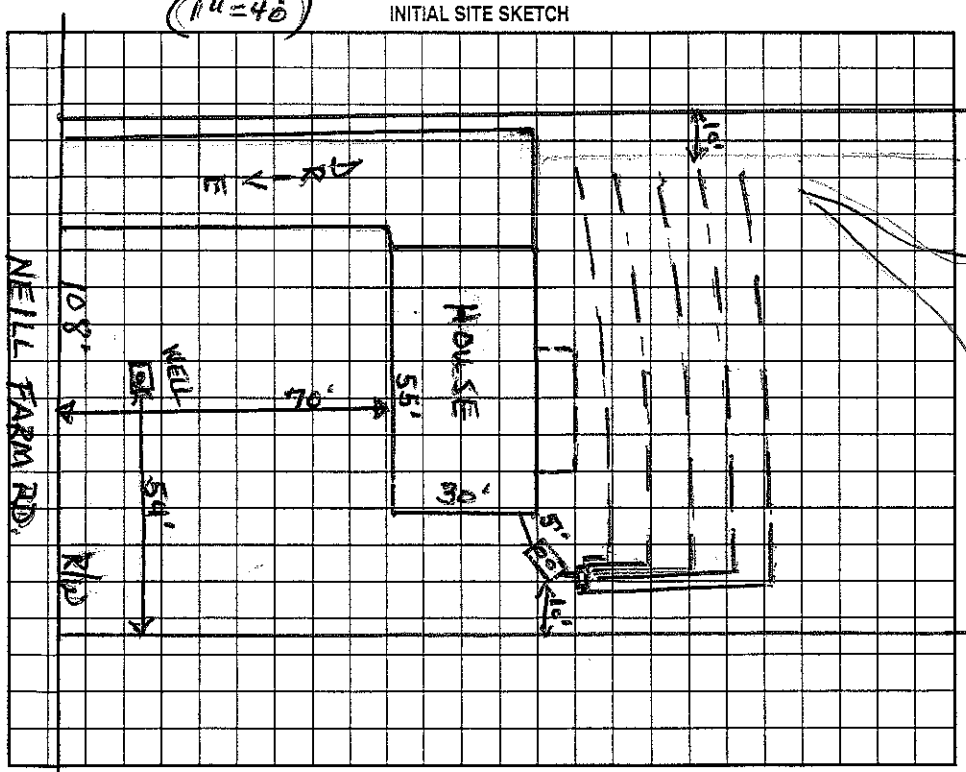

AS BUILT SKETCH

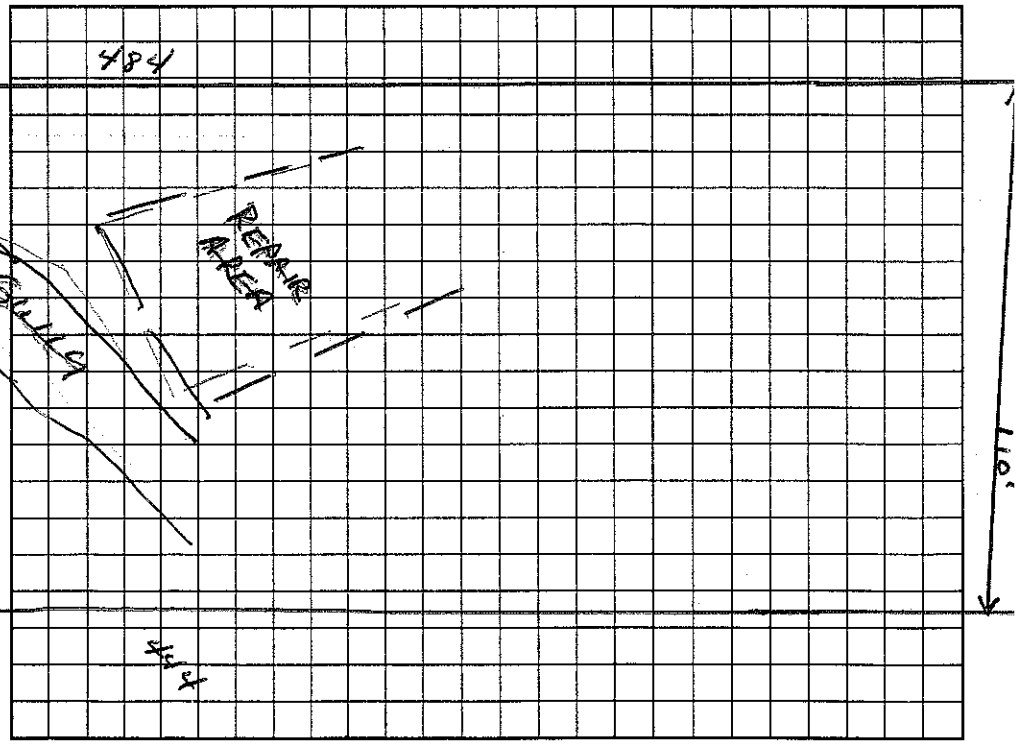

Permit can be suspended or revoked if any false information is supplied toward securing the permit/any unauthorized changes are made to the site/any unauthorized changes are made in the installation of the system. Improvement Permit with plat valid without expiration. Improvement Permit with site plan valid for sixty months. Authorization to Construct is valid for a period equal to that of Improvement Permit – not to exceed sixty months.

Signed: X [signature] date 1-19-01 Installed by: Jamey Hadley

Improvement Permit by: Wesley Sparks RS. date 1/12/01 Operation Permit by: Wesley Sparks RS. date 9/13/01

Authorization to Construct by: Wesley Sparks RS. date 1/12/01 Existing System Inspection by: date

HEALTH DEPT. COPY: WHITE OWNER COPY (FINAL): YELLOW OWNER COPY (INITIAL): PINK