IREDELL COUNTY HEALTH DEPARTMENT

Statesville Office (704) 878-5305 Mooresville Office (704) 660-3625 PERMIT # 213475

IMPROVEMENT PERMIT / AUTHORIZATION TO CONSTRUCT / OPERATION PERMIT / EXISTING SYSTEM

PIN # 4639-71-0400 0370

APPLICANT: MEREDITH JOHNSON APPLICANT ADDRESS: 156 BAY CROSSING DR.

SITE ADDRESS: SAME PHONE: 704-779-8207 ALT. PHONE:

SITE DIRECTIONS: PERTH, TL LIVA, TR BAY CROSSING, ON R

SUBDIVISION: BAY CROSSING SECTION: 1 LOT # 87 LOT AREA: .91 AC DESIGN FLOW: 480 L.T.A.R.: .3

Septic Tank EX. 1500 (gal) STB Date

Pump Tank EX. 1000 (gal) PT Date

Pump Make Model Serial #

Nitrification Fields # Lines EXISTING Linear Ft:

Trench Width Max. Trench Bottom Depth Gravel Depth —

☐ New System ☐ Repair ☐ Expansion System Type: I II (III) IV V VI

System Description: PM CHAMBERS

Repair System Description: PANEL BLOCK

Maintenance Agreement Required: ☐ YES ☒ NO

☐ GRAVITY ☒ PRESSURE

☐ Residence No. Bedrooms 4

☐ Business No. Persons

☒ Other No. Employees

☐ Slab ☐ Crawl Space


☐ Basement w/plumbing ☐ Basement w/o plumbing

Water Supply: ☒ Private ☐ Public ☐ Community


Comments / Conditions: DECK POST MUST BE MIN 5' FROM TANK

SCREENED PORCH
CANTILEVER DECK

INITIAL SITE SKETCH

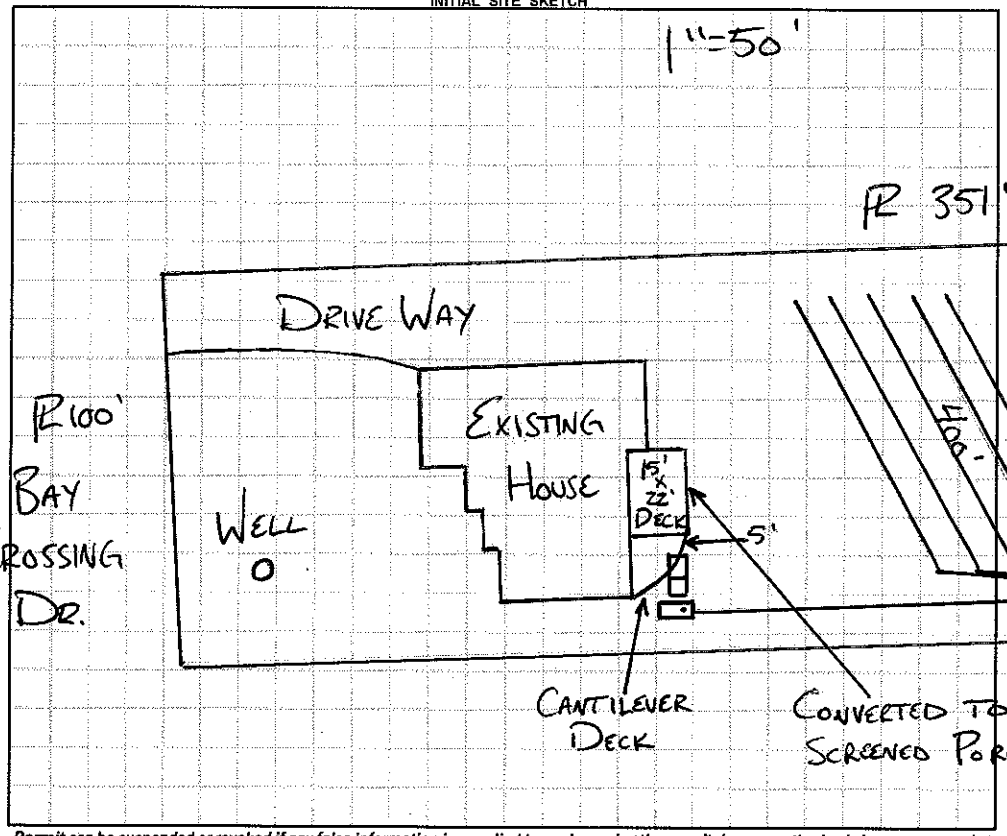

AS BUILT SKETCH

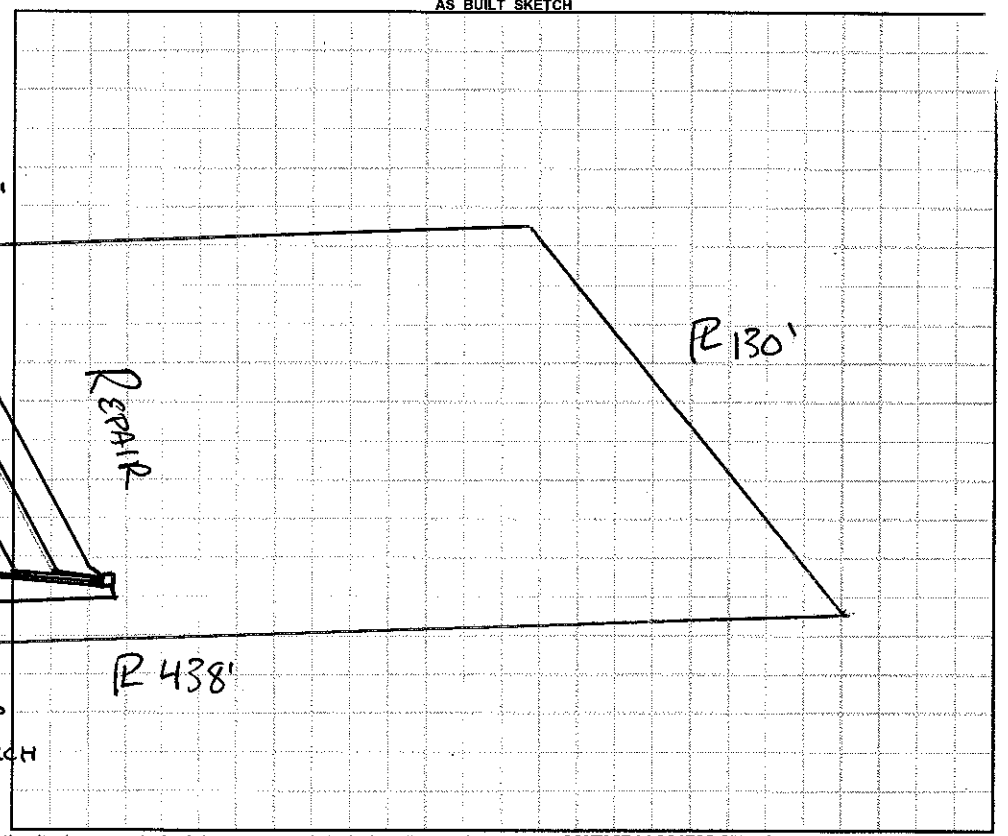

Permit can be suspended or revoked if any false information is supplied toward securing the permit / any unauthorized changes are made to the site / any unauthorized changes are made in the installation of the system. **CONTACT A LOCATOR SERVICE PRIOR TO ANY EXCAVATION**

☐ **IMPROVEMENT PERMIT** ***with plat*** *valid without expiration.* ☐ **IMPROVEMENT PERMIT** ***with site plan*** *valid for 60 mos.* ☐ **AUTHORIZATION TO CONSTRUCT** *valid for period equal to IMPROVEMENT PERMIT--not to exceed 60 mo.*

Owner / Applicant Signature: M Johnson Date: 11/5/15 Installed by:

IMPROVEMENT PERMIT by: Date: OPERATION PERMIT by: Date:

AUTHORIZATION TO CONSTRUCT by: Date: Existing System Inspected by: Date: 11-2-15

Health Dept. Copy - WHITE Applicant (Final Approval) - YELLOW Applicant (Conditional Approval) - PINK