IREDELL COUNTY HEALTH DEPARTMENT

STATESVILLE 704-878-5305 MOORESVILLE 704-664-5281

IMPROVEMENT PERMIT / AUTHORIZATION TO CONSTRUCT / OPERATION PERMIT / EXISTING SYSTEM INSPECTION

PERMIT# 122201 PIN# 4639 ~~67 5556.082~~ 91-1578 DATE 11/9/07

OWNER OR CONTRACTOR HECHT PROPERTIES/Adam Stockman PHONE: Business 483-3651 Home

ADDRESS 885 (N) HWY 16 DENVER NC 28037

LOCATION PERTH (S) - TR LIVA LN - TR BAYCROSSING - TR TEA OLIVE LN - ON RT

SUBDIVISION BAY CROSSING BLOCK / SECTION 1 LOT 82 LOT AREA .91 AC SITE CLASS. PS DESIGN FLOW 480 GPD L.T.A.R. .3 GPD/FT2

Septic Tank: ~~1000~~ Gallons; STB 528 Date 5-2-07
Pump Tank: 1500 Gallons; PT Date
Pump Make: Model Serial No.
Nitrification Field: No Fields 1 Square Feet 1605 Linear Feet 535
No Lines 5@107' Trench Width 36" Max Trench Bottom Depth 36" Gravel Depth 12"

☑ New System ☐ Repair System Type: I (II) III, IV, V, VI
System Description: GRAVITY CONVENTIONAL
Repair System Description: GRAV. 25% REDUCTION
Maintenance Agreement Required: ☐ Yes ☑ No

☐ Slab ☑ Crawl Space ☐ Basement w/plumbing ☐ Basement wo/plumbing

☑ House/Mod. Home ☐ Mobile Home ☐ Business ☐ Other


No. Bedrooms 4 No. Bathrooms 4 No. Employees

Water Supply: ☑ Individual ☐ Public ☐ Community


Comments:/Conditions:

Comments:/Conditions:
yellow tuf-tite filter
ST w/ green plastic risers

INITIAL SITE SKETCH 1"=50'

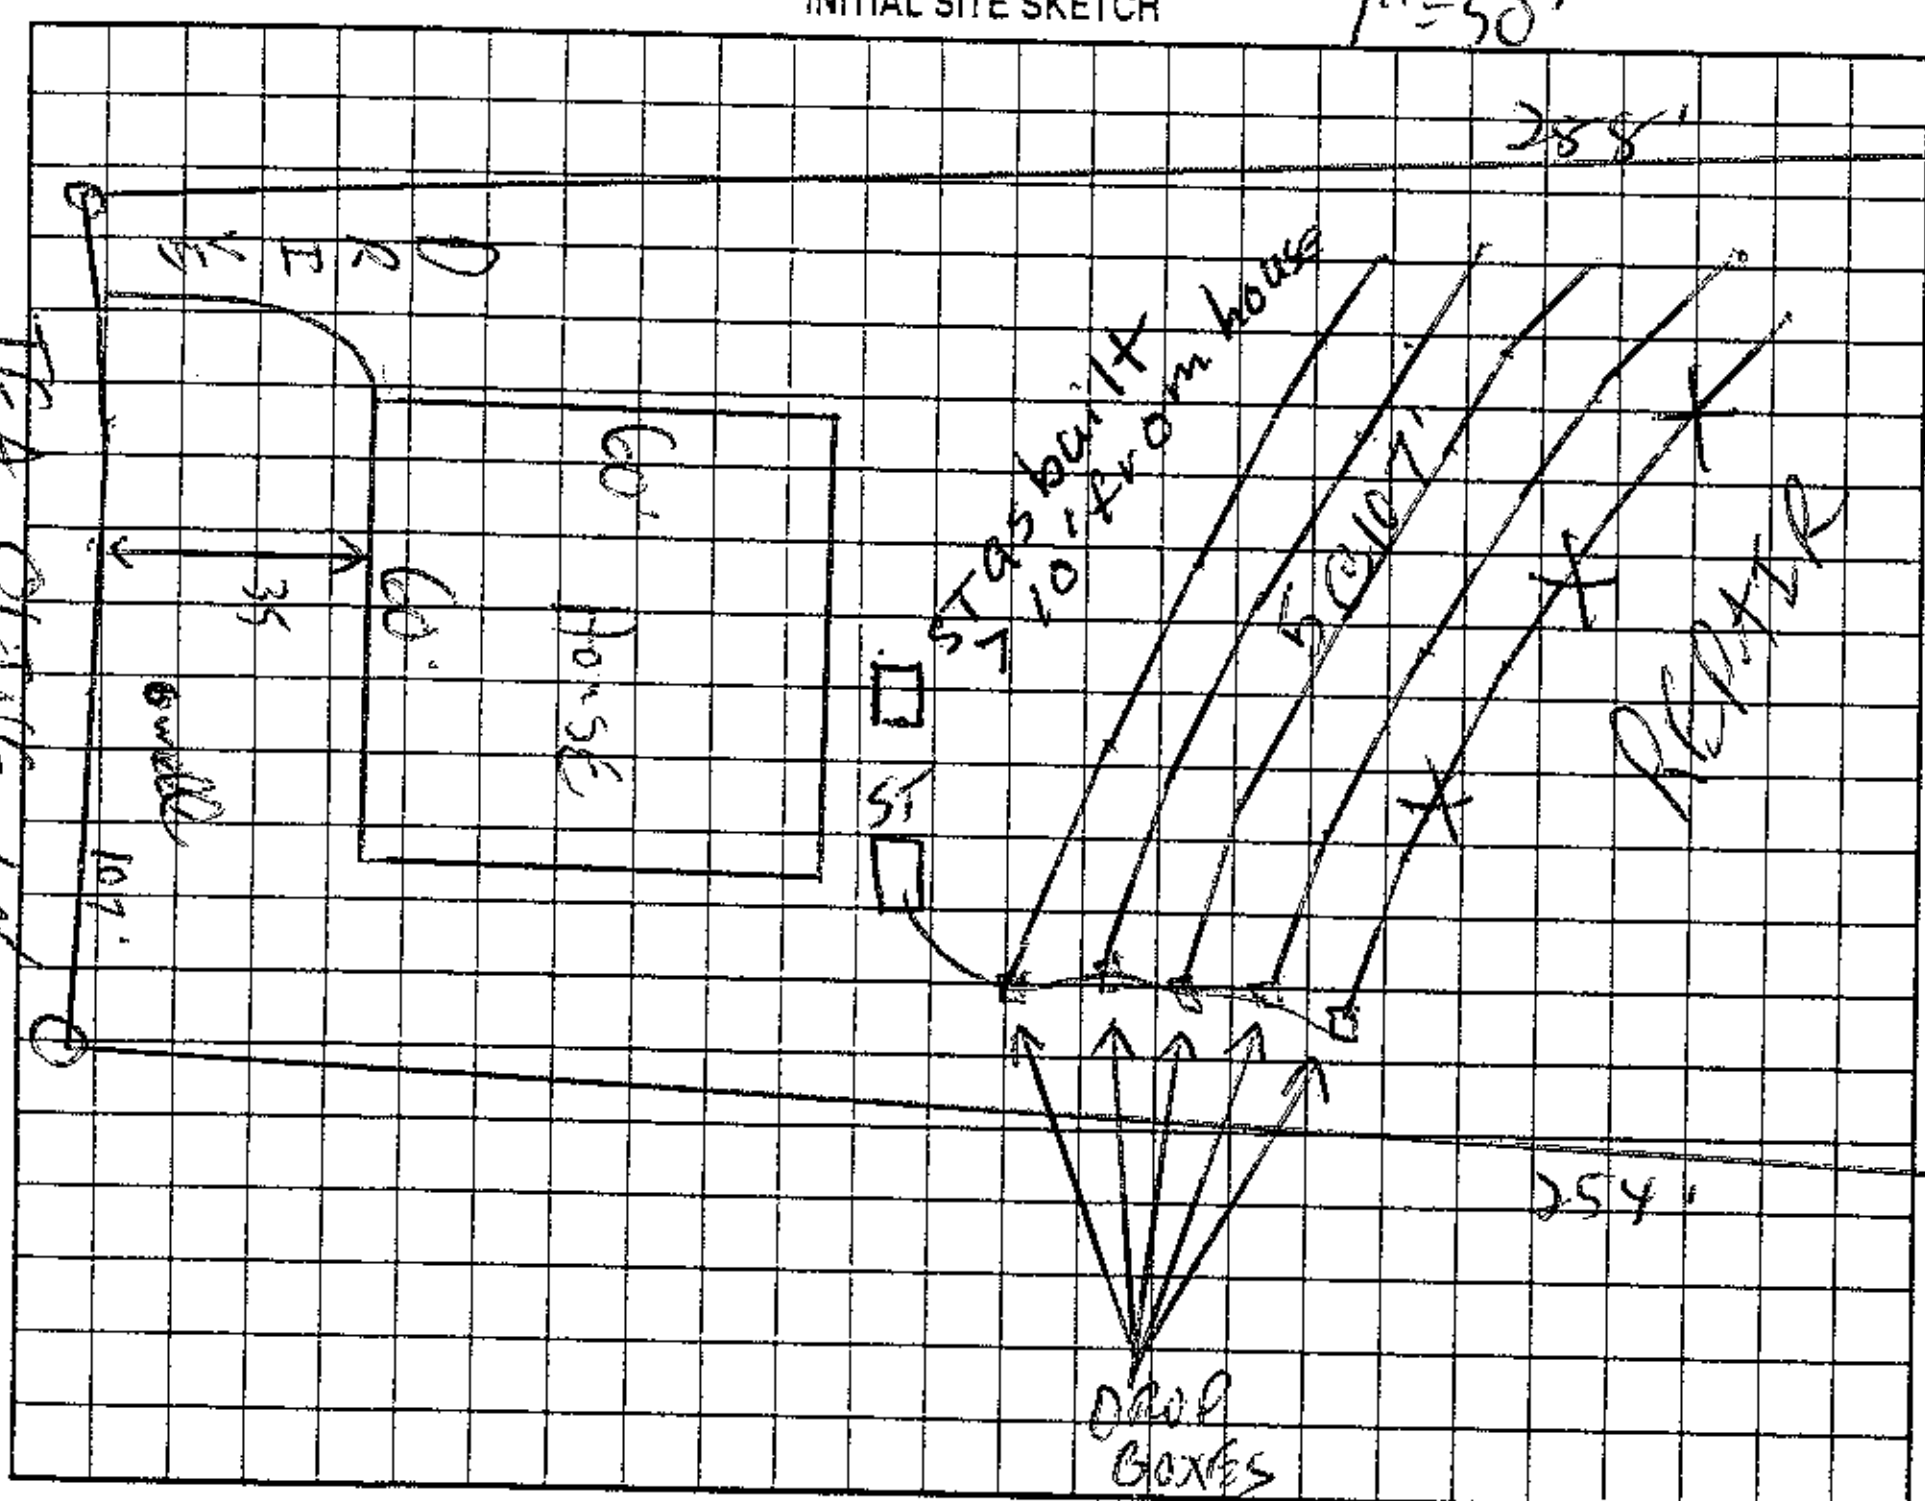

AS BUILT SKETCH

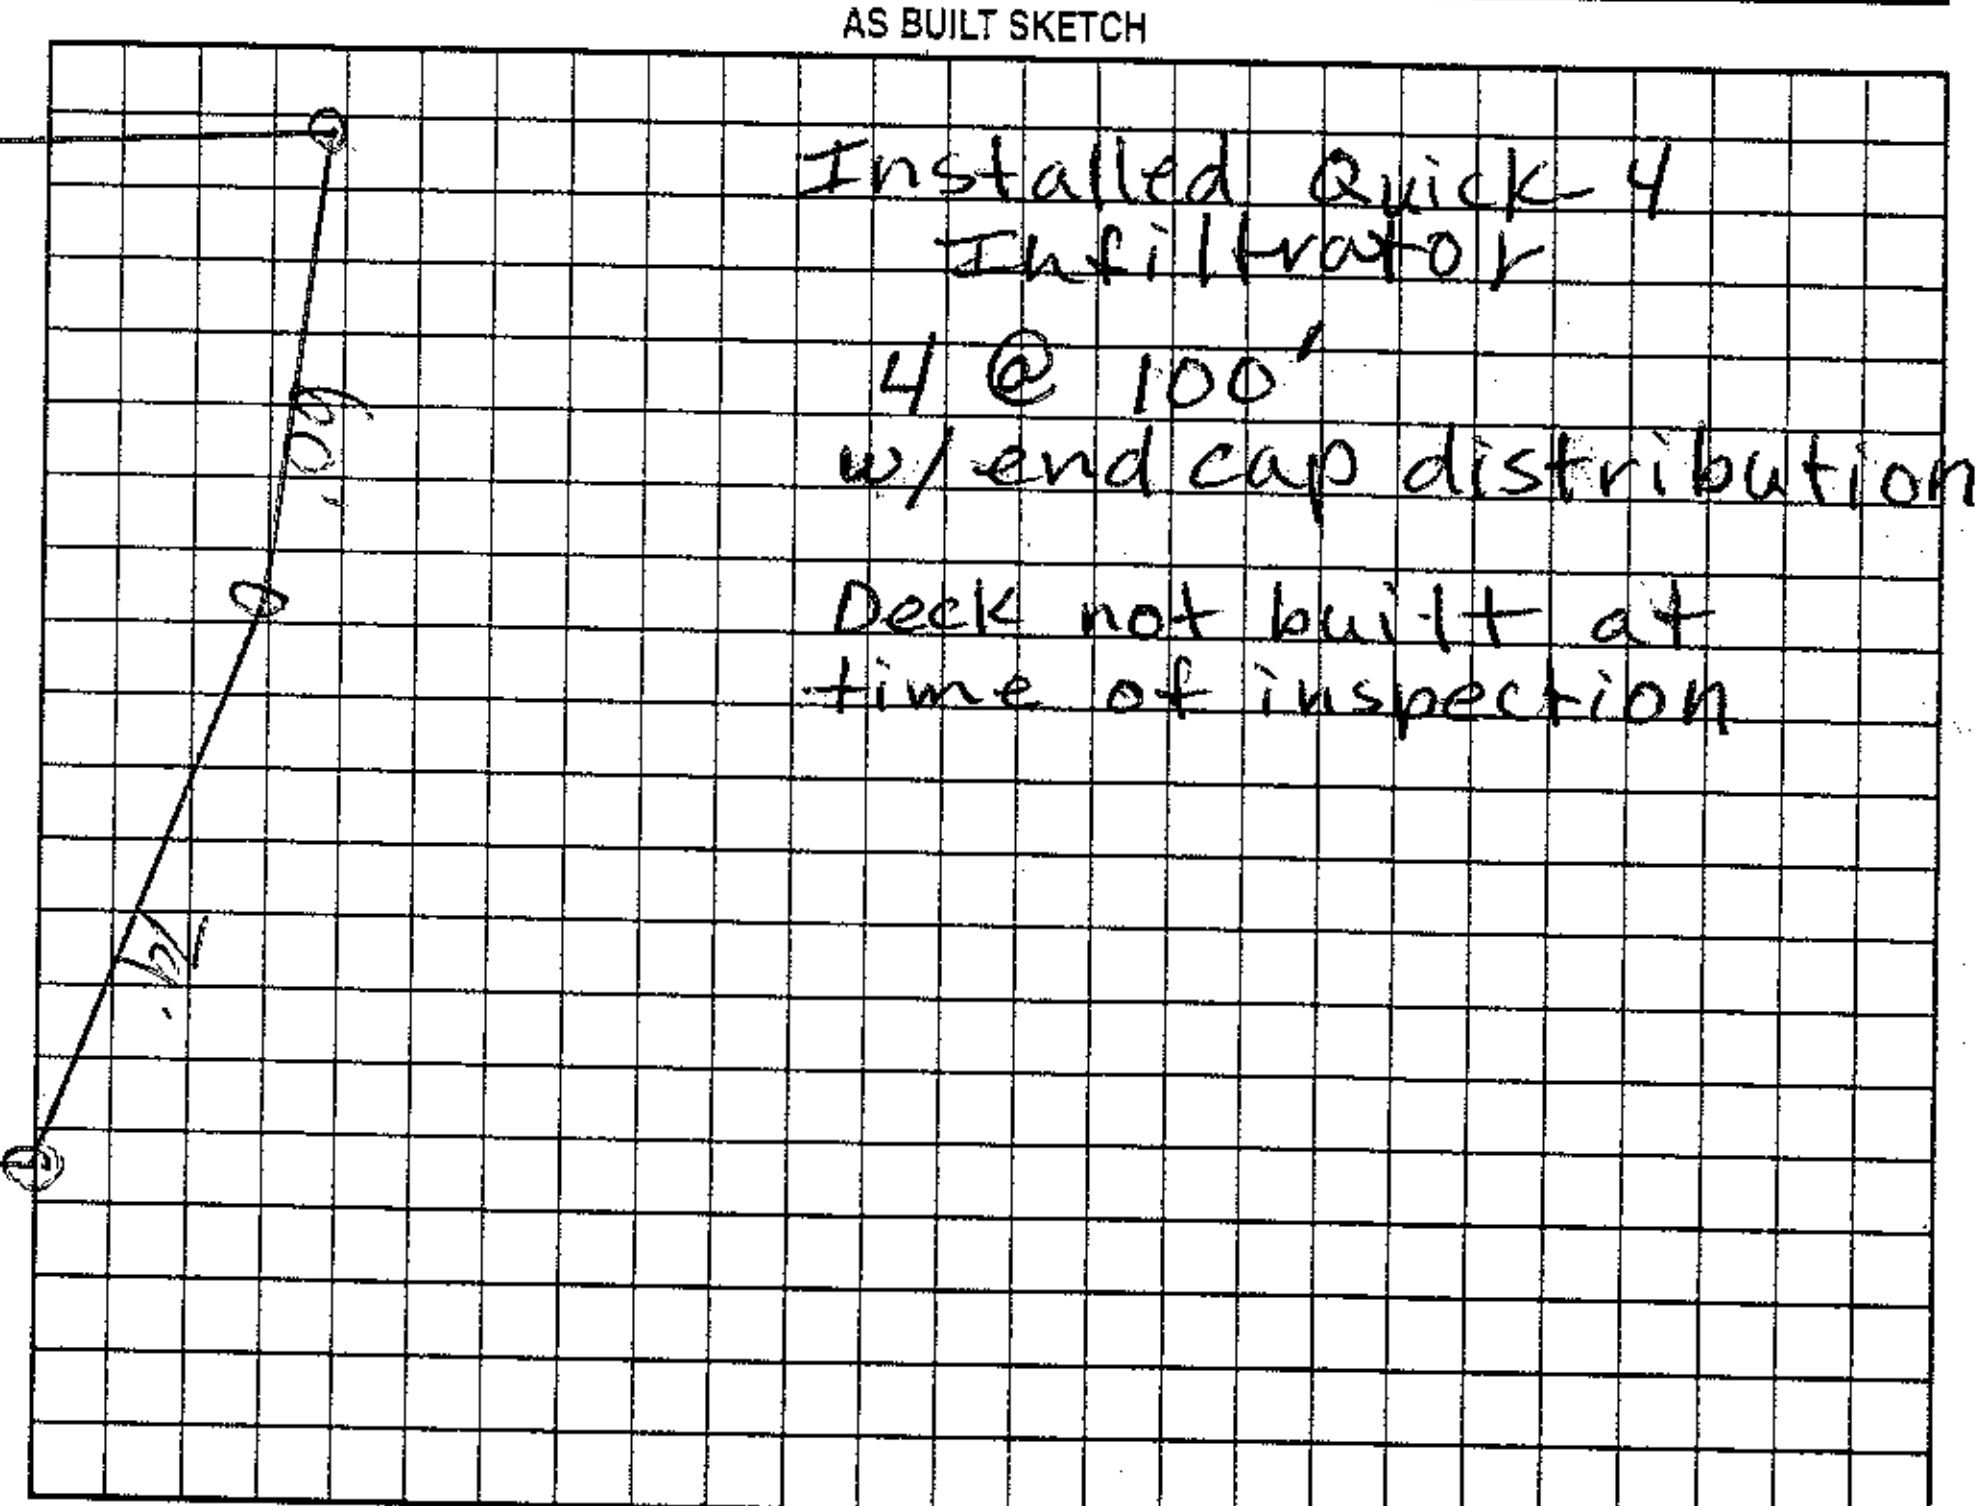

Permit can be suspended or revoked if any false information is supplied toward securing the permit/any unauthorized changes are made to the site/any unauthorized changes are made in the installation of the system. Improvement Permit with plat valid without expiration. Improvement Permit with site plan valid for sixty months. Authorization to Construct is valid for a period equal to that of Improvement Permit – not to exceed sixty months.

Signed: [signature] date 11-22-04 Installed by: A-1 Backhoe

Improvement Permit by: [signature] RS date 11/9/04 Operation Permit by: Andy Michelle date 9-21-07

Authorization to Construct by: [signature] RS date 5/23/06 Existing System Inspection by: date

HEALTH DEPT COPY: WHITE OWNER COPY (FINAL): YELLOW OWNER COPY (INITIAL): PINK