IREDELL COUNTY HEALTH DEPARTMENT

STATESVILLE 704-878-5305 MOORESVILLE 704-664-5281

COPY

IMPROVEMENT PERMIT / AUTHORIZATION TO CONSTRUCT / OPERATION PERMIT / EXISTING SYSTEM INSPECTION

PERMIT# 121650 PIN# 4639-61-5956.088 4639-71-2294 DATE 11/28/06

OWNER OR APPLICANT Keepsake Homes - ~~Steve Wickersham~~ PHONE: Business _____ Home _____

ADDRESS _____

LOCATION Perth Rd(S) - To Live, To Bay Crossing - On Rt

SUBDIVISION Bay Crossing BLOCK / SECTION 1 LOT 88 LOT AREA 1.81 Ac SITE CLASS. PS DESIGN FLOW 600 L.T.A.R. .5 gpd/ft²

Septic Tank: 1500 Gallons; STB 338 Date 1-22-08

Pump Tank: 1500 Gallons; PT ~~477~~ Date 1-14-08

Pump Make: Goulds THP Model WE10J2HV Serial No. P WE10J2HV

Nitrification Field: No Fields 1 Square Feet 1008 Linear Feet 336

No Lines 4 Trench Width 24"/36" Max Trench Bottom Depth 36" Gravel Depth N/A

☐ New System ☐ Repair ☐ Expansion System Type: I II III IV V VI

System Description: L.P. PVC85

Repair System Description: Same

Maintenance Agreement Required: ☒ Yes ☐ No

☒ House/Mod. Home No. Bedrooms 3/10

☐ Mobile Home No. Persons

☐ Business No. Employees

☐ Other

Water Supply: ☒ Individual ☐ Public ☐ Community

☐ Gravity ☐ Pressure ☐ Slab ☒ Crawl Space ☐ Basement w/plumbing ☐ Basement wo/plumbing

Comments:/Conditions:


Lines = 8' minimum on Center
Distribution through Central Valve Box (CVB)

Comments:/Conditions: 2/29/08 Tanks + lines checked AC


* See Attached for Pool

1"=100'

INITIAL SITE SKETCH

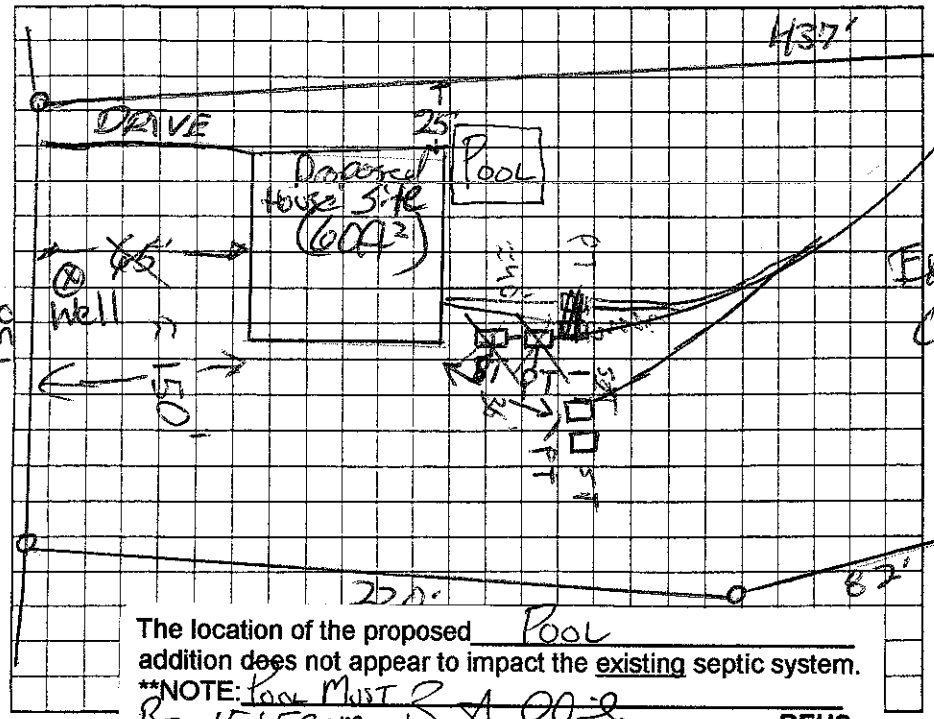

AS BUILT SKETCH

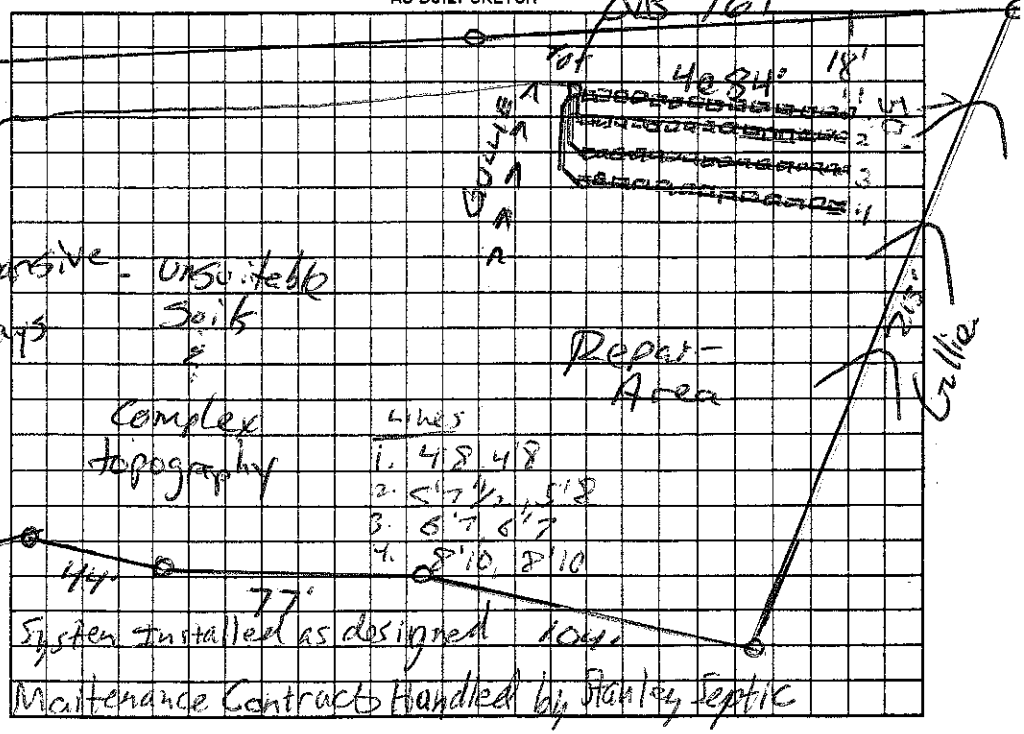

The location of the proposed Pool addition does not appear to impact the existing septic system.

**NOTE: Pool Must Be 15' From Septic

REHS

Date: 1-16-08

ICHD-Environmental Health Division

Permit can be ... authorized changes are made to the site/any unauthorized changes are made in the installation of the system. Improvement Permit with p... ☒ Authorization to Construct is valid for a period equal to that of Improvement Permit – not to exceed sixty months.

X Signed: _____ date _____ Installed by: Richard Abernathy

Improvement Permit by: _____ date 11/28/06 Operation Permit by: Anthony Cole' J. R.S. date 7/17/08

Authorization to Construct by: Wesley Sparks R.S. date 11/9/07 Existing System Inspection by: _____ date _____

HEALTH DEPT. COPY: WHITE OWNER COPY (FINAL): YELLOW OWNER COPY (INITIAL): PINK