IREDELL COUNTY HEALTH DEPARTMENT

STATESVILLE 704-878-5305 MOORESVILLE 704-664-5281

IMPROVEMENT PERMIT / AUTHORIZATION TO CONSTRUCT / OPERATION PERMIT / EXISTING SYSTEM INSPECTION

PERMIT# 121650 PIN# 4639-61-5956.088 4639-71-2294 DATE 11/28/06

OWNER OR APPLICANT Keepsake Homes - ~~Steve Wickersham~~ PHONE: Business _____ Home _____

ADDRESS _____

LOCATION Perth Rd(S) - Te Liva, Te Bay Crossing - On Rt

SUBDIVISION Bay Crossing BLOCK / SECTION 1 LOT 88 LOT AREA 1.81 Ac SITE CLASS. PS DESIGN FLOW 600 L.T.A.R. .5 gpd/Ft²

Septic Tank: 1500 Gallons; STB 338 Date 1-22-08
Pump Tank: 1500 Gallons; PT ~~338~~ 477 Date 1-14-08
Pump Make: Goulds THP Model WE10J2HV Serial No. WE10J2HV
Nitrification Field: No Fields 1 Square Feet 1008 Linear Feet 336
No Lines 4 Trench Width 24"/36" Max Trench Bottom Depth 36" Gravel Depth N/A ☐ Gravity ☐ Pressure

☐ New System ☐ Repair ☐ Expansion System Type: I II III IV V VI
System Description: L.P. PVC 05
Repair System Description: SAME
Maintenance Agreement Required: ☒ Yes ☐ No

☒ House/Mod. Home No. Bedrooms 3
☐ Mobile Home No. Persons 10
☐ Business No. Employees ____
☐ Other

Water Supply: ☒ Individual ☐ Public ☐ Community


☐ Slab ☒ Crawl Space ☐ Basement w/plumbing ☐ Basement wo/plumbing

Comments:/Conditions:
Lines = 8' minimum on center
Distribution through Central Valve Box (CVB)


Comments:/Conditions: 2/29/08 Tanks + lines cleaned AC
* See Attached for Pool

1"=100'

INITIAL SITE SKETCH

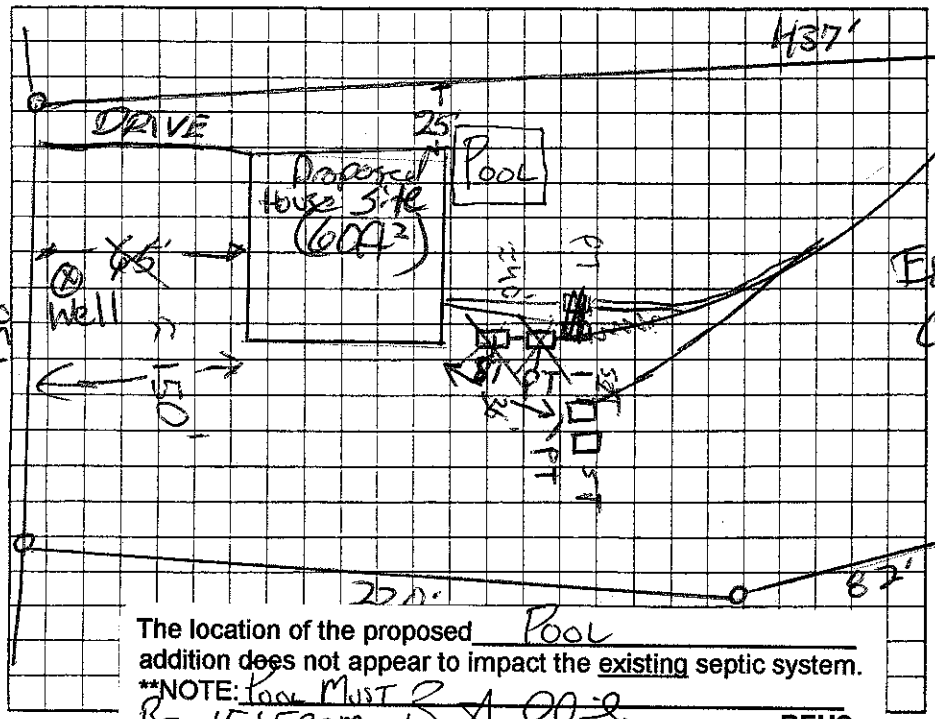

AS BUILT SKETCH

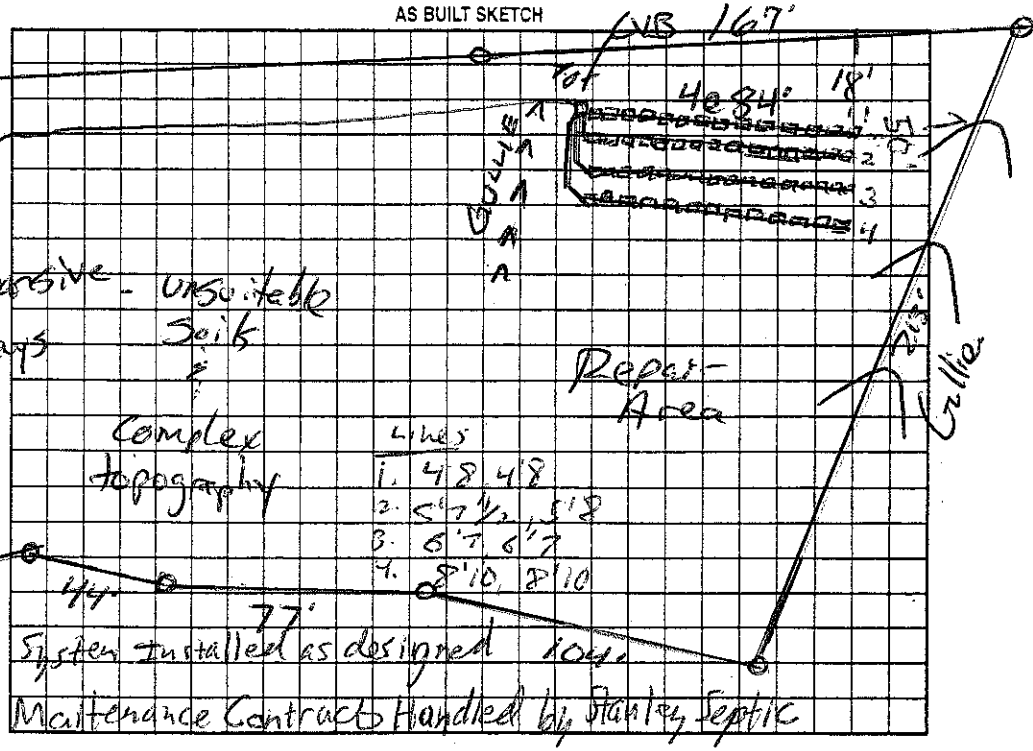

The location of the proposed Pool addition does not appear to impact the existing septic system.
**NOTE: Pool Must Be 15' From D-A 008 Septic
REHS
Date: 1-6-10
ICHD-Environmental Health Division

Permit can be
Permit with p

uthorized changes are made to the site/any unauthorized changes are made in the installation of the system. Improvement
☒ Authorization to Construct is valid for a period equal to that of Improvement Permit – not to exceed sixty months.

X Signed: _____ date _____

Installed by: Richard Abernathy

Improvement Permit by: _____ date 11/28/06

Operation Permit by: Anthony Cole' J R.S. date 7/17/08

Authorization to Construct by: Wesley Sparks R.S. date 11/9/07

Existing System Inspection by: _____ date _____

HEALTH DEPT. COPY: WHITE OWNER COPY (FINAL): YELLOW OWNER COPY (INITIAL): PINK