IREDELL COUNTY HEALTH DEPARTMENT

STATESVILLE 704-878-5305 MOORESVILLE 704-664-5281

IMPROVEMENT PERMIT / AUTHORIZATION TO CONSTRUCT / OPERATION PERMIT / EXISTING SYSTEM INSPECTION

PERMIT# 12200 PIN# 4639-~~41-5556.951~~ 71-2573 DATE 11/9/04

OWNER OR CONTRACTOR HECHT PROPERTIES/MARQUEE HOMES PHONE: Business 704-483-3651 Home

ADDRESS 885 (N) HWY-16 - DENVER NC 28037

LOCATION PERTH RD(S) - TR LIVA LN - TR BAYCROSSING - TR TEALIVE LN - ON RT

SUBDIVISION BAYCROSSING BLOCK / SECTION 1 LOT 81 LOT AREA .91AC SITE CLASS. PS DESIGN FLOW 480GPD L.T.A.R. .36 00/47

Septic Tank: 1000 Gallons; STB 1042 Date 12/8/04

Pump Tank: Gallons; PT Date

Pump Make: Model Serial No.

Nitrification Field: No Fields 1 Square Feet 1605 Linear Feet 535

No Lines 5@107 Trench Width 36" Max Trench Bottom Depth 36" Gravel Depth 12"

☑ New System ☐ Repair System Type: I (II) III, IV, V, VI

System Description: GRAVITY CONVENTIONAL

Repair System Description: GRAVITY 25% REDUCTION

Maintenance Agreement Required: ☐ Yes ☑ No

☑ House/Mod. Home No. Bedrooms 4

☐ Mobile Home No. Bathrooms 4

☐ Business No. Employees

☐ Other


☐ Slab ☑ Crawl Space ☐ Basement w/plumbing ☐ Basement wo/plumbing

Water Supply: ☑ Individual ☐ Public ☐ Community


Comments:/Conditions:

Comments:/Conditions:

INITIAL SITE SKETCH 1"=50'

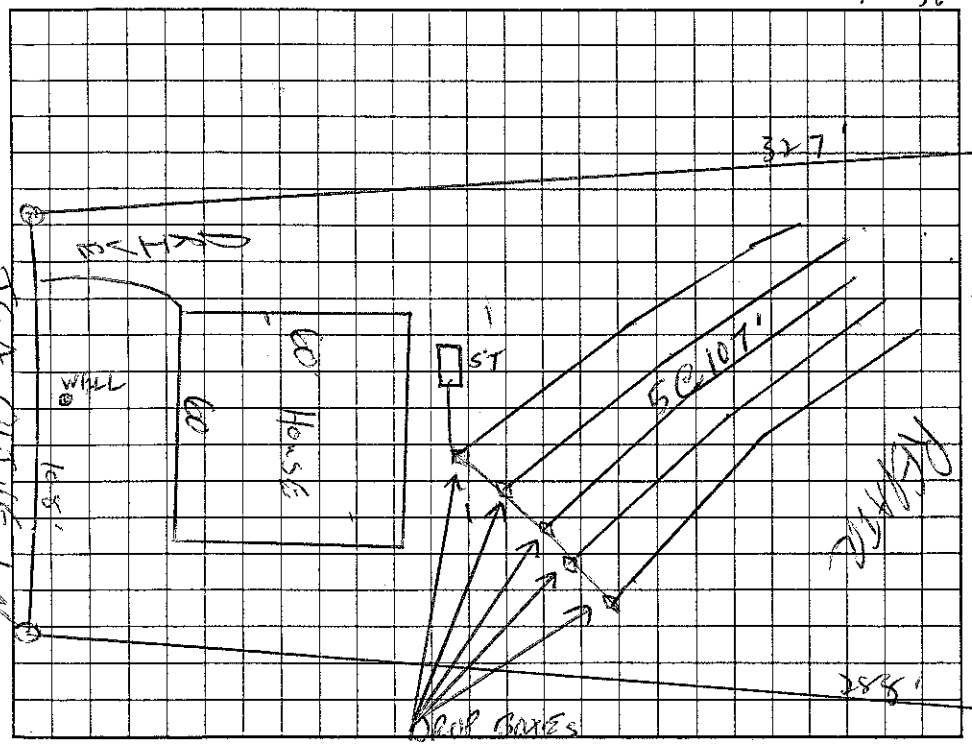

AS BUILT SKETCH

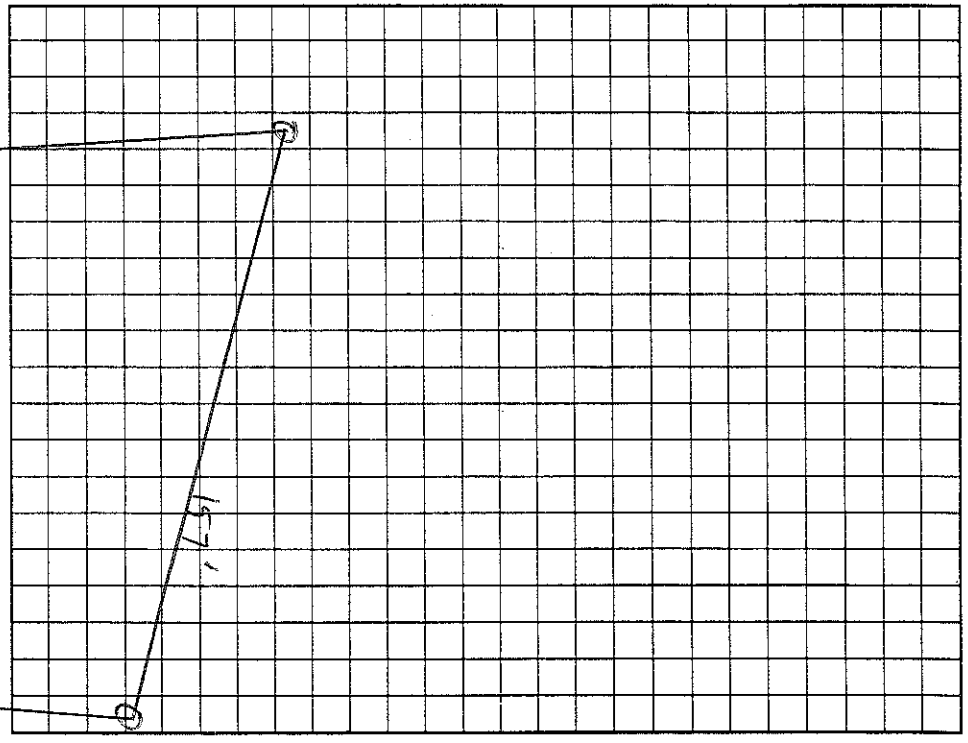

Permit can be suspended or revoked if any false information is supplied toward securing the permit/any unauthorized changes are made to the site/any unauthorized changes are made in the installation of the system. Improvement Permit with plat valid without expiration. Improvement Permit with site plan valid for sixty months. Authorization to Construct is valid for a period equal to that of Improvement Permit – not to exceed sixty months.

Signed: date 11-22-04 Installed by: Piedmont Backhoe Service

Improvement Permit by: RS date 11/9/04 Operation Permit by: Wesley Sparks RS. date 6/15/05

Authorization to Construct by: RS date 1/21/05 Existing System Inspection by: date

HEALTH DEPT. COPY: WHITE OWNER COPY (FINAL): YELLOW OWNER COPY (INITIAL): PINK