IREDELL COUNTY HEALTH DEPARTMENT

STATESVILLE 704-878-5305 MOORESVILLE 704-6[illegible]

IMPROVEMENT PERMIT / AUTHORIZATION TO CONSTRUCT / OPERATION PERMIT / EXISTING SYSTEM INSPECTION

PERMIT# 122175 PIN# 4639615556.000 4639-71-2859 DATE 11/8/04

OWNER OR CONTRACTOR Heaht Properties / EFP As PHONE: Business 483-3651 Home

ADDRESS 585 North Highway 16 / Denver NC 28037

LOCATION Perth Rd south TR Liva Ln - TR BAY CROSSING TR TEA OLIVE - ON LT

SUBDIVISION Bay Crossing BLOCK / SECTION 1 LOT 68 LOT AREA .71AC SITE CLASS PS DESIGN FLOW 480gpd L.T.A.R. .36-10/Kg

Septic Tank: 1500 ~~1000~~ Gallons; STB 338 Date 3/29/05

Pump Tank: 1000 Gallons; PT 27 Date 11/16/04

Pump Make: Goulds Model WE0312M Serial No.

Nitrification Field: No Fields 1 Square Feet 540 Linear Feet 270

No Lines 3@90' Trench Width 24" Max Trench Bottom Depth 36" Gravel Depth N/A

☒ New System ☐ Repair System Type: I, II, III, (IV), V, VI

System Description: LP PANEL

Repair System Description: SAME

Maintenance Agreement Required: ☐ ~~Yes~~ ☐ No

☒ House/Mod. Home No. Bedrooms 4

☐ Mobile Home No. Bathrooms 4

☐ Business No. Employees

☐ Other


☐ Slab ☐ Crawl Space ☐ Basement w/plumbing ☐ Basement wo/plumbing

Water Supply: ☒ Individual ☐ Public ☐ Community


Comments:/Conditions: Reviewed Building plans & site plans 12/6/04, in Compliance with original permit

Comments:/Conditions: Tanks & lines checked by Sam 5/4/05 Pressure checked by MD 5/19/05

INITIAL SITE SKETCH 1"=50'

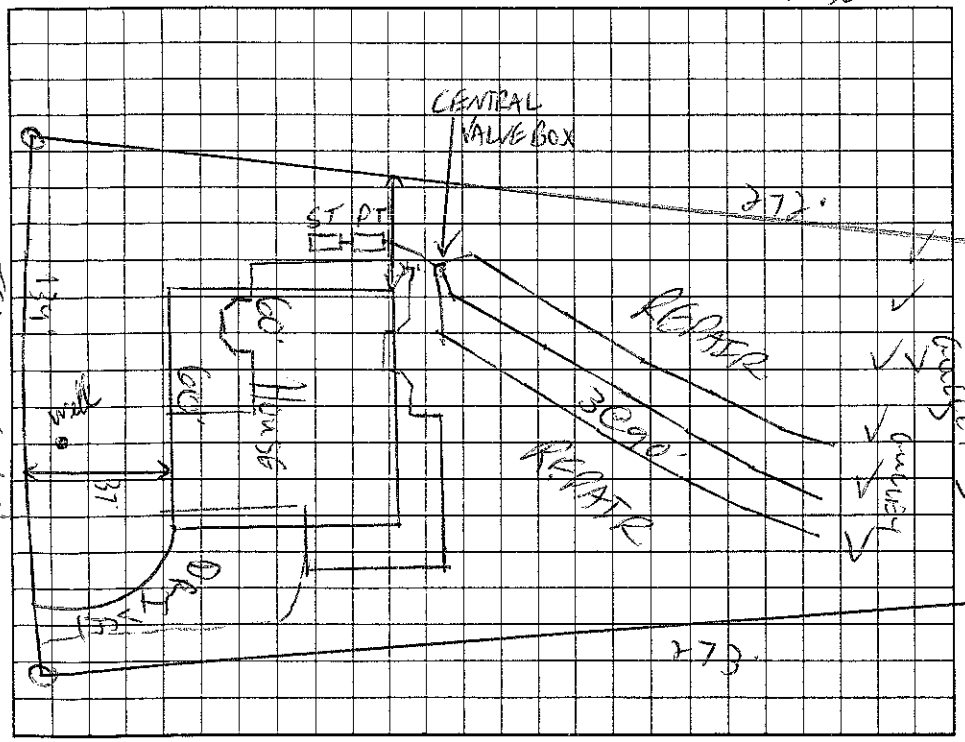

AS BUILT SKETCH

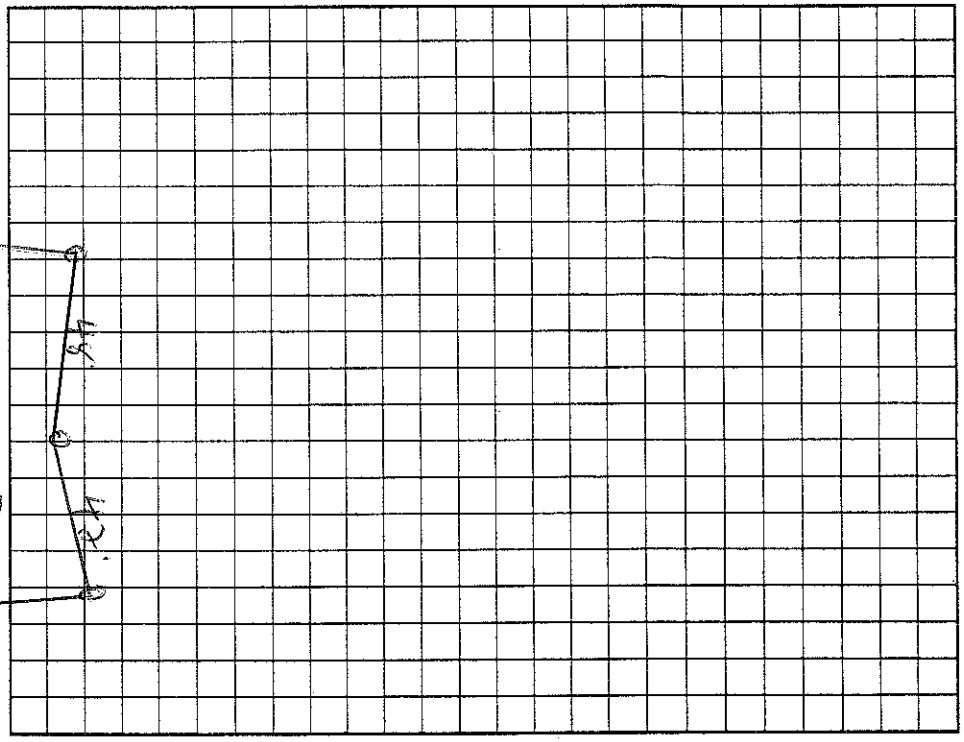

Permit can be suspended or revoked if any false information is supplied toward securing the permit/any unauthorized changes are made to the site/any unauthorized changes are made in the installation of the system. Improvement Permit with plat valid without expiration. Improvement Permit with site plan valid for sixty months. Authorization to Construct is valid for a period equal to that of Improvement Permit – not to exceed sixty months.

Signed: [signature] date 11-22-04 Installed by: Richard Abernathy

Improvement Permit by: [signature] RS date 11/8/04 Operation Permit by: [signature] RS date 5/20/05

Authorization to Construct by: [signature] RS date 12/6/04 Existing System Inspection by: date

HEALTH DEPT. COPY: WHITE OWNER COPY (FINAL): YELLOW OWNER COPY (INITIAL): PINK