IREDELL COUNTY HEALTH DEPARTMENT

STATESVILLE 704-878-5305 MOORESVILLE 704-664-5281

IMPROVEMENT PERMIT / AUTHORIZATION TO CONSTRUCT / OPERATION PERMIT / EXISTING SYSTEM INSPECTION

PERMIT# 122176 PIN# 4639616555 6 Cell 4639-71-3866 DATE 11-17-05

OWNER OR APPLICANT Broermann Homes Inc PHONE: Business 340-7787 Home 799-2033

ADDRESS 119 Kiskadee Dr Mooresville NC 28117

LOCATION Perth Rd North TL Liva Ln TR Bay Crossing TR Tea Olive on left

SUBDIVISION Bay Crossing BLOCK / SECTION 1 LOT 69 LOT AREA .78 Acre SITE CLASS. PS DESIGN FLOW 480gpd L.T.A.R. .3

Septic Tank: 1000+ Gallons; STB 17214 Date 4-17-04

Pump Tank: 1000 Gallons; PT 2813 Date 6-24-06

Pump Make: Geolds Model WE-03dm Serial No.

Nitrification Field; No Fields 1 Square Feet 540' Linear Feet 270'

No Lines 4 Trench Width 24" Max Trench Bottom Depth 36" Gravel Depth N/A

☒ New System ☐ Repair ☐ Expansion System Type: I II III IV V VI

System Description: Pump-LP-Panel Block

Repair System Description: Same

Maintenance Agreement Required: ☒ Yes ☐ No

☒ House/Mod. Home ☐ Mobile Home ☐ Business ☐ Other

No. Bedrooms 4 No. Persons ___ No. Employees ___

Water Supply: ☒ Individual ☐ Public ☐ Community


☐ Gravity ☒ Pressure ☐ Slab ☒ Crawl Space ☐ Basement w/plumbing ☐ Basement wo/plumbing

Comments:/Conditions: Clean Gullies & "properly fill" with debris free PS soil
Keep Drainfield 15' from Future pool area & gullies & 10' from PL

Comments:/Conditions: * See Subdivision Specs regarding Installation of Septic Systems
Checked tanks & lines 7/28/06

Scale 1":50'

INITIAL SITE SKETCH

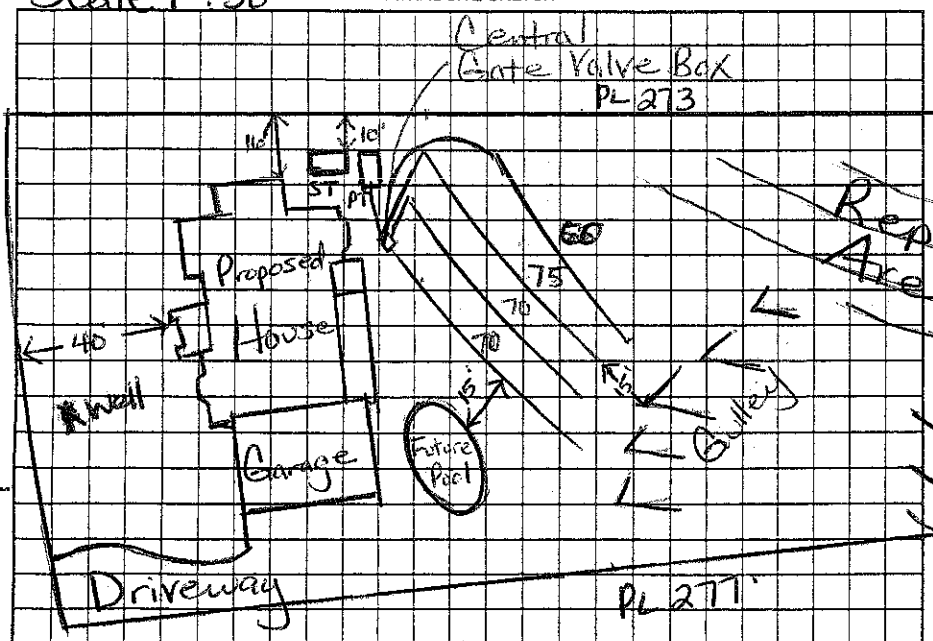

AS BUILT SKETCH

Permit can be suspended or revoked if any false information is supplied toward securing the permit/any unauthorized changes are made to the site/any unauthorized changes are made in the installation of the system. Improvement Permit with plat valid without expiration ☒ Improvement Permit with site plan valid for sixty months ☐ Authorization to Construct is valid for a period equal to that of Improvement Permit – not to exceed sixty months.

Signed: Dan Broermann date 11-18-05 Installed by: Richard Abernathy

Improvement Permit by: Maria H. Tolson RS date 11/17/05 Operation Permit by: Maria H. Tolson RS date 10/17/06

Authorization to Construct by: Maria H. Tolson RS date 11/17/05 Existing System Inspection by: ___ date ___

HEALTH DEPT. COPY: WHITE OWNER COPY (FINAL): YELLOW OWNER COPY (INITIAL): PINK