IREDELL COUNTY HEALTH DEPARTMENT

STATESVILLE 704-878-5305 MOORESVILLE 704-664-5281

IMPROVEMENT PERMIT / AUTHORIZATION TO CONSTRUCT / OPERATION PERMIT / EXISTING SYSTEM INSPECTION

PERMIT# 12177 PIN# 4639615556.070 DATE 11/8/04

OWNER OR CONTRACTOR Heckt Properties / STONEHAVEN HOMES PHONE: Business 704 483-3651 Home

ADDRESS 885 North Highway 16 Denver, NC 28037

LOCATION Perth Rd south TR) Liva Ln

SUBDIVISION Bay Crossing BLOCK / SECTION 1 LOT 70 LOT AREA .74 SITE CLASS PS DESIGN FLOW 480gpd L.T.A.R. .36 PO Kfs

Septic Tank: 1500 ~~1000~~ Gallons; STB 338 Date 1/6/06

Pump Tank: Gallons; PT Date

Pump Make: Model Serial No.

Nitrification Field: No Fields 1 Square Feet 1200 Linear Feet 400

No. Lines 4@100' Trench Width 36" Max Trench Bottom Depth 36" Gravel Depth N/A

☒ New System ☐ Repair System Type: I, II, (III) IV, V, VI

System Description: GRAVITY 25% REDUCTION

Repair System Description: LP TANK

Maintenance Agreement Required: ☐ Yes ☒ No

☒ House/Mod. Home ☐ Mobile Home ☐ Business ☐ Other

No. Bedrooms 4 No. Bathrooms 4 No. Employees


☐ Slab ☒ Crawl Space ☐ Basement w/plumbing ☐ Basement wo/plumbing

Water Supply: ☒ Individual ☐ Public ☐ Community


Comments:/Conditions:

Comments:/Conditions: Drop Boxes, Tank Location shown.

INITIAL SITE SKETCH 1"=50'

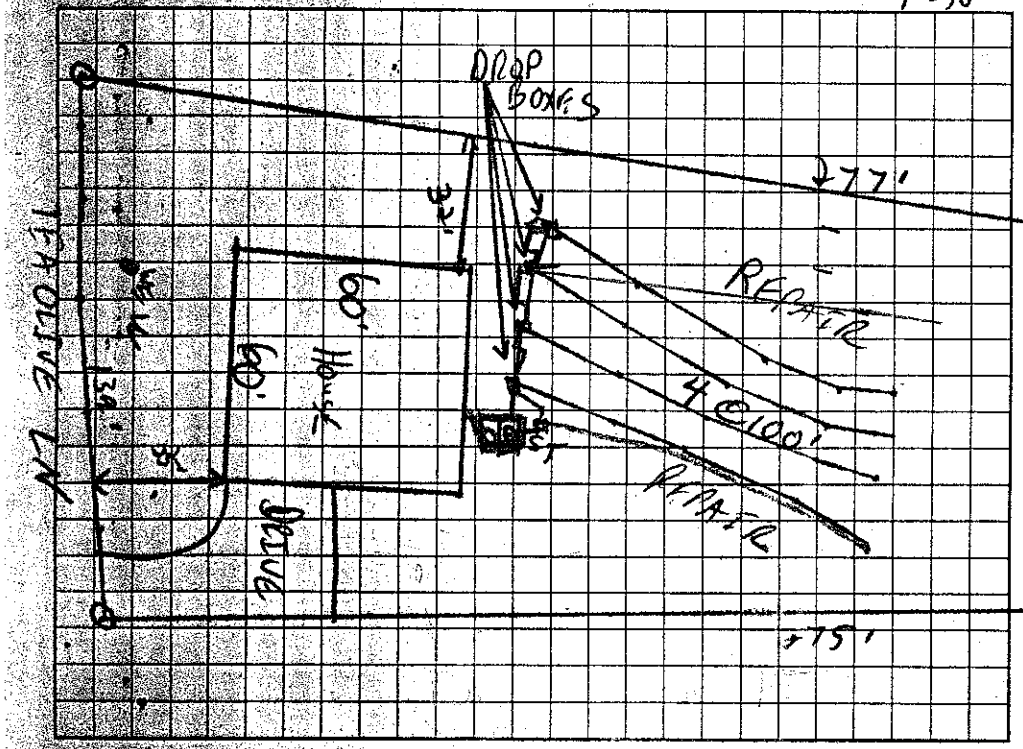

AS BUILT SKETCH

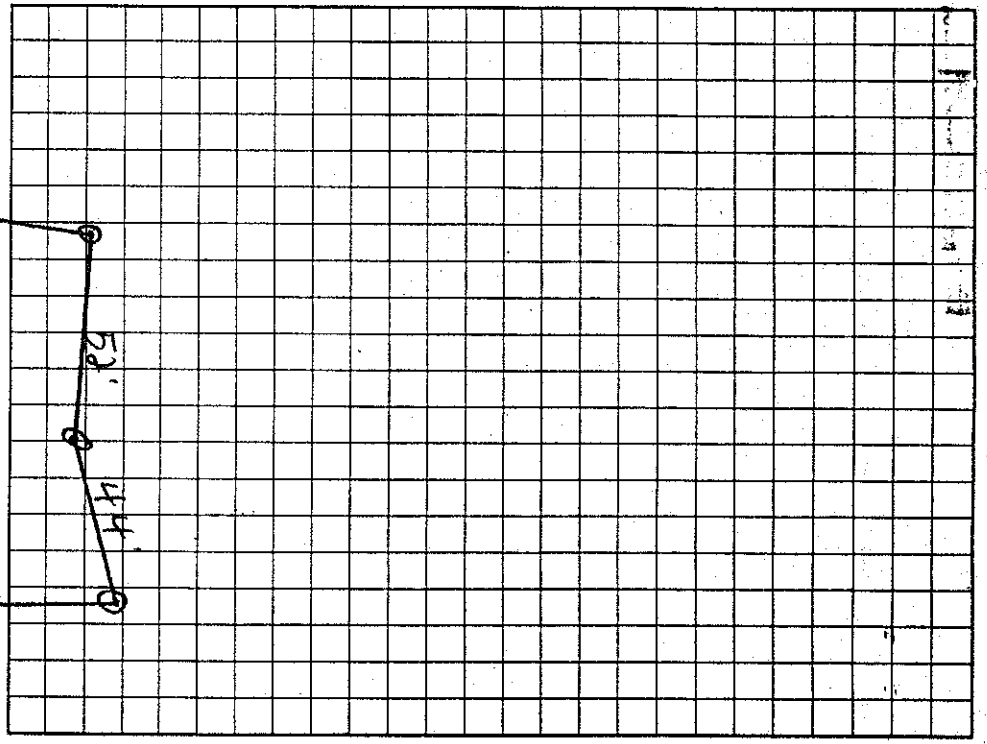

Permit can be suspended or revoked if any false information is supplied toward securing the permit/any unauthorized changes are made to the site/any unauthorized changes are made in the installation of the system. Improvement Permit with plot valid without expiration. Improvement Permit with site plan valid for sixty months. Authorization to Construct is valid for a period equal to that of Improvement Permit – not to exceed sixty months.

Signed: date 11-22-04 Installed by: Larry Brian Shadrick

Improvement Permit by: C. [illegible] RS date 11/8/04 Operation Permit by: Wesley Sparks RS. date 2/9/06

Authorization to Construct by: Wesley Sparks RS. date 8/19/05 Existing System Inspection by: date

HEALTH DEPT. COPY: WHITE OWNER COPY (FINAL): YELLOW OWNER COPY (INITIAL): PINK