IREDELL COUNTY HEALTH DEPARTMENT

STATESVILLE 704-878-5305 MOORESVILLE 704-664-5281

IMPROVEMENT PERMIT / AUTHORIZATION TO CONSTRUCT / OPERATION PERMIT / EXISTING SYSTEM INSPECTION

PERMIT# 122179 PIN# 4639-61-5556 ~~6880~~ 71-5886 DATE 11/8/07

OWNER OR CONTRACTOR Hecht Properties PHONE: Business 704 483-3651 Home

ADDRESS 885 North Highway 16 Denver, NC 28037

LOCATION Perth Rd south TR Liva Ln - TR BAY CROSSING - TR TEA OLIVE - ON LT

SUBDIVISION Bay Crossing BLOCK / SECTION 1 LOT 71 LOT AREA .684c SITE CLASS. PS DESIGN FLOW 480gpd L.T.A.R. .36 50/FT2

Septic Tank: ~~1500~~ 1000 Gallons: STB 338 Date 3/21/07

Pump Tank: Gallons: PT Date

Pump Make: Model Serial No.

Nitrification Field: No Fields 1 Square Feet 1200 Linear Feet 400

No Lines ~~3 @ 133'~~ Trench Width 36" Max Trench Bottom Depth 36" Gravel Depth N/A

☒ New System ☐ Repair System Type: I, II, III, IV, V, VI

System Description: GRAVITY 25% REDUCTION

Repair System Description: GRAV. / PUMP SAME

Maintenance Agreement Required: ☐ Yes ☑ No

☒ House/Mod. Home No. Bedrooms 4

☐ Mobile Home No. Bathrooms 4

☐ Business No. Employees

☐ Other

☐ Slab ☑ Crawl Space ☐ Basement w/plumbing ☐ Basement wo/plumbing


Water Supply: ☒ Individual ☐ Public ☐ Community

Comments:/Conditions:


Aws 4@100'K3' 25% Reduced Drainfield Area

Comments:/Conditions:

INITIAL SITE SKETCH 1"=50'

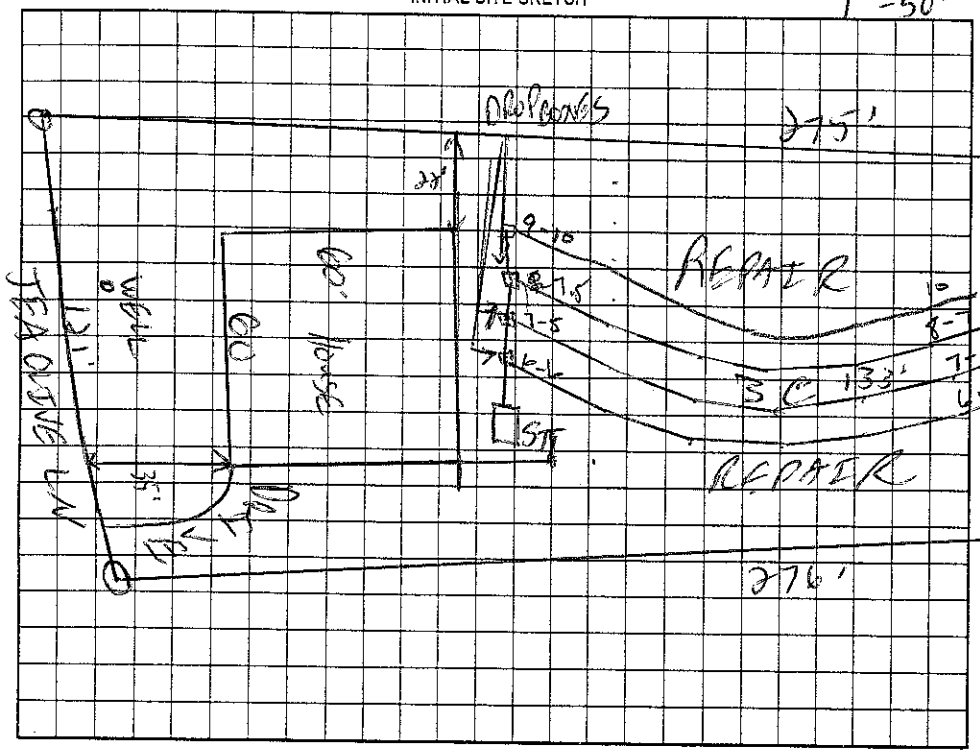

AS BUILT SKETCH

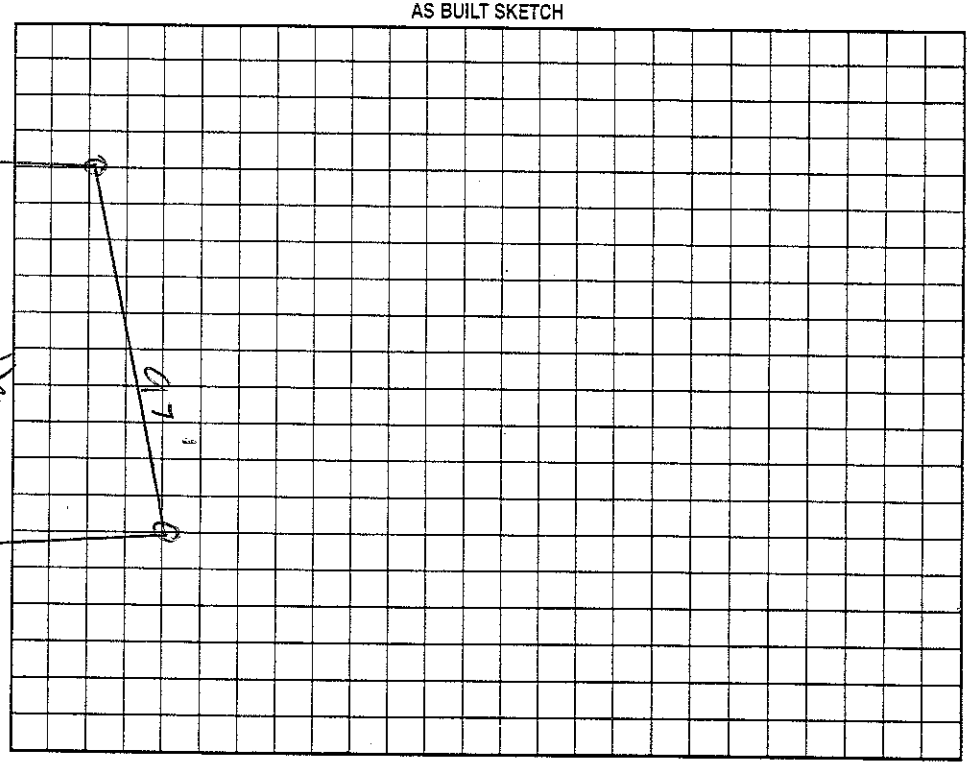

Permit can be suspended or revoked if any false information is supplied toward securing the permit/any unauthorized changes are made to the site/any unauthorized changes are made in the installation of the system. Improvement Permit with plat valid without expiration. Improvement Permit with site plan valid for sixty months. Authorization to Construct is valid for a period equal to that of Improvement Permit – not to exceed sixty months.

Signed: date 11-22-07 Installed by:

Improvement Permit by: RS date 11/8/07 Operation Permit by: Wesley Sparks RS date 3/26/07

Authorization to Construct by: Wesley Sparks RS date 8/10/06 Existing System Inspection by: date

HEALTH DEPT. COPY: WHITE OWNER COPY (FINAL): YELLOW OWNER COPY (INITIAL): PINK