IREDELL COUNTY HEALTH DEPARTMENT - *ENVIRONMENTAL HEALTH* ☐ STATESVILLE OFFICE 704-878-5305 ☑ MOORESVILLE OFFICE 704-664-5281 4:00 pm

IMPROVEMENT PERMIT / AUTHORIZATION TO CONSTRUCT / OPERATION PERMIT / EXISTING SYSTEM INSPECTION

PERMIT # 122198 11009 PIN # 4639-71-6404 DATE 10-13-11

OWNER JEFFREY SACHS APPLICANT: SAME PHONE: Home/Cell # 980-223-9489 Business # 630-803-0834

SITE ADDRESS 134 TEA OLIVE LN. OWNER / APPLICANT ADDRESS 123 MORROCROFT LN.

SITE DIRECTIONS PERTH, TL LIVA, TR INTO BAY CROSSING, TR TEA OLIVE

SUBDIVISION BAY CROSSING BLOCK / SECTION 1 LOT # 79 LOT AREA 1.56 AC DESIGN FLOW 600 L.T.A.R. .3

Septic Tank ~~1500~~ Gallons: STB 444 Date 6-30-12

Pump Tank Gallons: P T Date

Pump Make Model Serial #

No. Nitrification Fields: 1 No. Lines 7 Linear Feet 504'

Trench Width 36" Max. Trench Bottom Depth 36"

☑ New System ☐ Repair ☐ Expansion System Type I II III IV V VI

System Description: 25% REDUCTION

Repair System Description: 50% REDUCTION

Maintenance Agreement Required ☐ YES ☑ NO INITIALLY

Gravel Depth — ☑ GRAVITY ☐ PRESSURE

☑ Residence No. Bedrooms 5

☐ Business No. Persons

☐ Other No. Employees


☐ Slab ☐ Crawl Space

☑ Basement w/plumbing ☐ Basement w/o plumbing


Water Supply: ☑ Private ☐ Public ☐ Community

Comments / Conditions ① KEEP SYSTEM MIN. 10' FROM BASEMENT

INITIAL SITE SKETCH

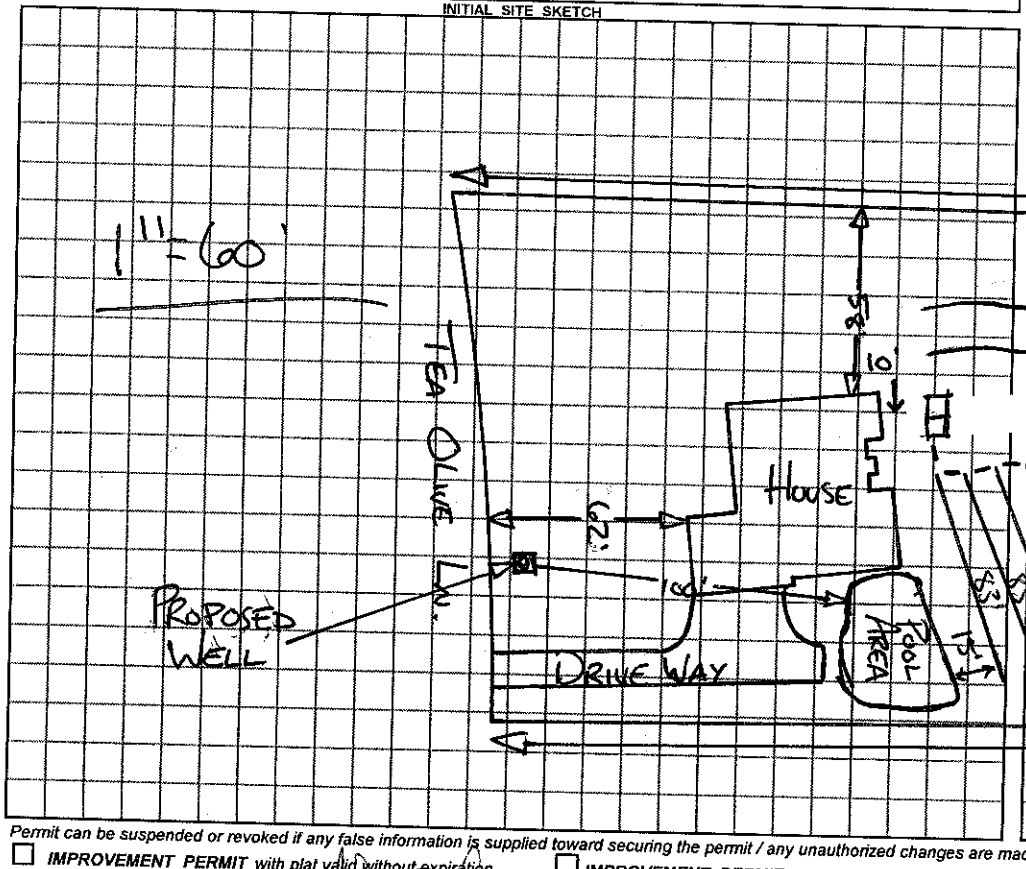

AS BUILT SKETCH

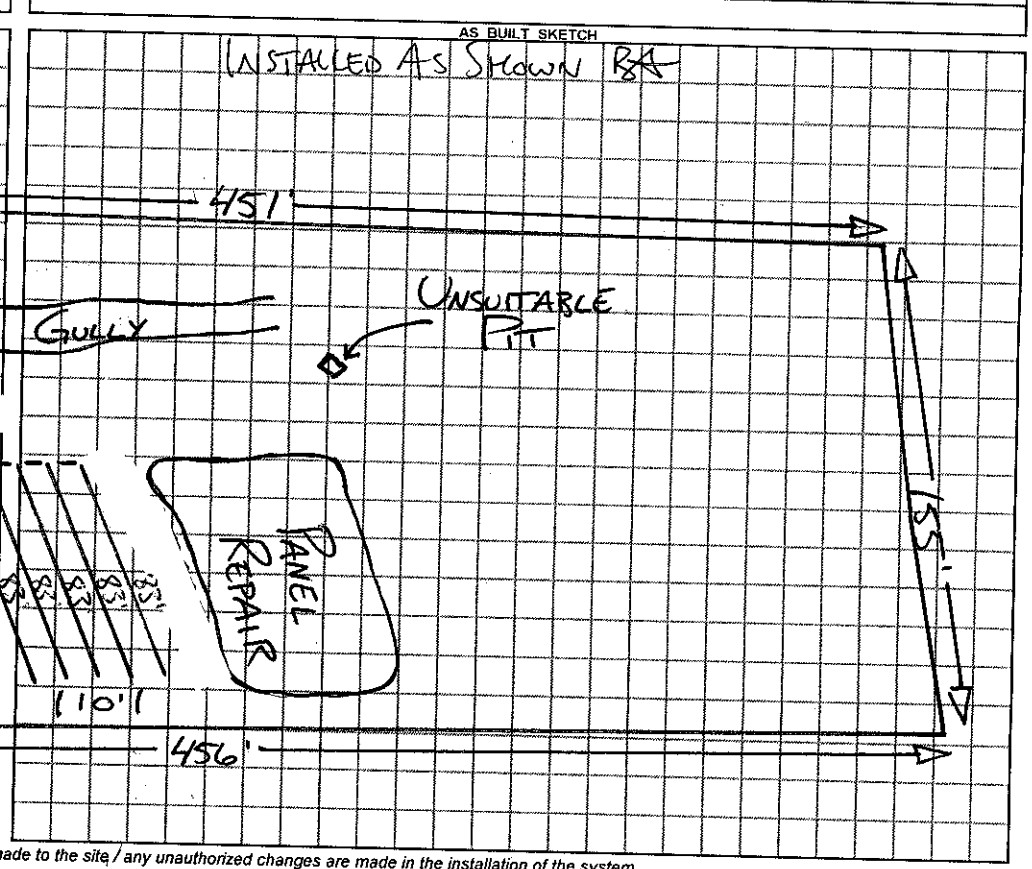

Permit can be suspended or revoked if any false information is supplied toward securing the permit / any unauthorized changes are made to the site / any unauthorized changes are made in the installation of the system.

☐ ***IMPROVEMENT PERMIT*** with plat valid without expiration. ☐ ***IMPROVEMENT PERMIT*** with ~~plat valid without expiration~~ site plan valid 60 mo. ☑ ***AUTHORIZATION TO CONSTRUCT*** valid for period equal to IMPROVEMENT PERMIT--not to exceed 60 mo.

Owner / Applicant Signature: Date

IMPROVEMENT PERMIT by: REHS Date 10-13-11

AUTHORIZATION TO CONSTRUCT by: REHS Date 10-13-11

YOU SHOULD CONTACT A LOCATOR SERVICE PRIOR TO ANY EXCAVATION

Installed by: GROUND BREAKERS

OPERATION PERMIT by: REHS Date 8-7-12

Existing System Inspected by: REHS Date

White Copy – Environmental Health YELLOW COPY (Final) Owner / Applicant PINK COPY (Initial) Owner / Applicant