IREDELL COUNTY HEALTH DEPARTMENT

STATESVILLE 704-878-5305 MOORESVILLE 704-664-5281

IMPROVEMENT PERMIT / AUTHORIZATION TO CONSTRUCT / OPERATION PERMIT / EXISTING SYSTEM INSPECTION

PERMIT# 121495 PIN# 4639-61-9556.116 DATE 11/12/04

OWNER OR CONTRACTOR HEWITT PROPERTIES PHONE: Business 483-3651 Home

ADDRESS 885 (N) Hwy 16 DENVER NC 28037

LOCATION PERTH (N) - TL LIVA LN - TL BAYCROSSING - TR SUMMERWIND - ON LT

SUBDIVISION BAYCROSSING BLOCK / SECTION 1 LOT 116 LOT AREA 4.54AC SITE CLASS PS DESIGN FLOW 480GPD L.T.A.R. .30-10/FT²

Septic Tank: 1000 Gallons; STB Date

Pump Tank: Gallons; PT Date

Pump Make: Model Serial No.

Nitrification Field: No Fields 1 Square Feet 1000 Linear Feet 400

No Lines 4@100' Trench Width 36" Max Trench Bottom Depth 36" Gravel Depth N/A

☑ New System ☐ Repair System Type: I, II, (III), IV, V, VI

System Description: GRAVITY 35% REDUCTION

Repair System Description: TURF 25% REDUCTION

Maintenance Agreement Required: ☐ Yes ☑ No

☑ House/Mod. Home ☐ Mobile Home ☐ Business ☐ Other


No. Bedrooms 4 No. Bathrooms 4 No. Employees

☐ Slab ☑ Crawl Space ☐ Basement w/plumbing ☐ Basement wo/plumbing

Water Supply: ☑ Individual ☐ Public ☐ Community


Comments:/Conditions: 1"=50'

INITIAL SITE SKETCH

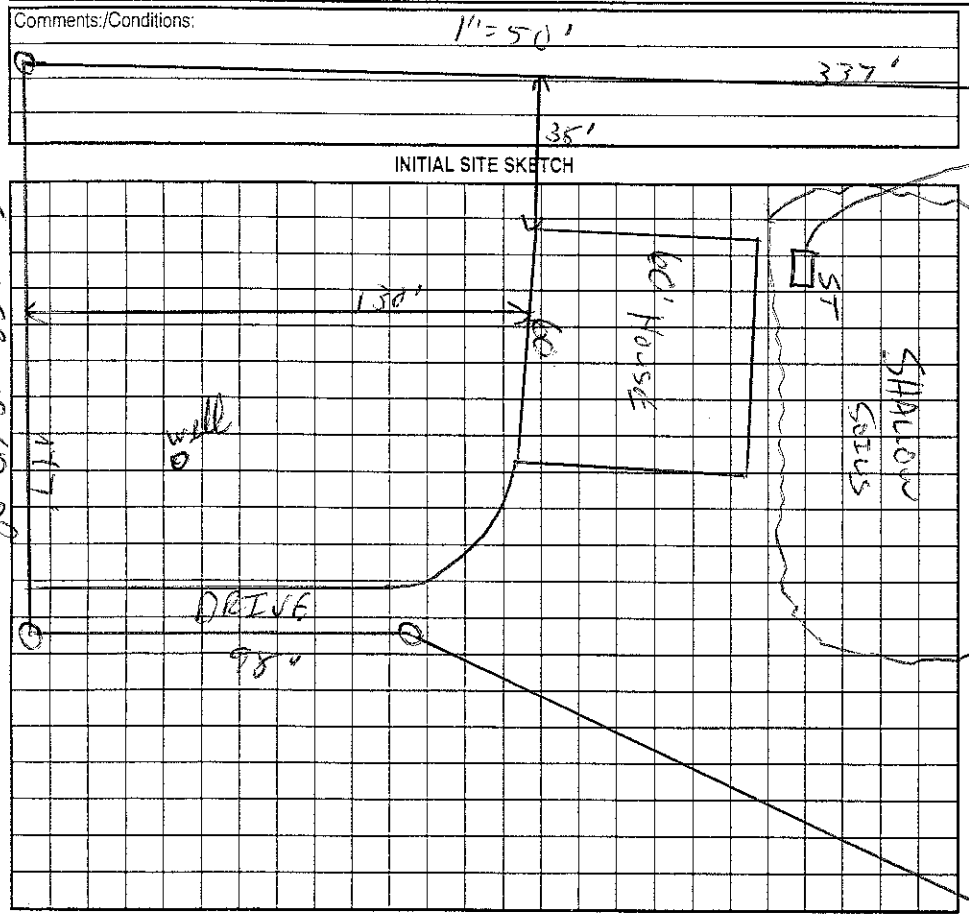

Comments:/Conditions: DROP BOXES SEE ATTACHED PLAT FOR REPAIR AREA IN VERY BACK

AS BUILT SKETCH

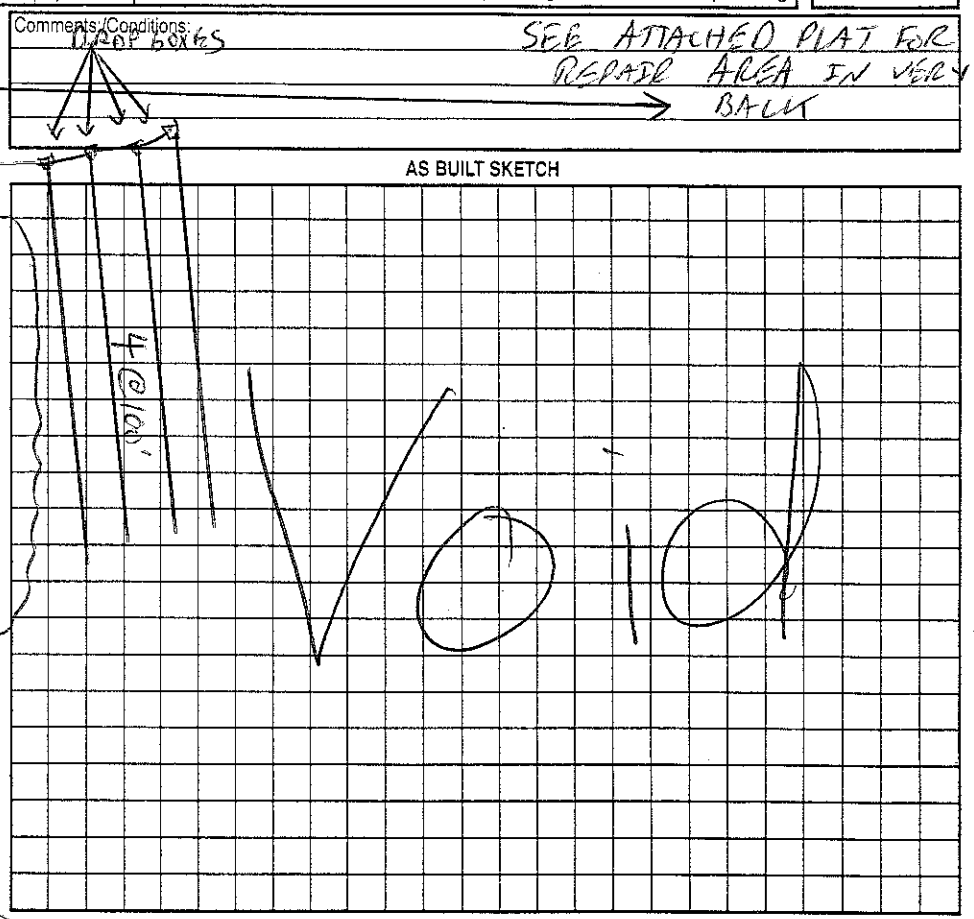

Permit can be suspended or revoked if any false information is supplied toward securing the permit/any unauthorized changes are made to the site/any unauthorized changes are made in the installation of the system. Improvement Permit with plat valid without expiration. Improvement Permit with site plan valid for sixty months. Authorization to Construct is valid for a period equal to that of Improvement Permit – not to exceed sixty months.

Signed: [signature] date 11-22-04 Installed by:

Improvement Permit by: [signature] date 11/12/04 Operation Permit by: date

Authorization to Construct by: date Existing System Inspection by: date

HEALTH DEPT. COPY: WHITE OWNER COPY (FINAL): YELLOW OWNER COPY (INITIAL): PINK