375

IREDELL COUNTY HEALTH DEPARTMENT

STATESVILLE 704-878-5305 MOORESVILLE 704-664-5281

IMPROVEMENT PERMIT / AUTHORIZATION TO CONSTRUCT / OPERATION PERMIT / EXISTING SYSTEM INSPECTION

PERMIT# 25289 PIN# 4639-61-5556.051 4639-62-0765 DATE June 10, 05

OWNER OR CONTRACTOR Heath Prop. Inc - DREAMWORKS ENT. PHONE: Business Home

ADDRESS 885 (N) Hwy 16 Denver, N.C. 28037

LOCATION [redacted] Perth Rd (N.) TL Liva Lane TR Bay Crossing TL 2nd Bayshore on right

SUBDIVISION Bay Crossing BLOCK / SECTION 2 LOT 51 / 51A LOT AREA .71ac + 17,371sqft SITE CLASS. BSSFES1A DESIGN FLOW 400gpd L.T.A.R. .25 SFES1A

Septic Tank: ~~1000~~ 1500 Gallons; STB 528 Date 7-21-06

Pump Tank: 1000 Gallons; PT 77 Date 7-20-06

Pump Make: Crosslimbs Model ~~Wilco-10/72/1444~~ No. A07582-73

Nitrification Field: No Fields 1 Square Feet 640/960 Linear Feet 320

No Lines 4@80+ Trench Width 24" min 8'cc Max Trench Bottom Depth 36" Gravel Depth N/A

☒ New System ☐ Repair System Type: I, II, III, (IV), V, VI

System Description: LPPPBPS on 51A

Repair System Description: LPPPBPS on 51A

Maintenance Agreement Required: ☒ Yes ☐ No

☒ House/Mod. Home No. Bedrooms 4

☐ Mobile Home No. Bathrooms

☐ Business No. Employees

☐ Other

☐ Slab ☐ Crawl Space ☒ Basement w/plumbing ☐ Basement wo/plumbing

Water Supply: ☒ Individual ☐ Public ☐ Community

Comments:/Conditions: of 36" max 9'cc

Sleeve under driveway as appropriate for supply line


Comments:/Conditions: Filter on ST & PT checked 11/29/06

3/16" holes

Maintenance by Ste-Ly Septic Service

INITIAL SITE SKETCH

1"=100'

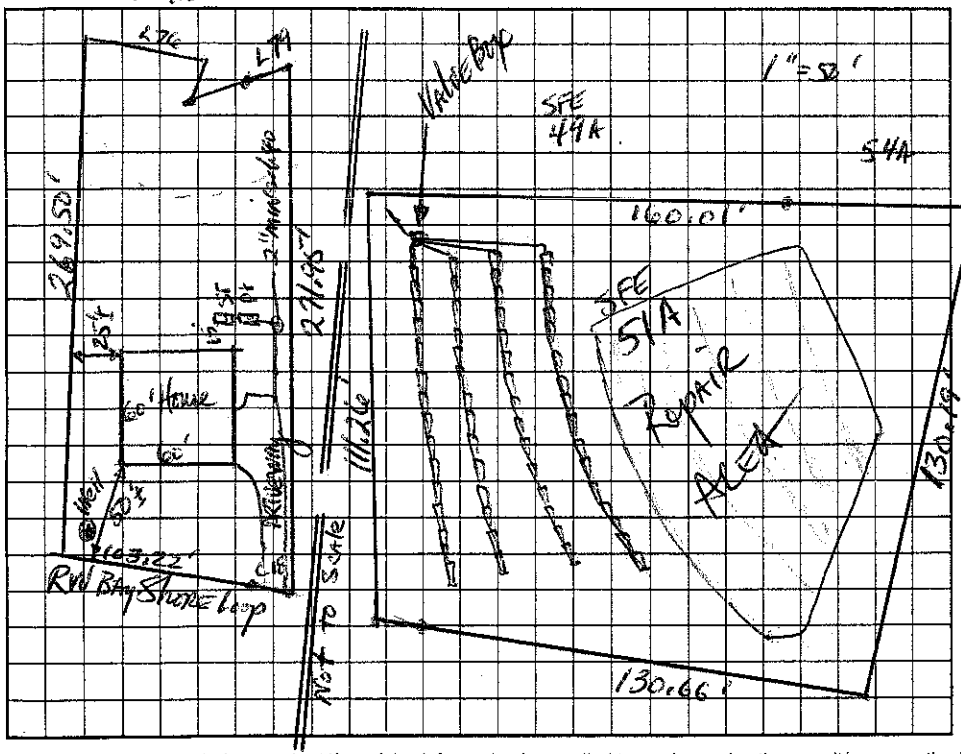

AS BUILT SKETCH

1"=50'

The location of the proposed Sun Room addition does not appear to impact the existing septic system.

**NOTE: OVER EXISTING DECK

REHS

Date: 3-8-11

ICHD-Environmental Health Division

Permit can be suspended or revoked if any false information is supplied toward securing the permit/any unauthorized changes are made to the site/any unauthorized changes are made in the installation of the system. Improvement Permit with plat valid without expiration. Improvement Permit with site plan valid for sixty months. Authorization to Construct is valid for a period equal to that of Improvement Permit – not to exceed sixty months.

Signed: date 6/17/05

Improvement Permit by: date 6-10-05

Authorization to Construct by: Wesley Sparkes RS. date 4/13/06

Installed by: Steve Jacobs / Piedmont

Operation Permit by: Wesley Sparkes RS. date 2-9-07

Existing System Inspection by: date

HEALTH DEPT. COPY: WHITE OWNER COPY (FINAL): YELLOW OWNER COPY (INITIAL): PINK